


Map

T14S, R10W, Sec. 25, 26, W.M.

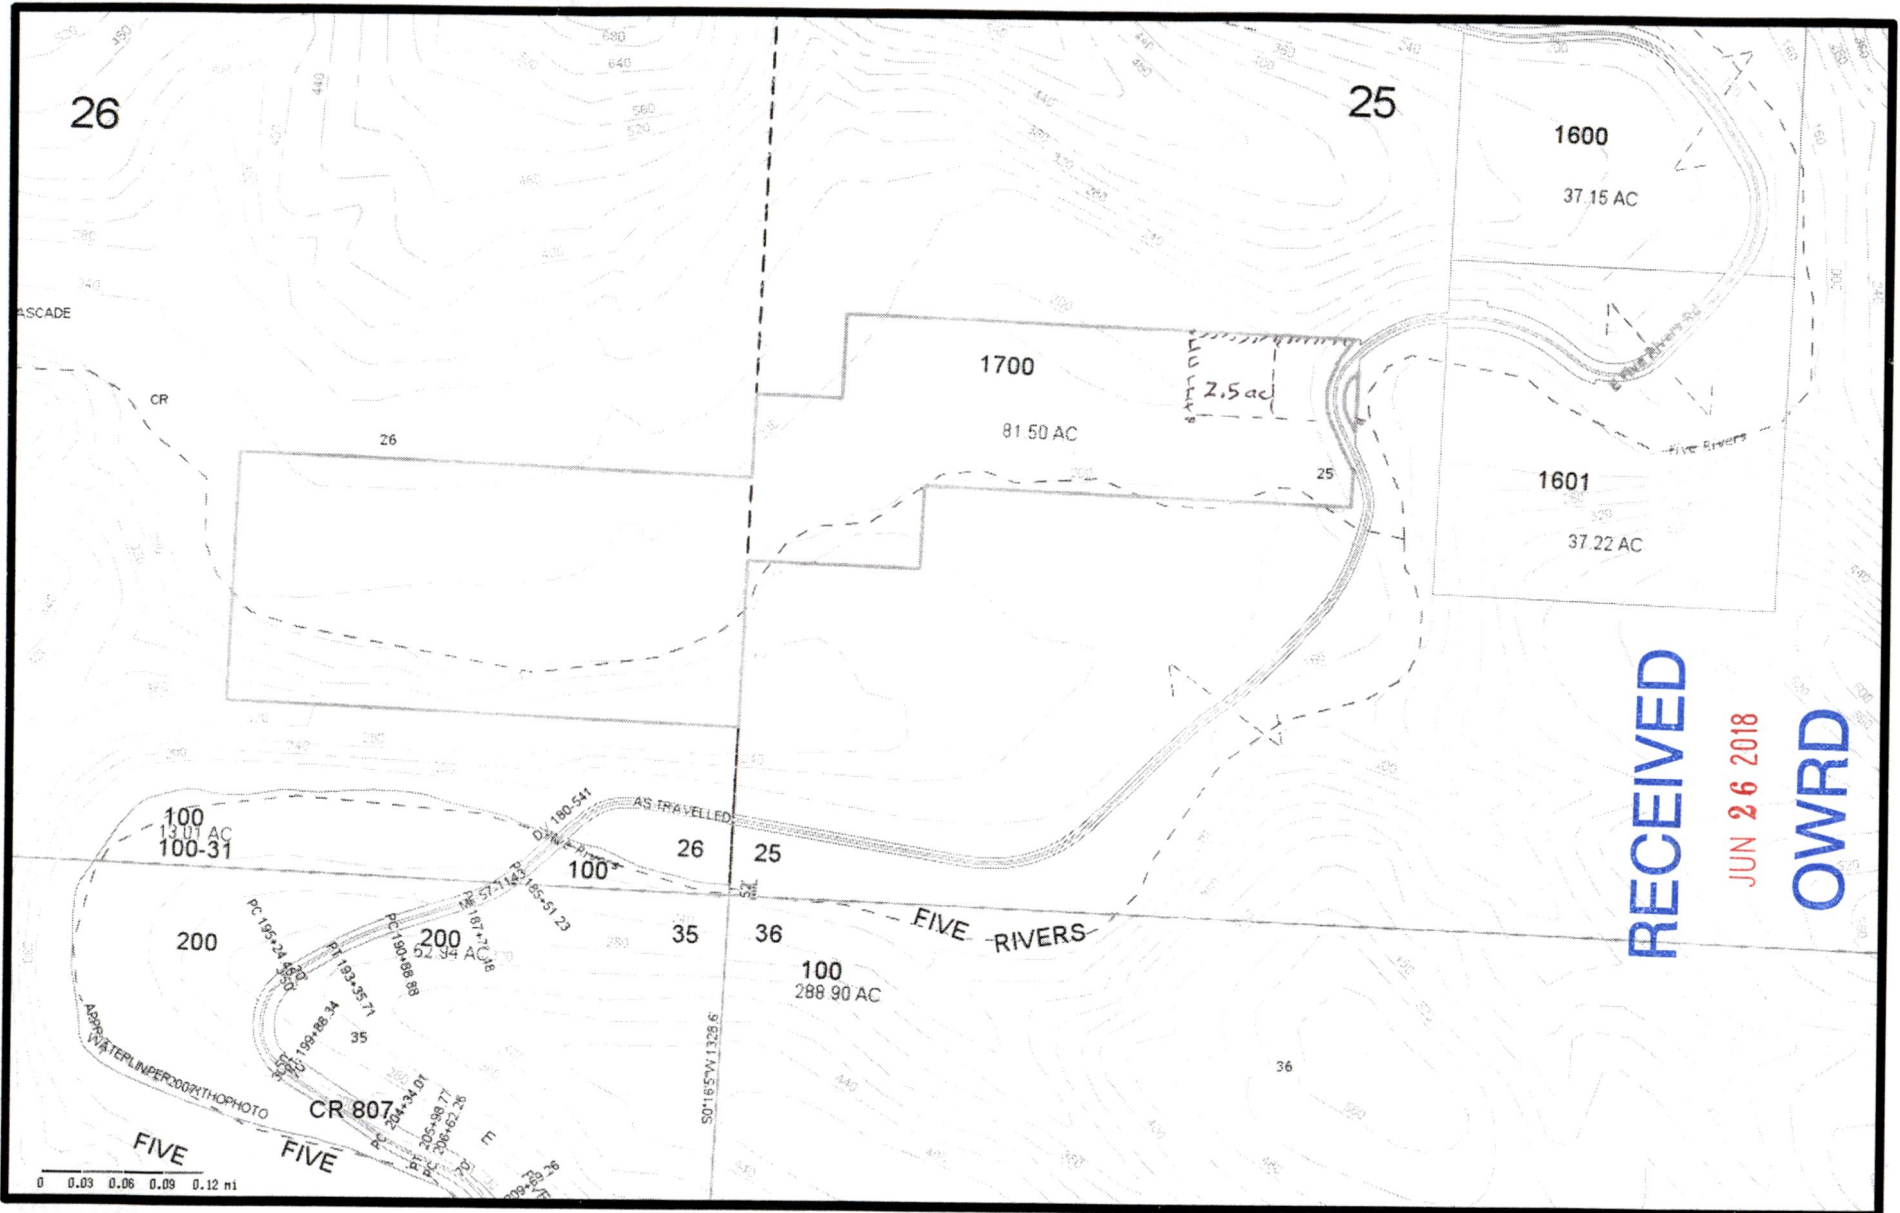

Printed 06/20/2018

Lincoln County government use only. Use for any other purpose is entirely at the risk of the user. This product is for informational purposes and may not have been prepared for, or be suitable for legal, engineering, or surveying purposes. Users should review the primary information sources to ascertain their usability.



5-888573

CASSES

1" = 300 ft

T14S, R10W, Section 25, W.M.

Scale 330 660 ft



Spring Source
365 ft West of
NE Property Corner

SPRING LOCATION



1/4 section Line (1320 ft)

(2640 ft)

Unnamed Spring SOURCE

N.E. Property corner

U.S.F. Service Access Rd.

U.S.F.S.

LINZY

SE 1/4

5 1/2

5 ac

2 1/2 ac

2 1/2 ac

SE 1/4

25.0 ac

SW 1/4

Section Line

26 25

T.L. 1700

N 1/2

5 ac

N 1/2

5 ac

SW 1/4

2 1/2 ac

Falls

U.S.F.S.

LINZY

5 1/2

10 ac

SW 1/4

LINZY

U.S.F.S.

Cascade Creek

Bridge

U.S.F.S.

FIVE RIVERS ROAD

1/4 Section line

CASCADE CREEK

NOTE: Portion of T.L. 1700
Identifying specific
quarters for water
transmission.

RECEIVED

JUN 26 2018

OWRD

PROPERTY: Darrell & Sonja LINZY
at: 5952 E. Five Rivers Rd.
Tidewater, OR 97390

N 1/2
U.S.F.S.

588573

Tax Lot 1700

OWRPD

JUN 26 2018

RECEIVED

Spring Source

Small Earth Dam

Catching Tank (15 gal)

100' of 1/2" Plastic Pipe

140' of 3/4" Plastic Pipe

Stain. Steel milk Storage Tank (300 gal)

Regulator Valve (lying on surface)

Shutoff Valve Water Line 365ft

SW 1/4

2.50 acres SW 1/4, NE 1/4, NE 1/4 (90% buried)

430' of 1" Plastic Pipe

Cutoff Valve

Manufactured Home

3000ft² Fenced Garden

Power Pole Transformer

Power Line

N.E. Property corner

From corner U.S.F.S. LINZY

Five Rivers Rd

FIVE RIVERS

Culvert

Land stake

U.S.F.S. Access Road (Gravel)


To: Cascade creek Five R.

NOTE: Not to Scale! Location and size of components is not exact. Drawing for illustration purposes only.

Water System Landmarks and Component Layout for Existing Construction

T14S, R10W, Section 25, W.M.

Property: Darrell & Sonja LINZY at: 5952 E. Five Rivers Rd Tidewater, OR 97390

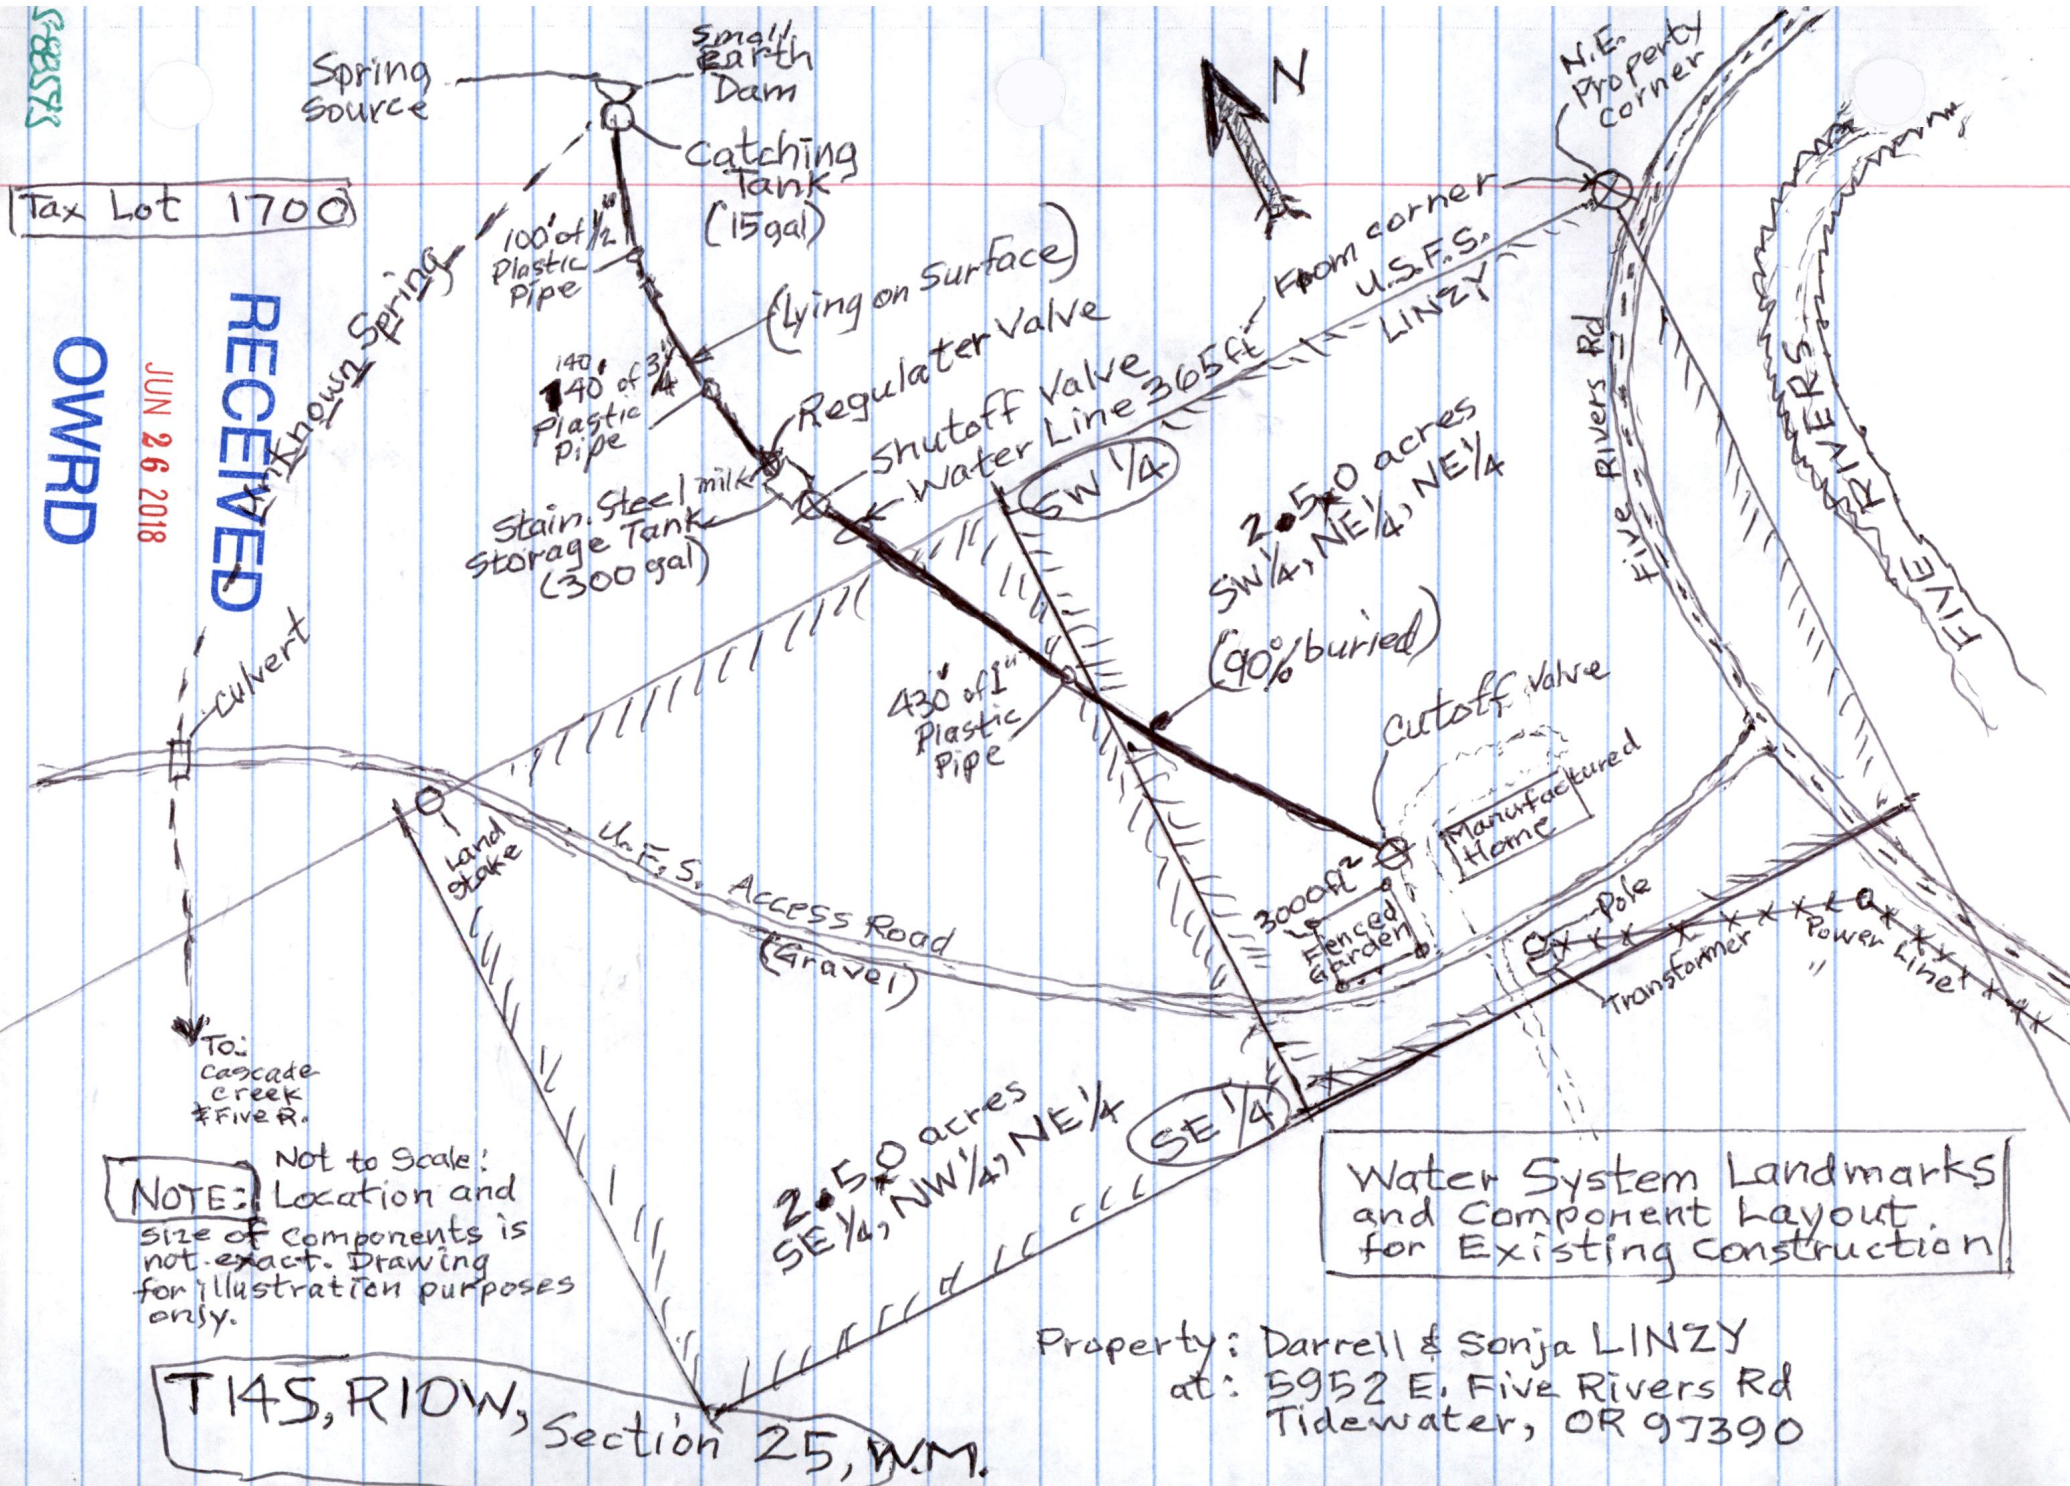

80ac
Quarter Lots

8
SW 1/4, NE 1/4
S 1/2, NW 1/4
N 1/2, SW 1/4
NW 1/4, SE 1/4

} NE 1/4

S 1/2, NE 1/4
SE 1/4, NW 1/4
SW 1/4
N 1/2, SE 1/4

} NW 1/4

~~SW 1/4~~
Sec 25

4
S 1/2, S 1/2, NE 1/4

S 1/2, SE 1/4, NW 1/4

NE 1/4, SW 1/4, ~~SW 1/4~~

~~NE 1/4, SW 1/4, SE 1/4~~

N 1/2, SE 1/4

} SE 1/4

Sec 26