


G-18716

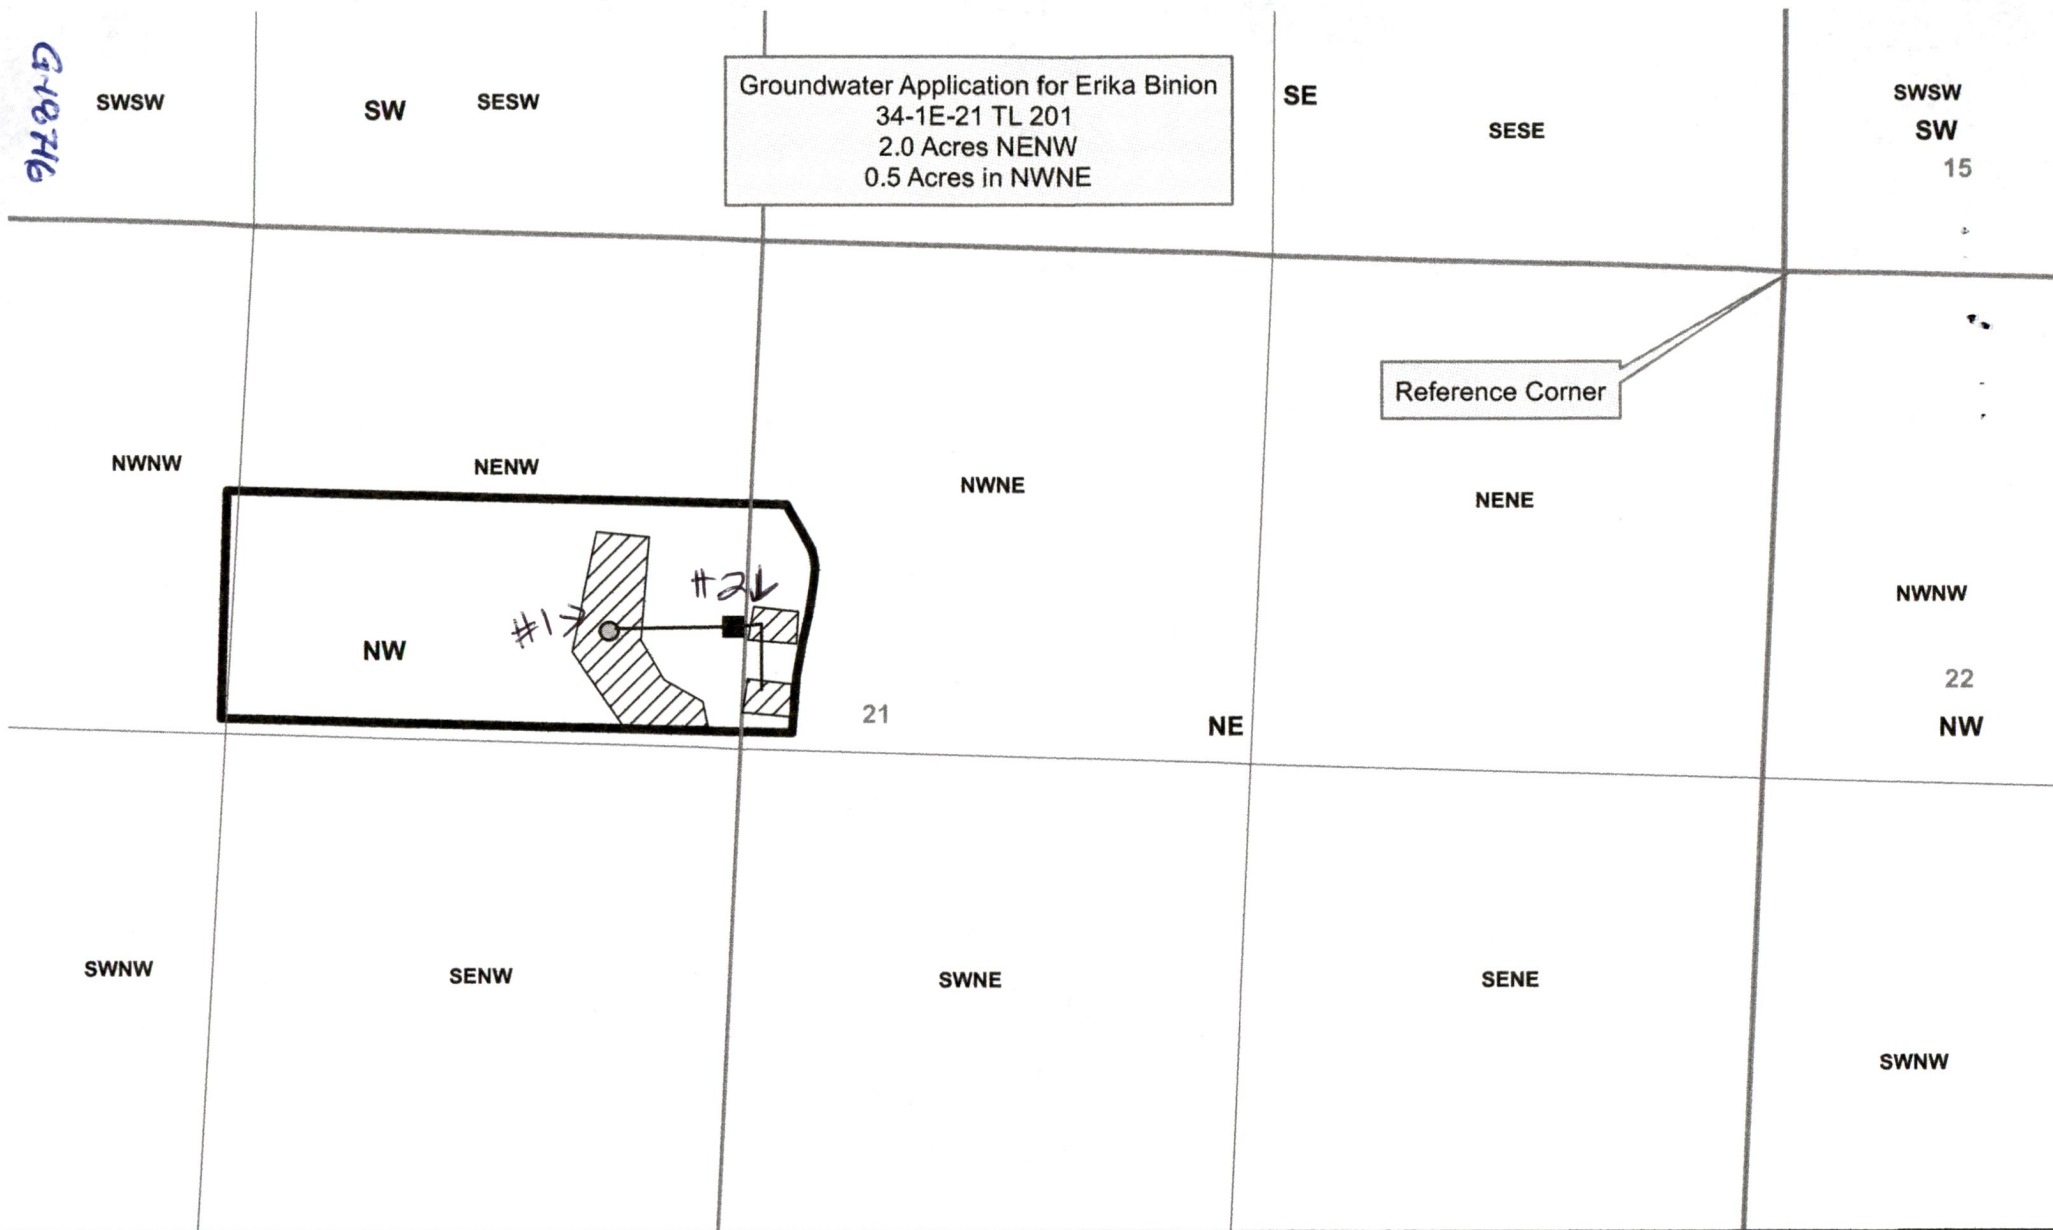

Legend

- Well #1
- Well #2
- ▨ POU Irrigation
- ▭ TL 201

Well #1 *West well # L81911*
3011 ft West and 988 ft South
from NE Corner of Section 21

Well #2 *East well # L80500*
2688 ft West and 955 ft South
from NE Corner of Section 21

1 inch = 500 feet



JACKSON COUNTY

**WATERMASTER
WITH INPUT FROM ERIKA BINION**

This map is based on a digital database compiled by Jackson County from a variety of sources. Jackson County cannot accept responsibility for errors, omissions, or positional accuracy. There are no warranties, expressed or implied.

Date: 07/11/2018: 34-1E-1 TL 201 Erika Binion.mxd; haynessl

RECEIVED
JUL 16 2018
OWRD