


T.12S, R.4W, SECTIONS 1 & 12, W.M.
LINN COUNTY

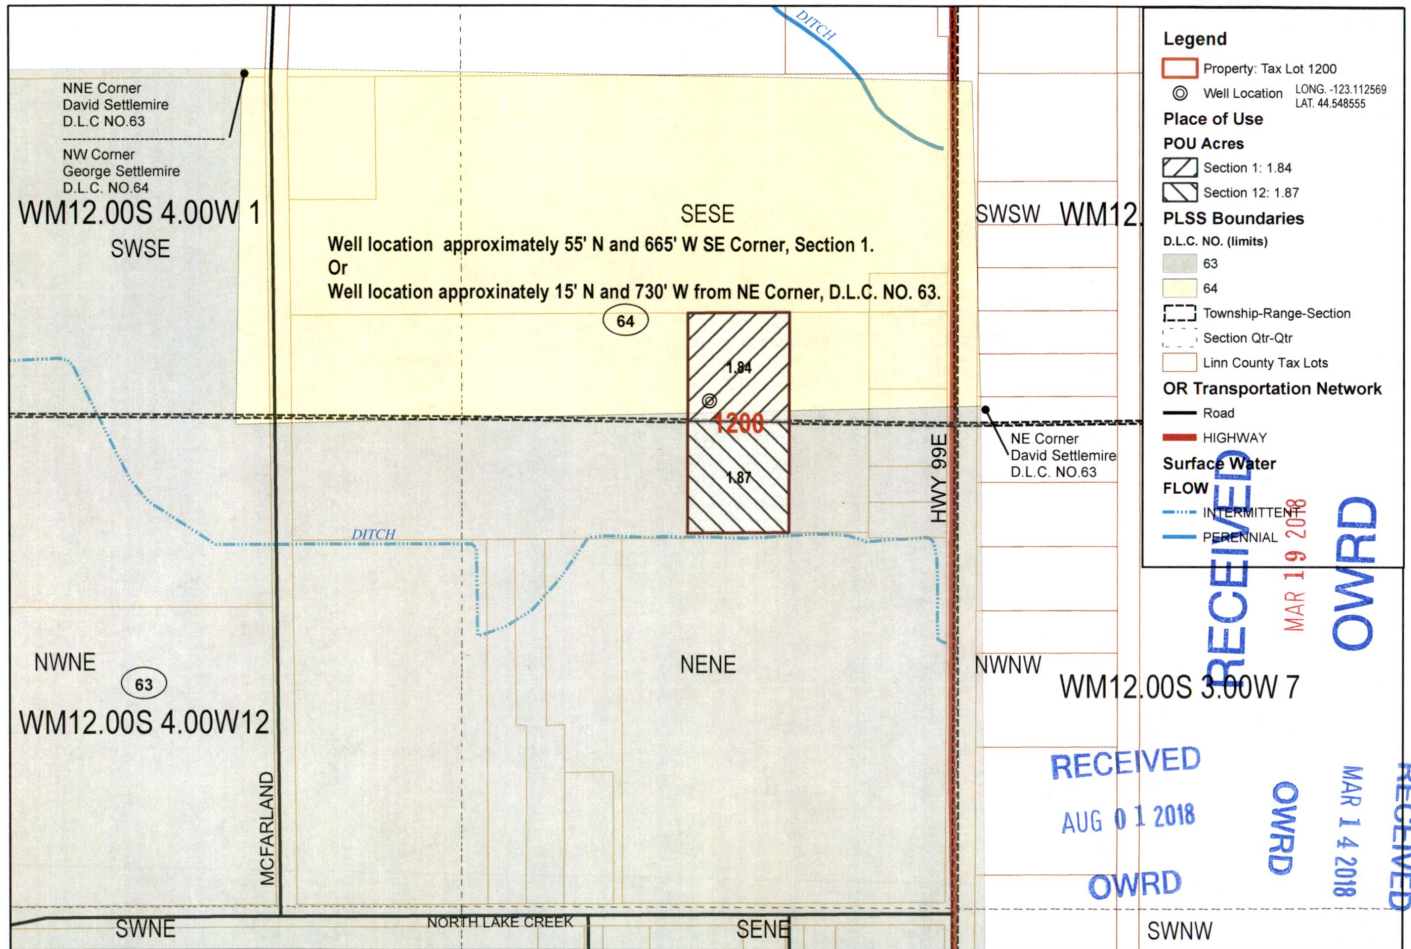

Coordinate System: OCRS Eugene NAD 1983 2011 TM Feet Intl
Projection: Transverse Mercator
Datum: NAD 1983 2011
Units: Foot

References
GIS Spatial Data Layers: Oregon Spatial Data Library
Website: <http://spatialdata.oregonexplorer.info/geoportal/>

0 100 200 400 600 800 1,000
Feet

1 inch = 400 feet



RECEIVED
MAR 19 2018
OWRD

RECEIVED
AUG 01 2018
OWRD

RECEIVED
MAR 14 2018
OWRD

022820