


Tim Jensen
T 32 S, R 16 E, Section 14

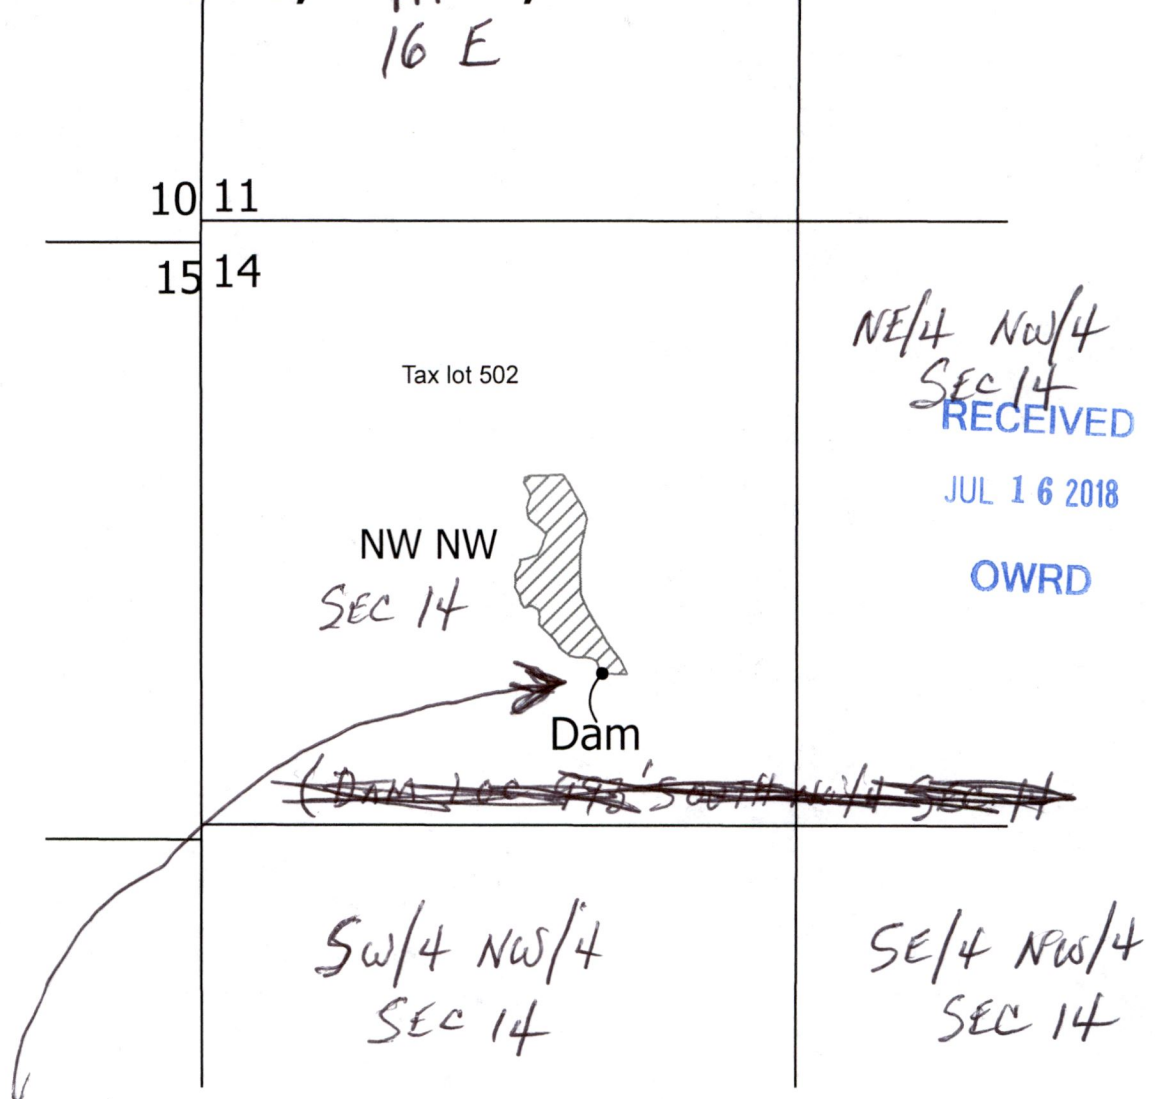

Dam located 993' South and 883 East of the NW Corner, Section 14

RECEIVED

AUG 09 2018

OWRD



1 inch = 400 feet

B.

R-00657