


T.38S., R.3 & 4W., W.M.

RECEIVED


AUG 06 2018

OWRD

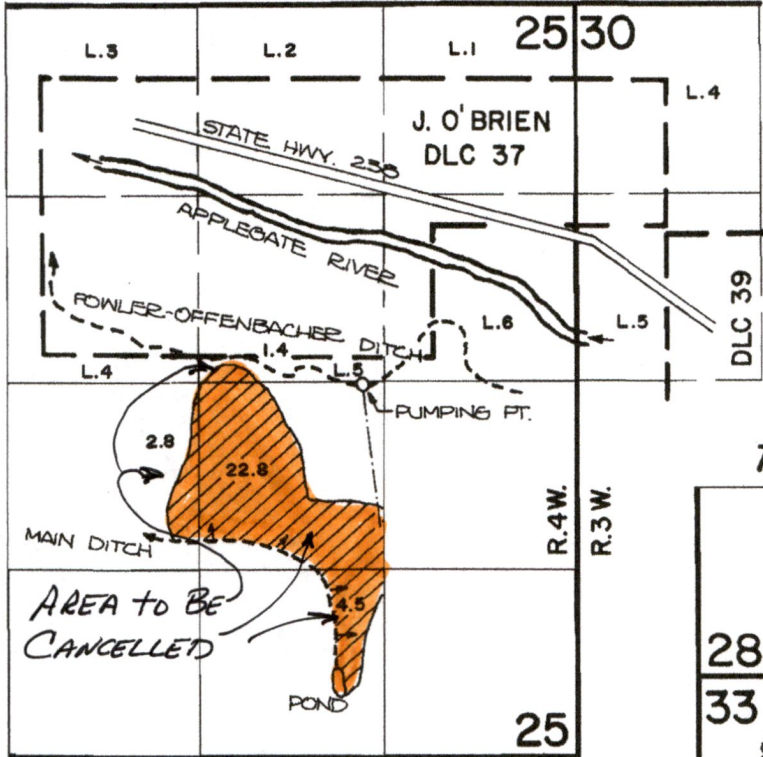

DIV. PT. IS LOCATED 40' N. AND 1610' E. FROM THE S.W. CORNER OF SECTION 25, T.38S., R.3W., W.M.

T.38S., R.3W., W.M.

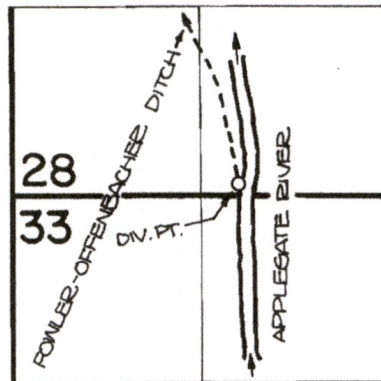

FINAL PROOF SURVEY
UNDER

AREA TO BE
CANCELLED

Application No. 62061... Permit No. 46020... CERT 57656
50272... 37905... CERT 57655





APPLEGATE BRANGUS RANCH

OCT. 31 1983
Surveyed JULY 20, 1983, by B. JAMES...

S-88655

T.38S., R.3 & 4W., W.M.

RECEIVED
AUG 06 2018
OWRD

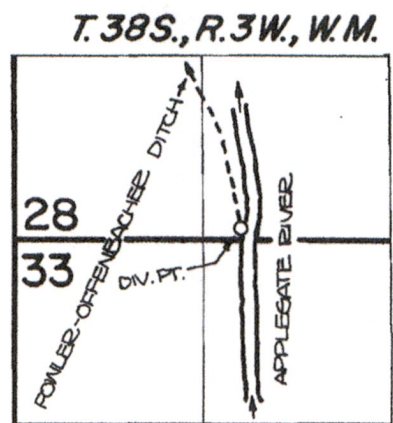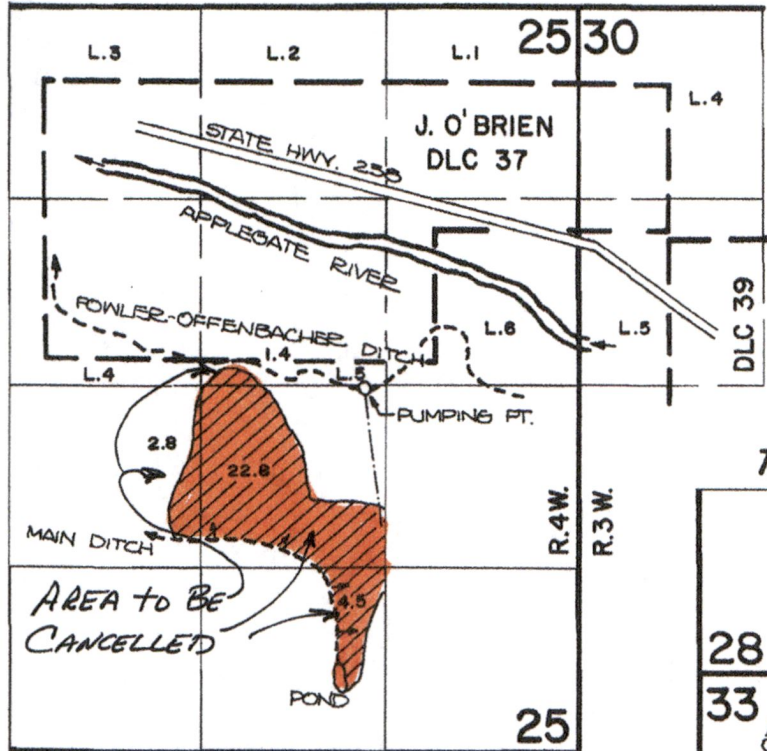

DIV. PT. IS LOCATED 40' N. AND 1610' E. FROM THE S.W. CORNER OF SECTION 28, T.38S., R.3W., W.M.

FINAL PROOF SURVEY UNDER

AREA TO BE
CANCELLED

Application No. 62061 Permit No. 46020 CERT 57656
50272 Permit No. 37905 CERT 57655

IN NAME OF APPLEGATE BRANGUS RANCH

OCT. 31 1983
Surveyed JULY 20, 1983, by B. JAMES

S-88655

RECEIVED

AUG 06 2018

OWRD

MAP OF WATER RIGHT APPLICATION
 SECTION 25, TOWNSHIP 38 SOUTH, RANGE 4 WEST, W.M.
 JACKSON COUNTY, OREGON
 FOR
 LESLIE C. AND RACHAEL A. MARTIN
 11777 HIGHWAY 238
 JACKSONVILLE, OREGON 97530



Scale: 1"=400'
 Date: July 20, 2018


LEGEND

- Found Survey Monument
- Denotes Building/Structure
- Denotes DLC 37 Boundary
- Denotes Tax Lot Boundary
- - - Denotes Section Subdivision Boundary
- PD Denotes Proposed Point of Diversion
- P- Denotes Buried Mainline Pipe
- ▨ Denotes Area Certificate No. 34147, Priority Date May 10, 1956, Primary Proposed Supplemental Right From Applegate Reservoir This Application
- ▩ Denotes Area Certificate No. 34147, Priority Date May 10, 1956, Primary Right—No Supplemental Right

Note—Following Certificates To Be Cancelled Upon Issue Of New Supplemental Permit.


Certificates 57655 and 57656 Affidavits For The Cancellation Of An Entire Water Right Attached.

This map was prepared for the purpose of identifying the location of a water right only and is not intended to provide legal dimensions or location of property ownership.

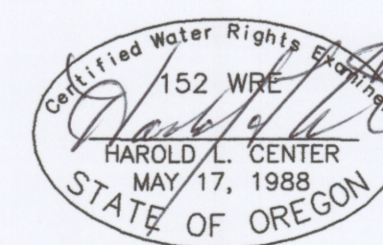

HAROLD L. CENTER, P.L.S., C.W.R.E.
 2604 David Lane
 Medford, OR. 97504
 Phone 541-535-6108
 Oregon Certificate No. 152
 Certificate Renewal Date:

Renews: 12/31/19

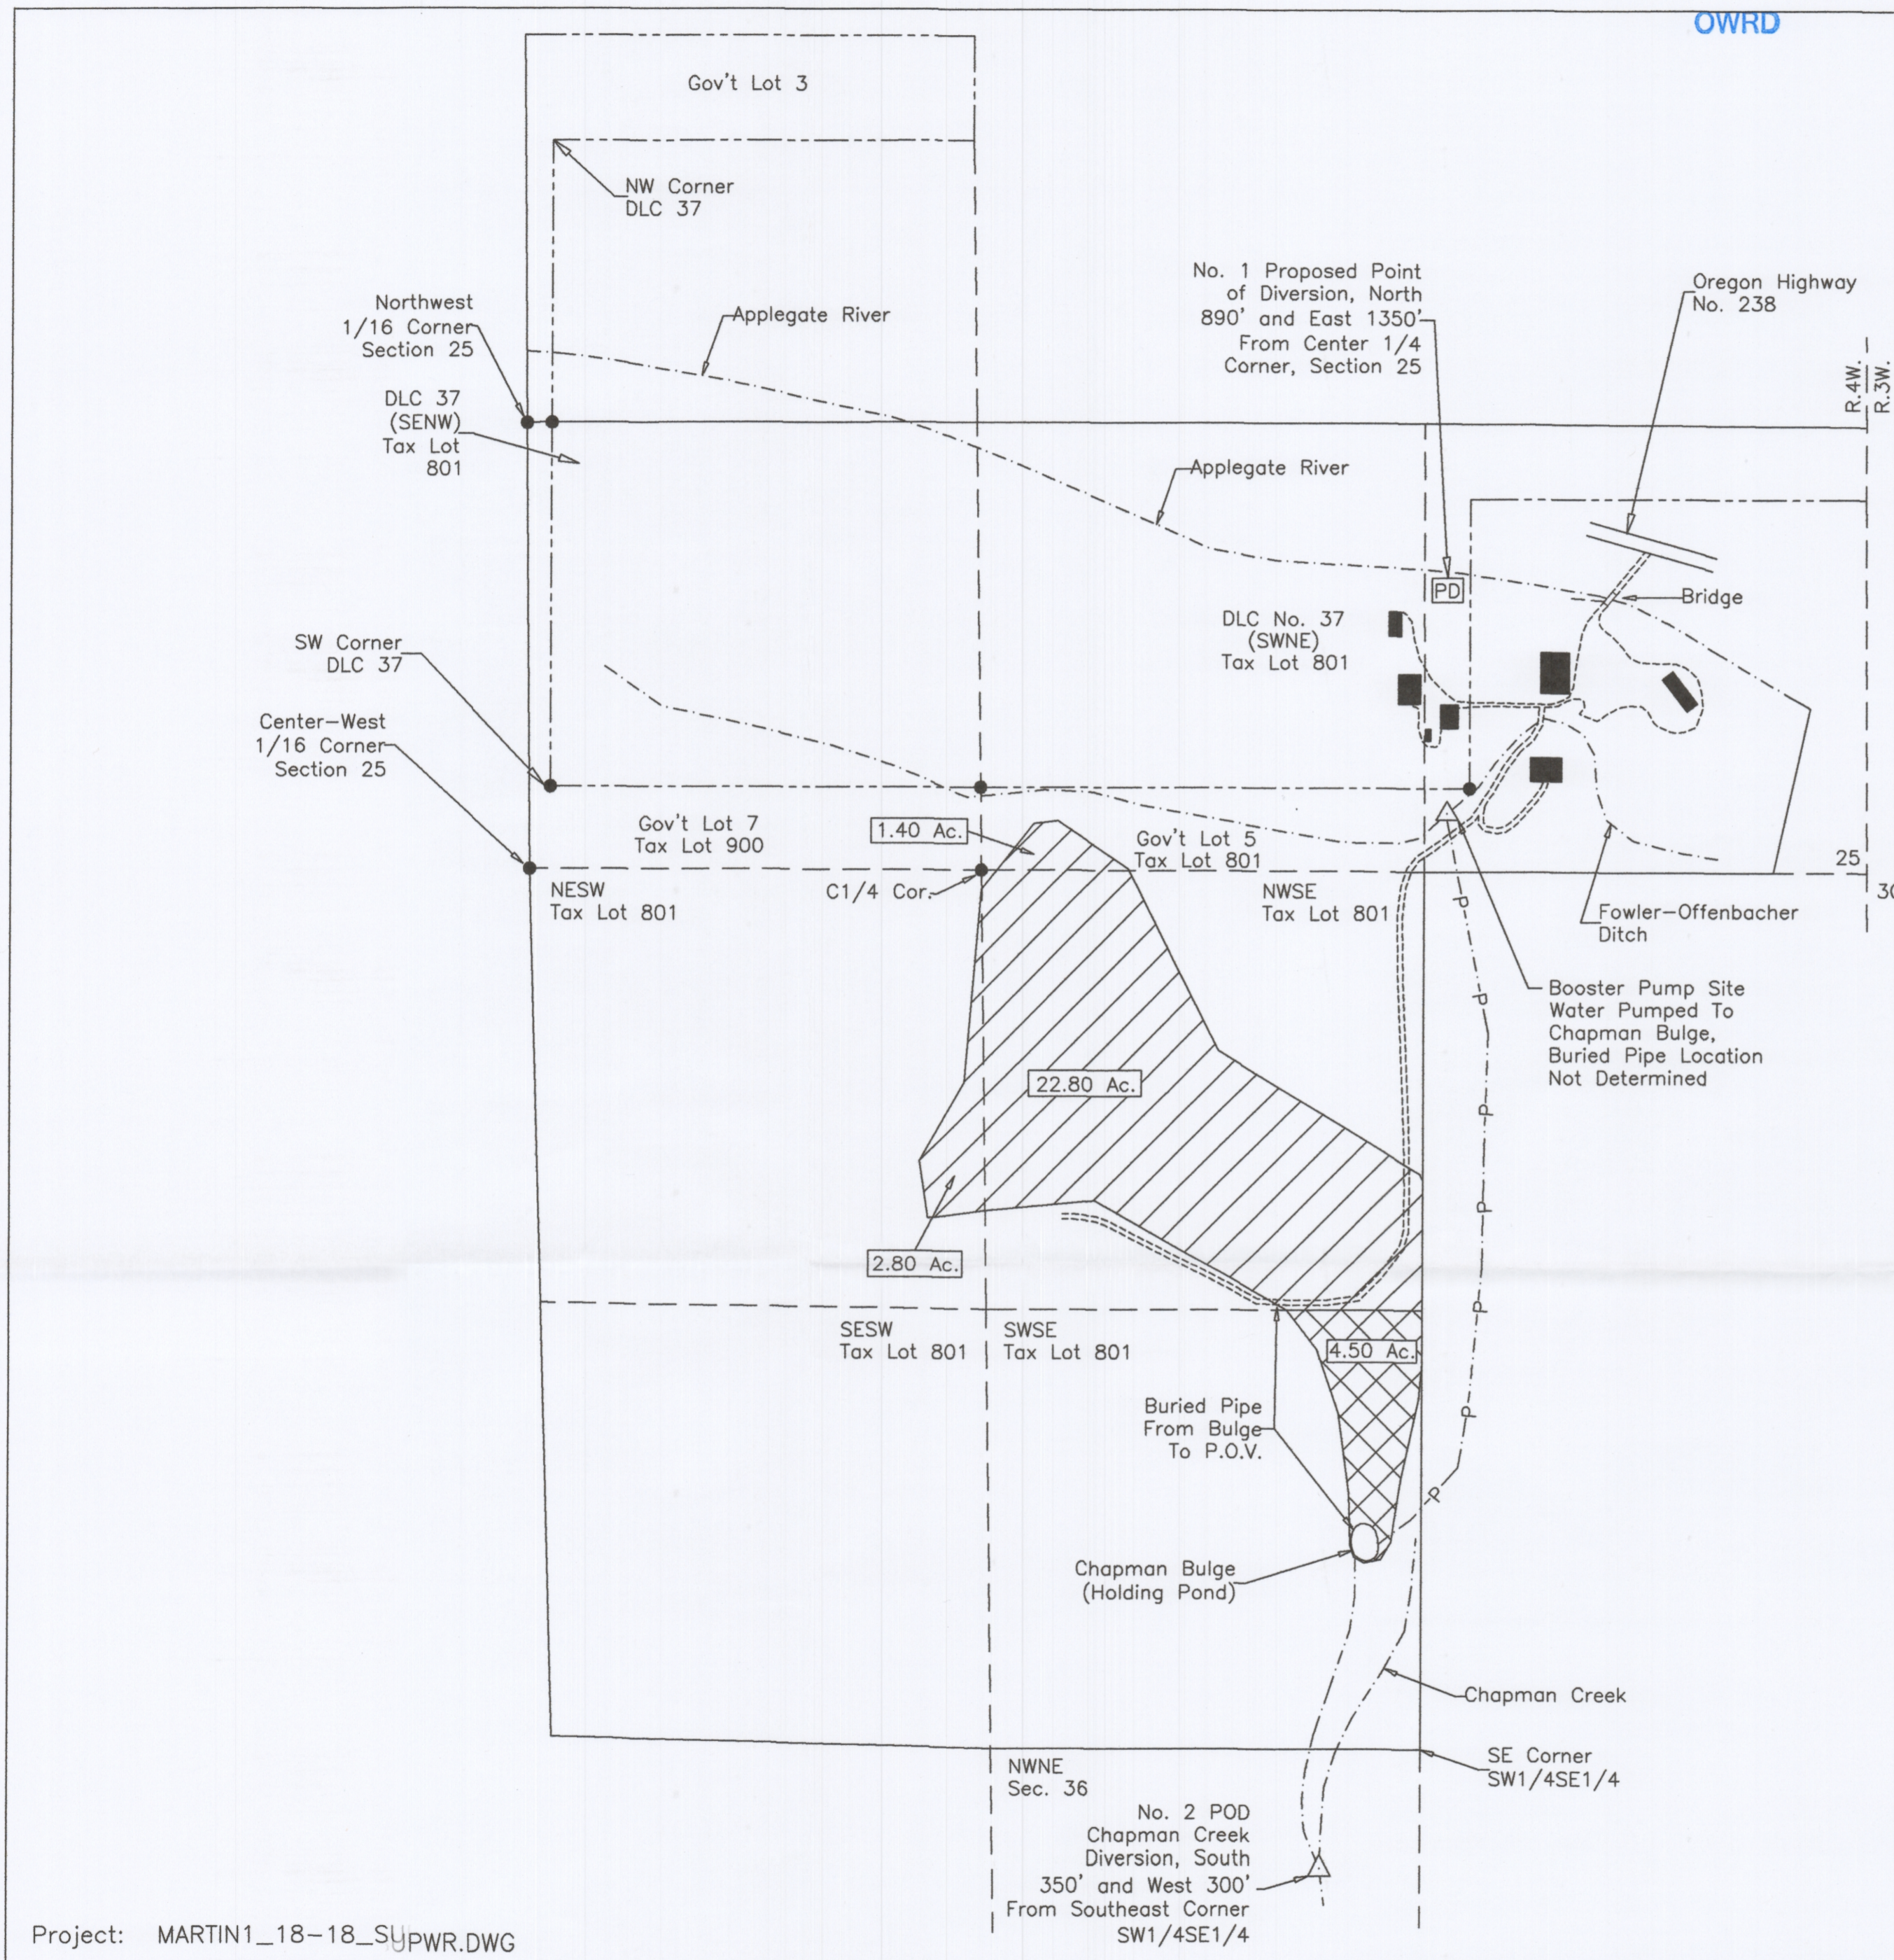

Project: MARTIN1_18-18_SypPWR.DWG

S-88655