


OWRD

R-88661

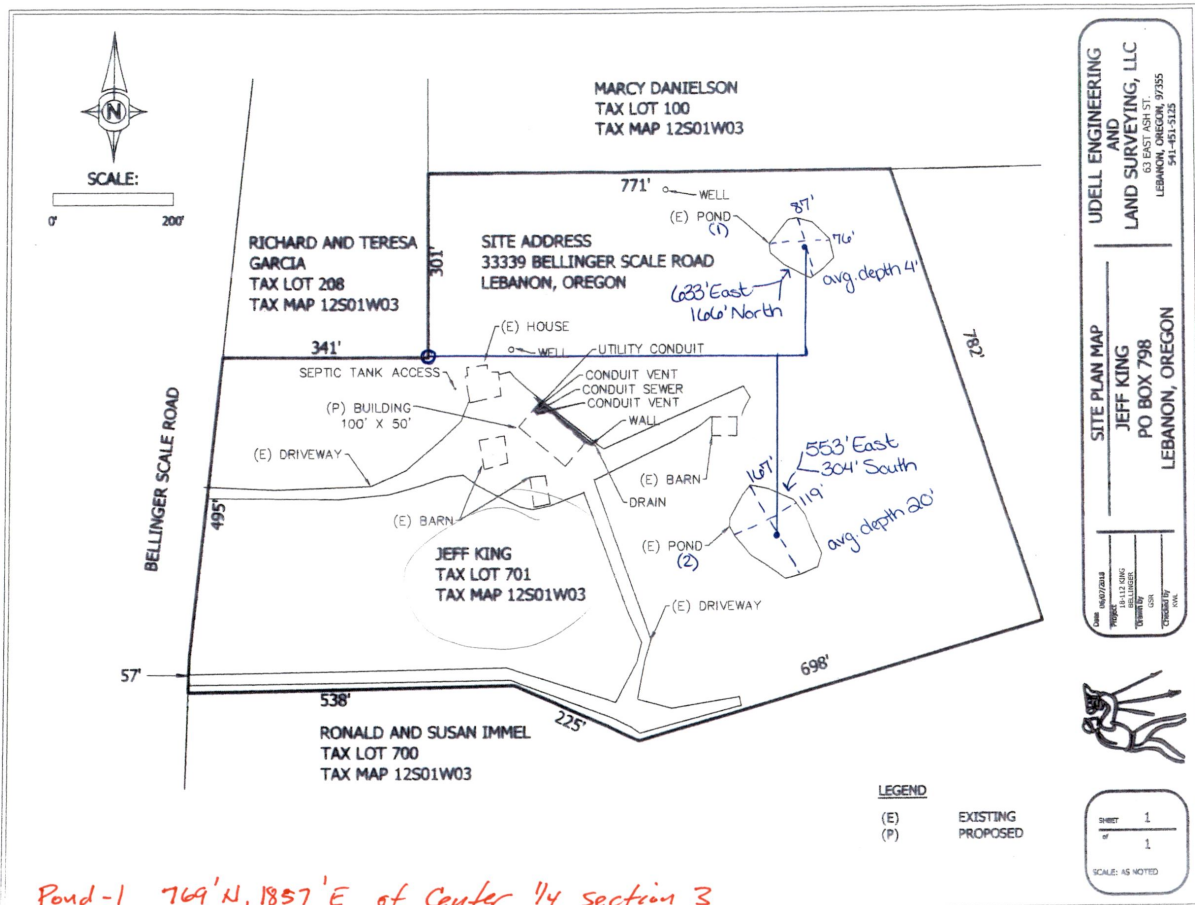

Pond-1 769'N, 1857'E of Center 1/4 section 3

D.D.

RECEIVED
AUG 13 2018
OWRD