


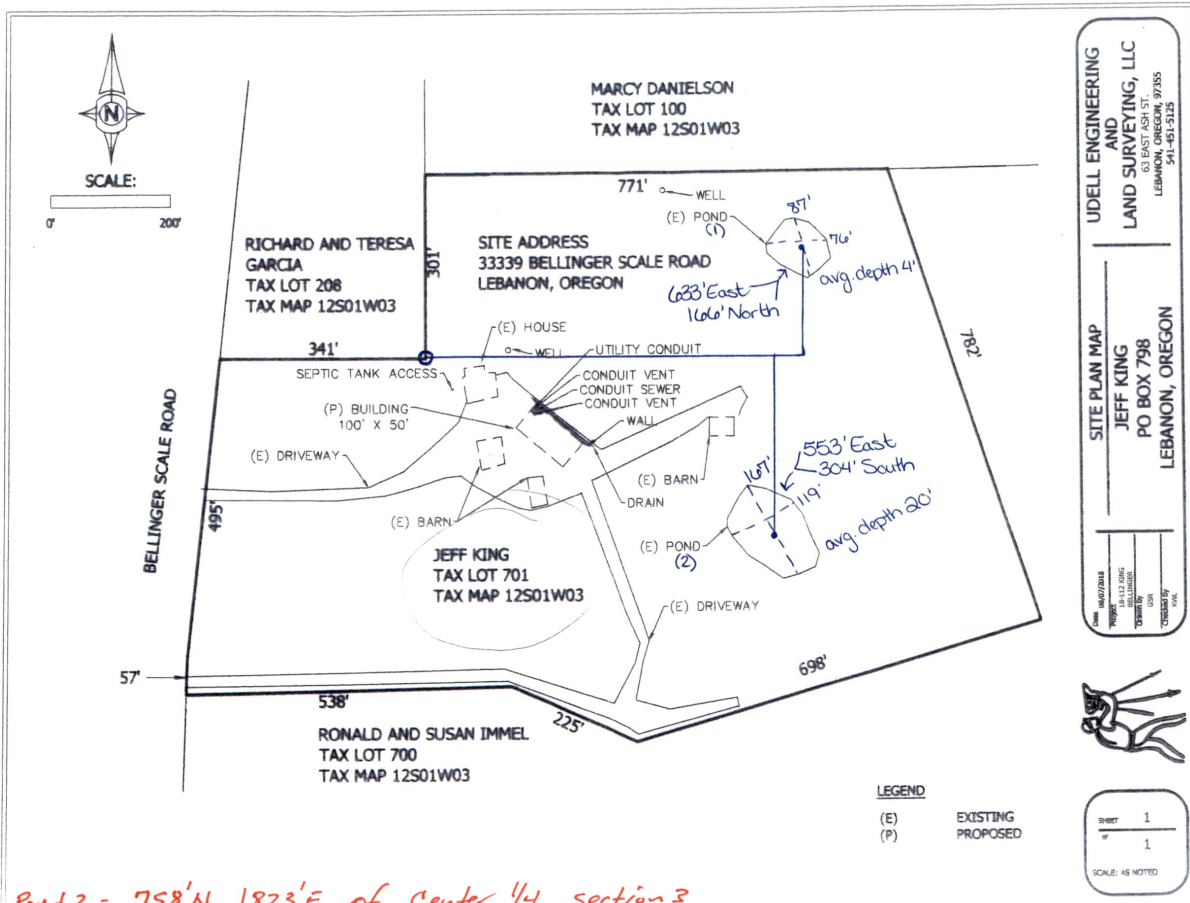

Rever



D.D. Pond 2 - 758'N, 1823'E of Center 44 section 3

2-88662