



Oregon Water Resources Department
 725 Summer Street NE, Suite A
 Salem, Oregon 97301
 (503) 986-0900
 www.wrd.state.or.us

Request for Assignment

If the Department determines that the application is incomplete, fees have not been paid, or the required documents are not acceptable, the application and all fees submitted will be returned to the applicant.

If for multiple rights, a separate form and fee for each right will be required.

I, NF Land LLC

(Name of Current Holder of Record)

2885 Sanford Ave SW, #21711

Grandville, MI 49418

206-310-7631

(Mailing Address)

(City)

(State)

(Zip)

(Phone #)

hereby assign all my interest in and to the entire application/permit/transfer/limited license/groundwater statement; (example, sold all the land authorized under the right)

See attached

hereby assign all my interest in and to a portion of application/permit/transfer/limited license/groundwater statement; (*You must include a map showing the portion of the application/permit/transfer order/limited license/groundwater statement to be assigned.* Example, sold a portion of the land authorized under the right) See attached

hereby assign a portion of my interest in and to the entire application/permit/transfer/limited license/groundwater statement; (example, adding an additional person)

Application # G-17604; Permit # G-17347; Transfer # _____;

Limited License # _____; Groundwater Statement # _____;

as filed in the office of the Water Resources Director, to:

Grand Reve Vineyards, LLC

(Name of New Owner)

404 289th PI NE

Carnation, WA 98014

425-890-3095

(Mailing Address)

(City)

(State)

(Zip)

(Phone #)

Note: If there are other owners of the property described in the application, permit, transfer order, limited license, or groundwater statement, you must provide a list of all other owners' names and mailing addresses and attach it to this form. Write the initials (first letters) of your first and last names at the spot indicated below SH.

I hereby certify that I have notified all other owners of the property described in this application, permit, transfer order, limited license, or groundwater statement of this Request of Assignment.

Witness my hand this 22nd day of August, 2018.
 (Day) (Month) (Year)

Signature of Current Holder of Record Annal Hobbs, Member

Failure to provide any of the required information will result in the return of your application.

DO NOT WRITE IN THIS BOX

This certifies assignment and record change at Oregon Water Resources Department effective 8:00 a.m. on date of receipt at Salem, Oregon.

Fee receipt # 12766
 For Director by Jerry Sauter, Program Analyst in Water Rights Division

Last updated: September 18, 2011

The completed "Request for Assignment" form *must* be submitted to the Department along with the recording fee of \$100.

Request for Assignment

RECEIVED

WR


AUG 31 2018

OWRD

ASS 1602
 JEL 9/5/2018

Addendum to “Request for Assignment” Form Submitted by NF Land LLC for Permit G-17347

NF Land LLC has sold to Grand Reve Vineyards, LLC a portion of the land that makes up the authorized place of use under permit G-17347, specifically, tax lots 5N 36 3001 and 5N 36 202, outlined in red on the following map. The land sold to Grand Reve Vineyards, LLC totals approximately 101 acres. Permit G-17347 authorizes the use of water for irrigation on 517.9 acres total, which includes the 101 acres sold to Grand Reve Vineyards, LLC.

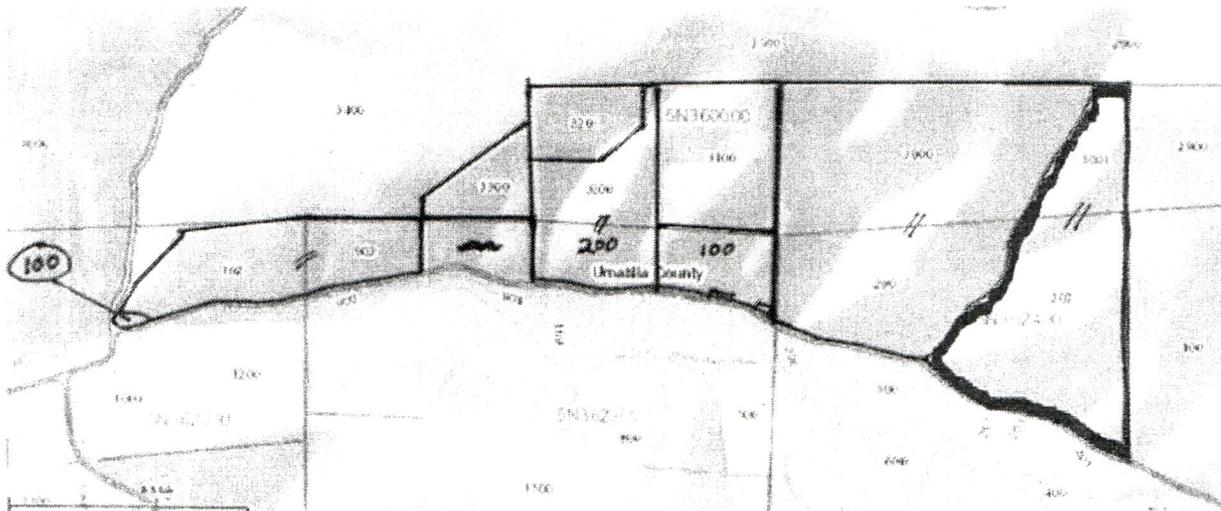

With this Request for Assignment, NF Land LLC is *not* requesting to assign a share of the authorized rate and duty under Permit G-17347 that is proportional to the overall number of acres authorized for irrigation under Permit G-17347. Rather, the requested assignment to Grand Reve Vineyards, LLC is for a portion of the permit, consisting of approximately 101 acres, but with a *maximum* rate of 150 gallons per minute and a *maximum* duty of 60 acre-feet per year. Thus, the balance of the total rate and total duty authorized under the permit would remain with NF Land LLC. As the rate and duty amounts requested for assignment to Grand Reve Vineyards, LLC are maximums, any portion of the 150 gallons per minute of rate and/or the 60 acre-feet per year of duty that is not developed by Grand Reve Vineyards, LLC by the end of the permit development period (including any extensions) or claimed as part of the claim of beneficial use by Grand Reve Vineyards, LLC land shall remain with NF Land LLC for use on its lands as otherwise authorized under Permit G-17347.

RECEIVED

AUG 31 2018

OWRD