

RECEIVED

SEP 10 2018

OWRD

**STATE OF OREGON
EXEMPT USE WELL MAP**

(as required by ORS 537.545 & OAR 690.190)

This map is supplemental to the WATER SUPPLY WELL REPORT

Oregon Water Resources Department

725 Summer St NE, Salem, OR 97301

(503)986-0900



LOCATION OF WELL

Latitude: 42.51042666

Longitude: -122.88463871

Datum: WGS84

Township/Range/Section/Quarter-Quarter Section:

WM 35.00S 2.00W 24 NWSE

Address of Well:

3903 HWY 234, WHITE CITY OR 97503

Well Label: L110624

Well Log: JACK 61498

Printed: Jul 29, 2013


DISCLAIMER: This map is intended to represent the approximate location of the exempt use well provided by the land owner. It is not intended to be construed as survey accurate in any manner.



G-18734

Neil Carter Groundwater Application Map
for Irrigation
Proposed Place of Use:
35S-2W-24-Tax Lot 3000
NWSE 2.8 acres
SWSE 0.2 acres

RECEIVED
SEP 10 2018
OWRD

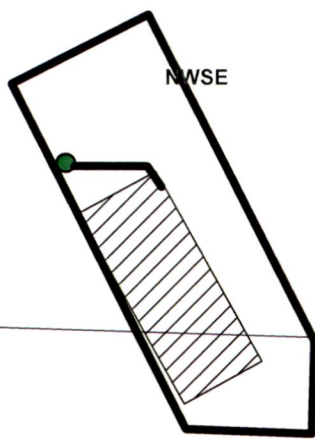

Reference Corner

Legend

- Well #1
- / / / / POU
- TL 3000

Well #1:
2360' W and
1768" N from
SE Corner Section 24

1 inch = 500 feet



JACKSON COUNTY

Prepared by Watermaster
and Neil Carter

This map is based on a digital database compiled by Jackson County from a variety of sources. Jackson County cannot accept responsibility for errors, omissions, or positional accuracy. There are no warranties, expressed or implied.

6-10-7-24