


T.3S. R.5W. W.M.

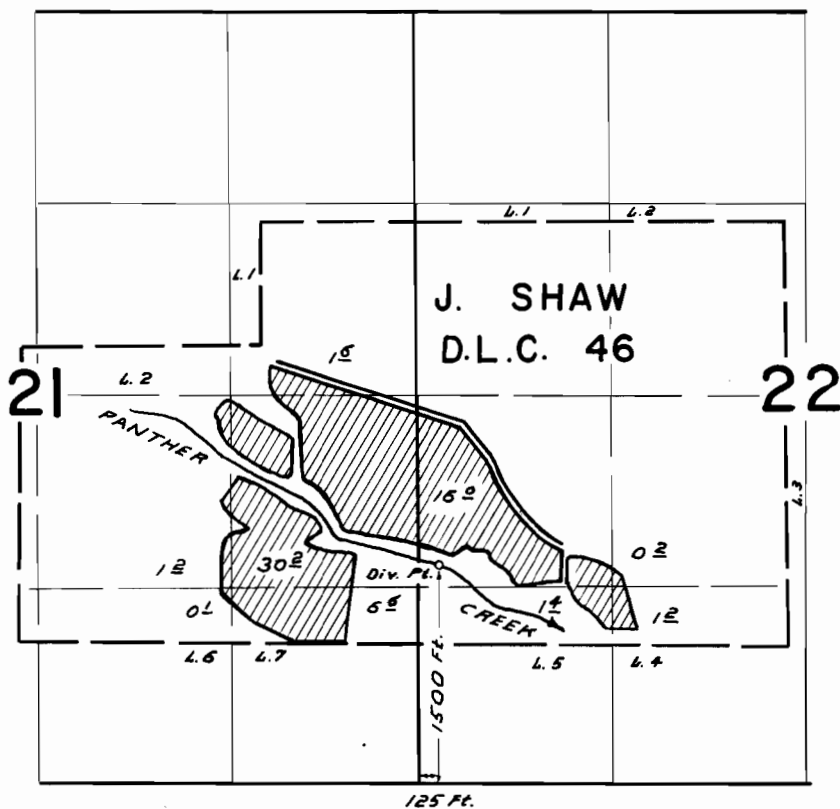

FINAL PROOF SURVEY
UNDER

TRANSFER M-150

Application No. Permit No.
IN NAME OF

WILBUR S. & HOWARD B. MORLEY

Surveyed **AUG 17 1965**, by **L. COLEBANK**