



P.O.D. "A" LINE CANAL

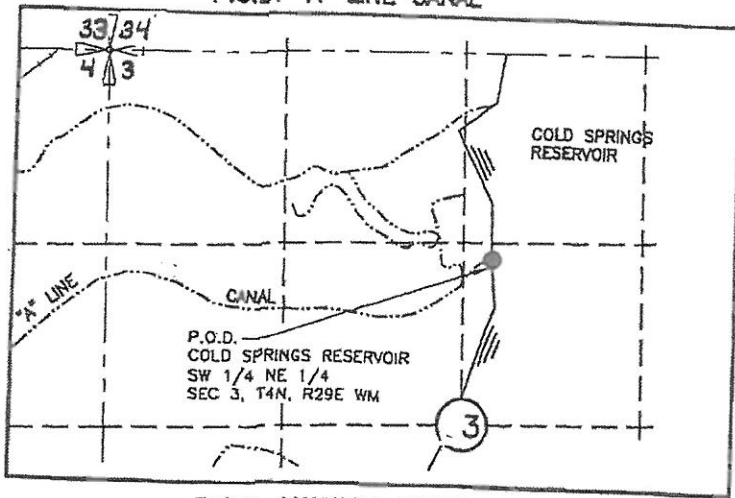


1490 Ft South and 2840 Ft East from the NW Corner, Section 03, T4N, R29E W.M.

P.O.D. MAXWELL CANAL

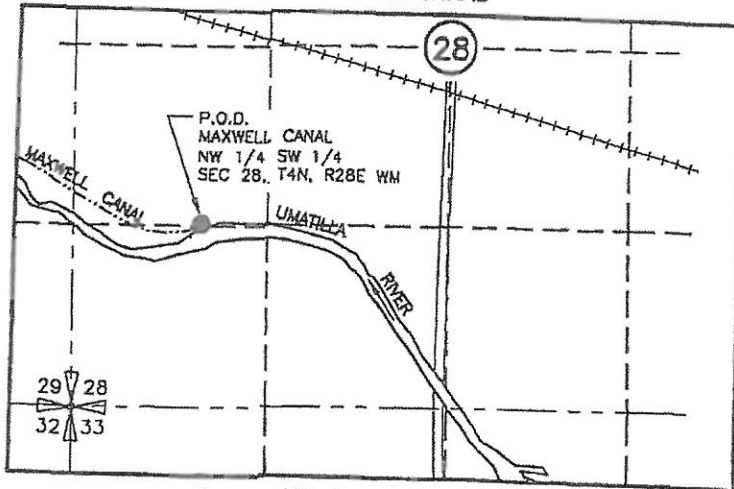

No measurements given for POD

P.O.D. US FEED CANAL

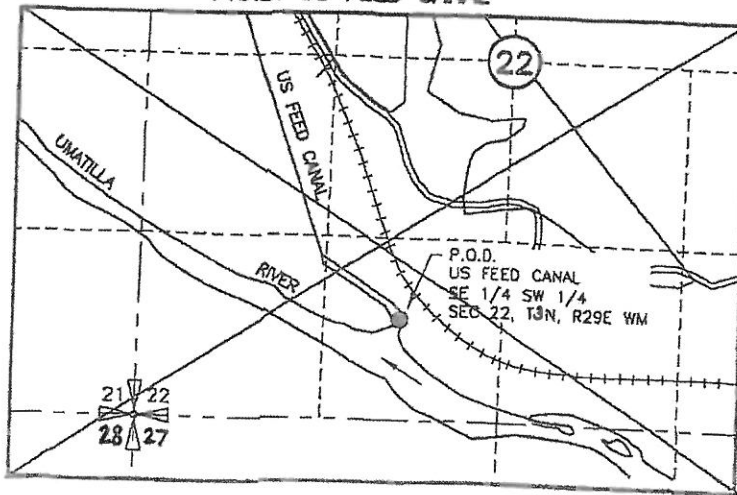

No measurements given for POD

