


T.9&10S.,R.2W.,W.M.

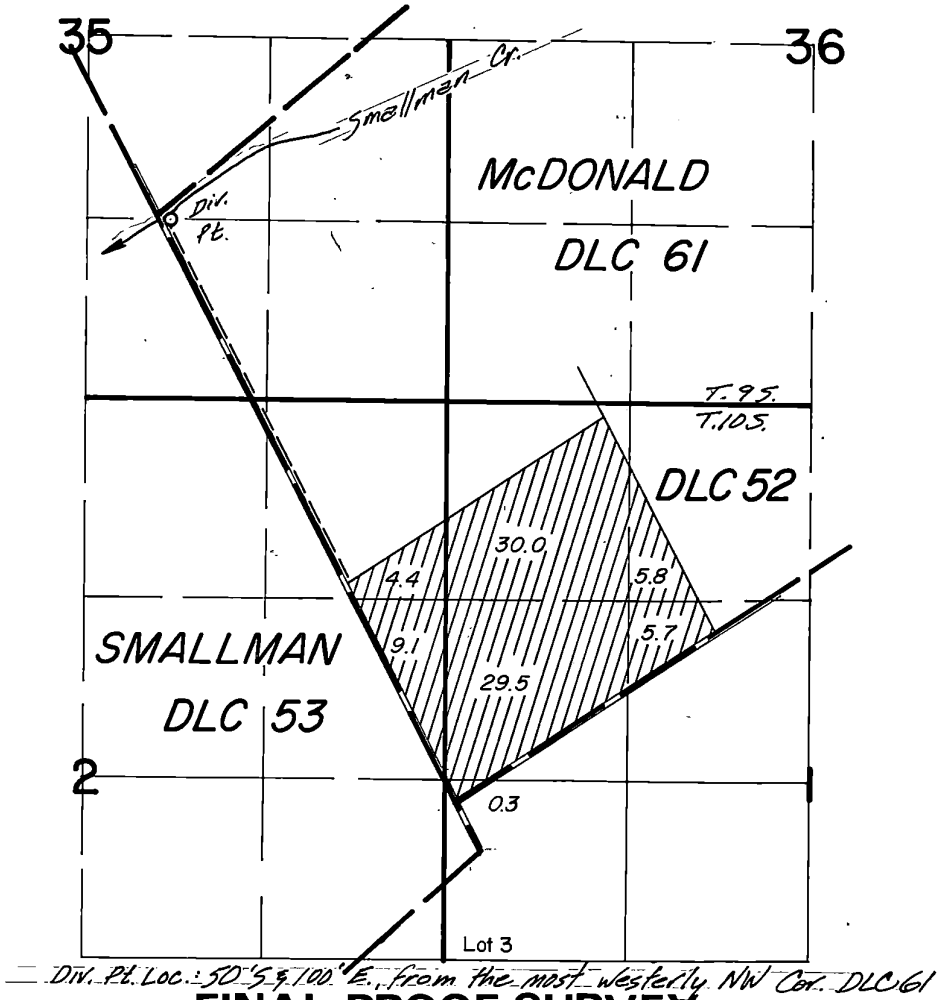

FINAL PROOF SURVEY UNDER

Transfer No. 3515
 Application No. Permit No.
 IN NAME OF
WALTER R. MILLER

Surveyed July 3, 1979, by dcl