


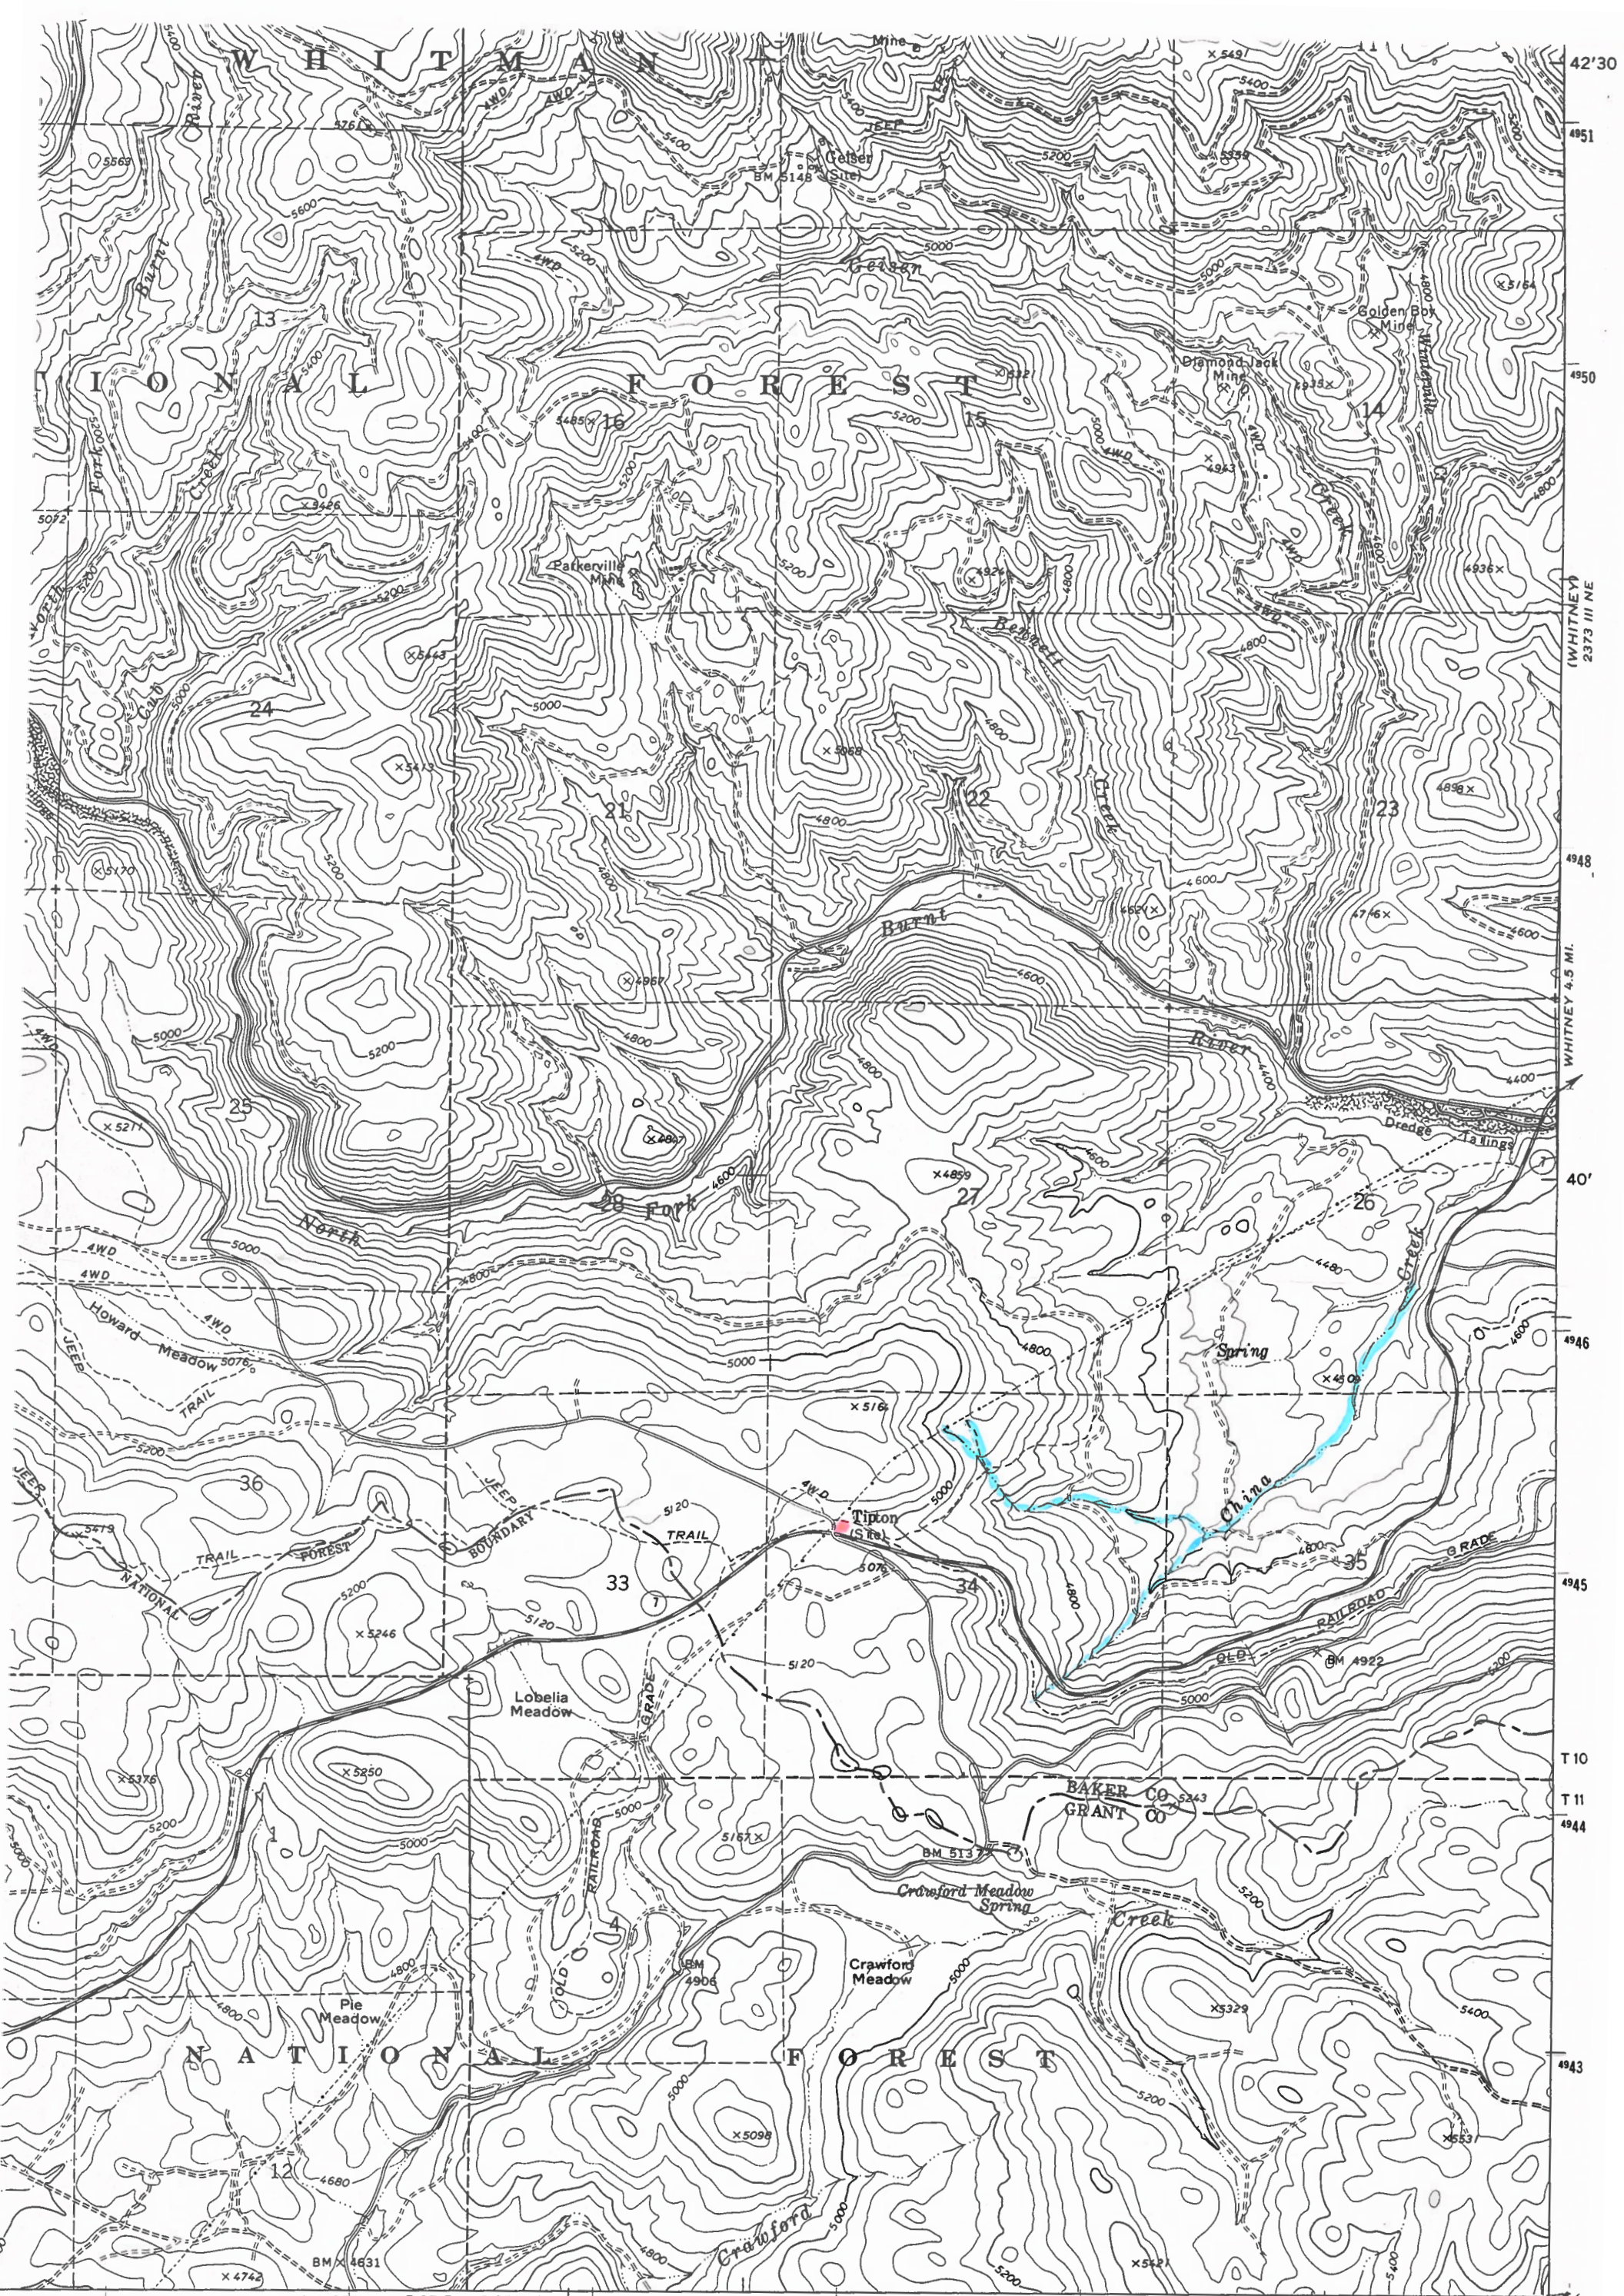

(AUSTIN) 2373 III SW

SCALE 1:24 000

1000 0 1000 2000 3000 4000 5000 6000 7000 FEET

1 0.5 0 1 KILOMETER

CONTOUR INTERVAL 40 FEET

NATIONAL GEODETIC VERTICAL DATUM OF 1929

1 MILE

0.5

0

1 KILOMETER

ROAD CLASSIFICATION

Primary highway, hard surface

Secondary highway, hard surface

Light-duty road, hard or improved surface

Unimproved road

Interstate Route

U. S. Route

State Route

INTERIOR-GEOLOGICAL SURVEY, RESTON, VIRGINIA-1985

3900000E

118°22'3