

1/4 1/4 SESW

10S7W Sec 32 501 tax lot

RECEIVED

SEP 21 2018

OWRD




RECEIVED

AUG 27 2018

OWRD

Scale

25ft

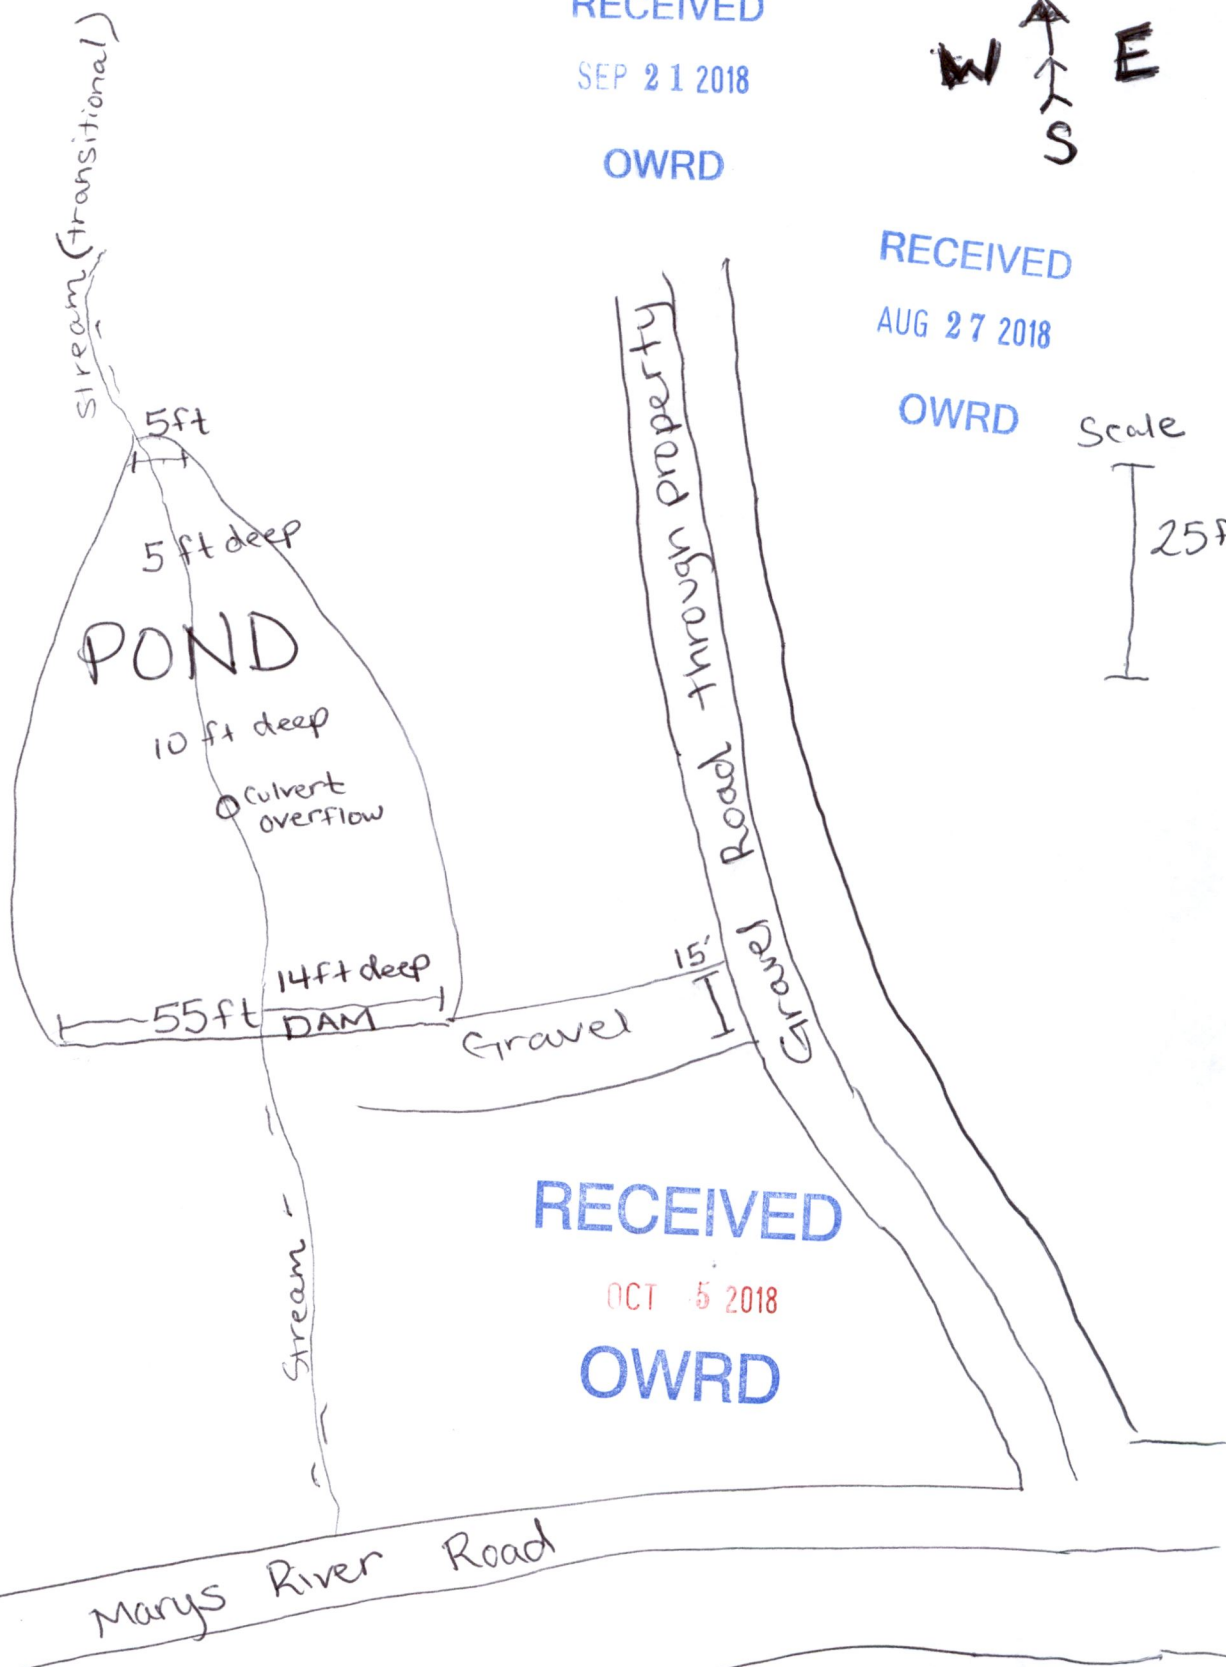

RECEIVED

OCT 5 2018

OWRD

Marys River Road

R-88673

Giovanna Gellatly
8/24/2018

RECEIVED RECEIVED

Giovanna Gellatly

1" = 1320'

Tax Lot:

Township 10 South, Range 7 West, Section 32, Tax Lot 501


OCT 5 2018

SEP 21 2018



OWRD

OWRD

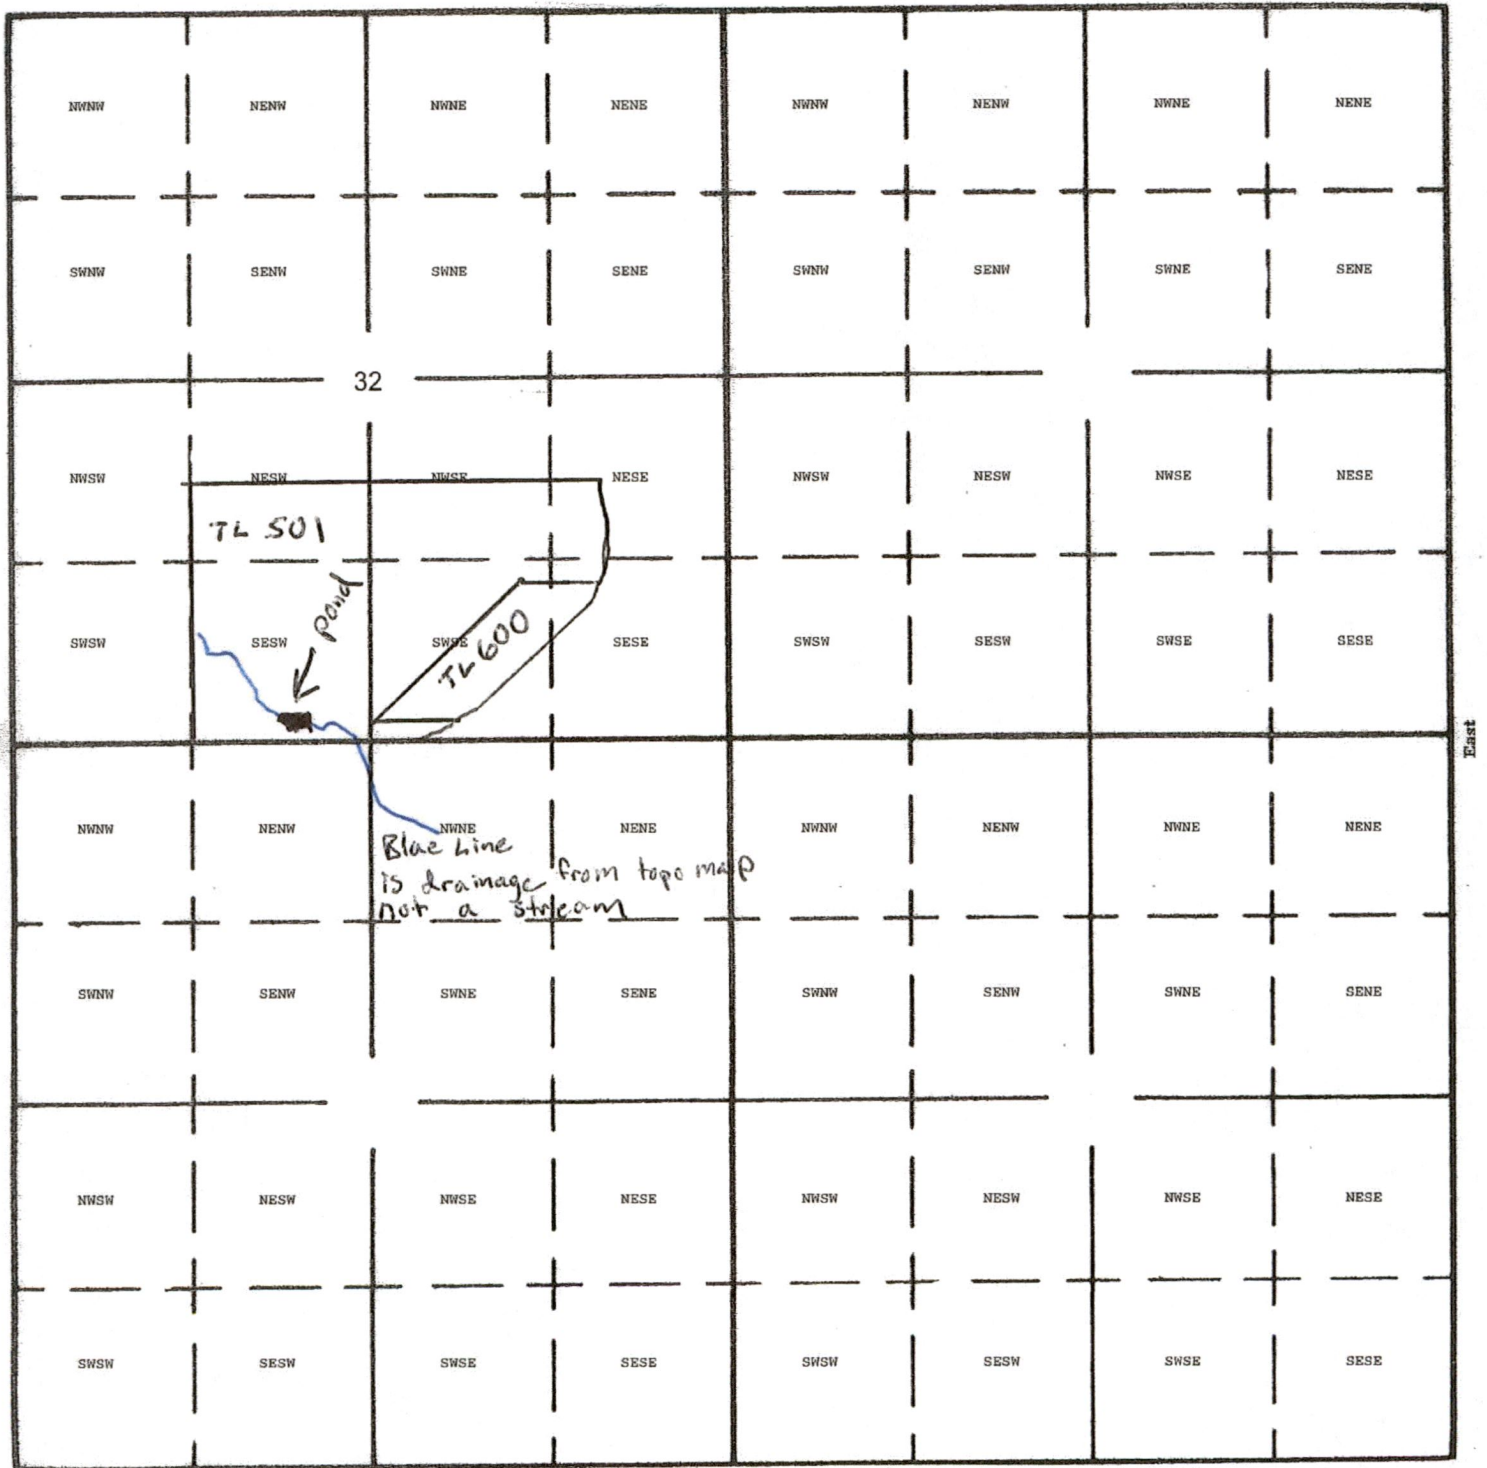

Dam Location: 160' feet North and 2150' East from SW Corner Section 32

Giovanna Gellatly
9/19/2018

R-88673

RECEIVED

SEP 21 2018

OCT 5 2018


OWRD

OWRD

10 7 32

8/24/2017
Cancelled Nos.
500

10732

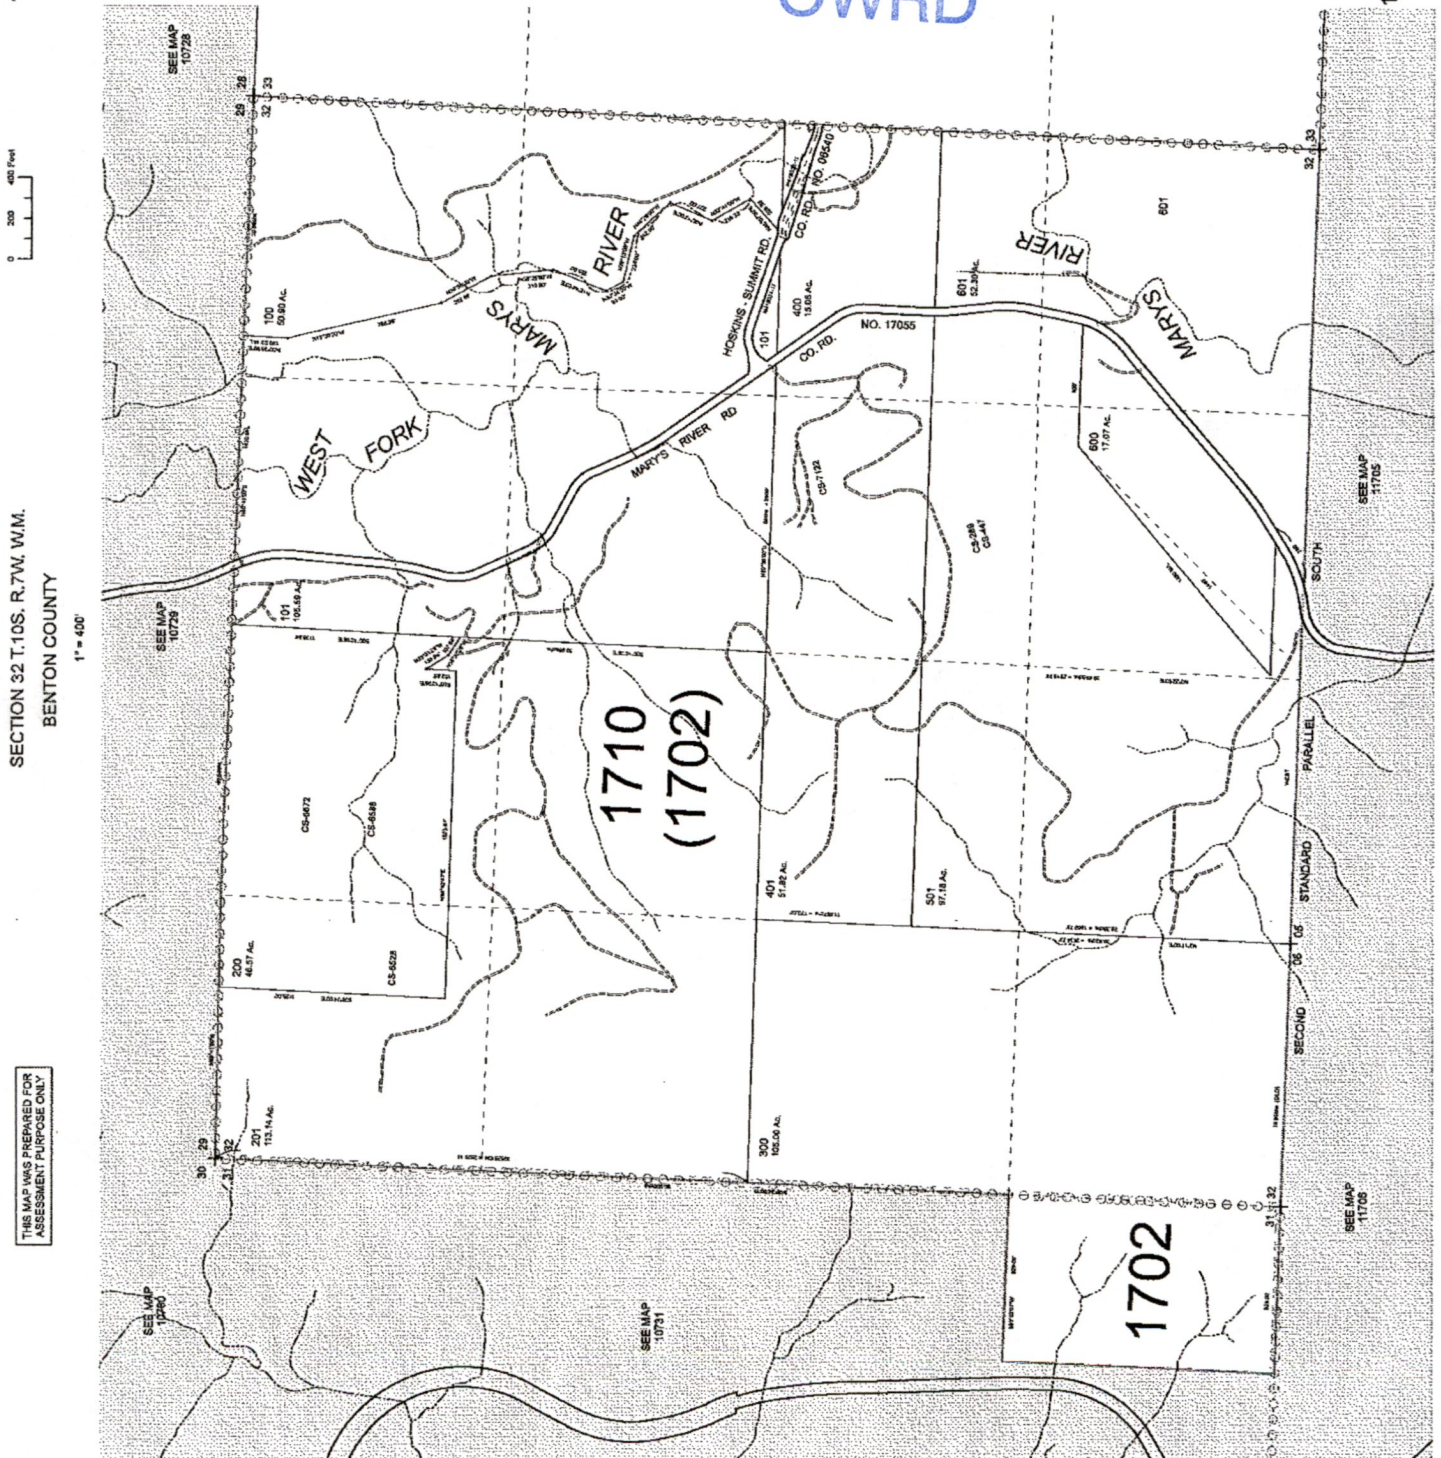

Giovanna Jellatly
9/18/2018

R-88673