


COBU MAP # 0443



FINAL PROOF SURVEY

APPLICATION NO. G-13539
PERMIT NO. G-12579
PERMIT AMENDMENT T-7762


IN THE NAME OF ALAN HEATH

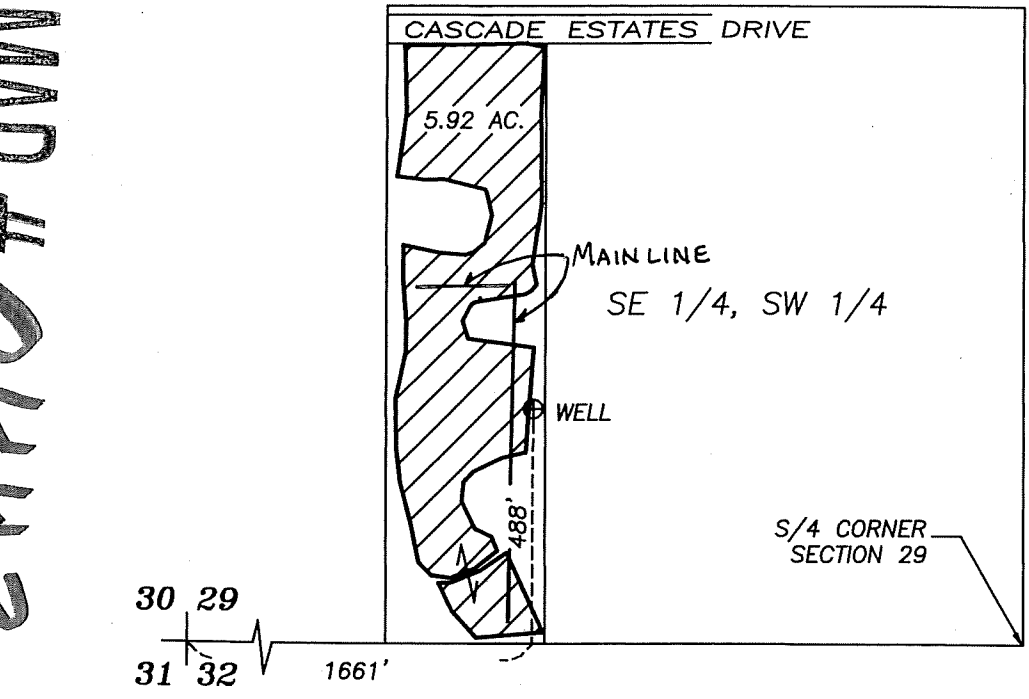

T15S, R11E, W.M.
DESCHUTES CO., OR

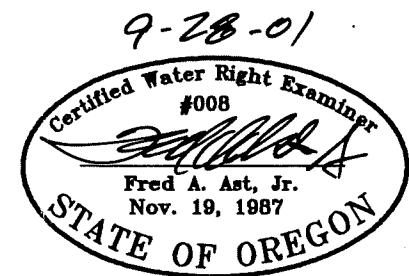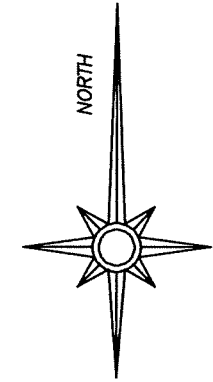

RECEIVED
OCT 01 2001
WATER RESOURCES DEPT.
SALEM, OREGON

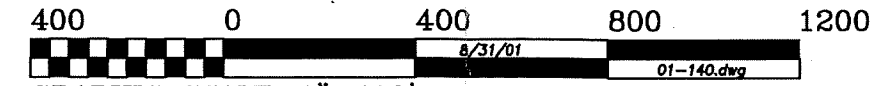

GRAPHIC SCALE: 1"=400'

THIS MAP IS FOR THE PURPOSE OF IDENTIFYING THE LOCATION OF THE WATER RIGHT.
IT IS NOT INTENDED TO PROVIDE LEGAL DIMENSIONS OR LOCATIONS OF PROPERTY OWNERSHIP LINES.