

# Claim of Beneficial Use

Application G-13539, Permit G-12579  
Deschutes County, Oregon



**RECEIVED**

JUL 16 2009

WATER RESOURCES DEPT  
SALEM, OREGON



Renewal date: 6/30/2010

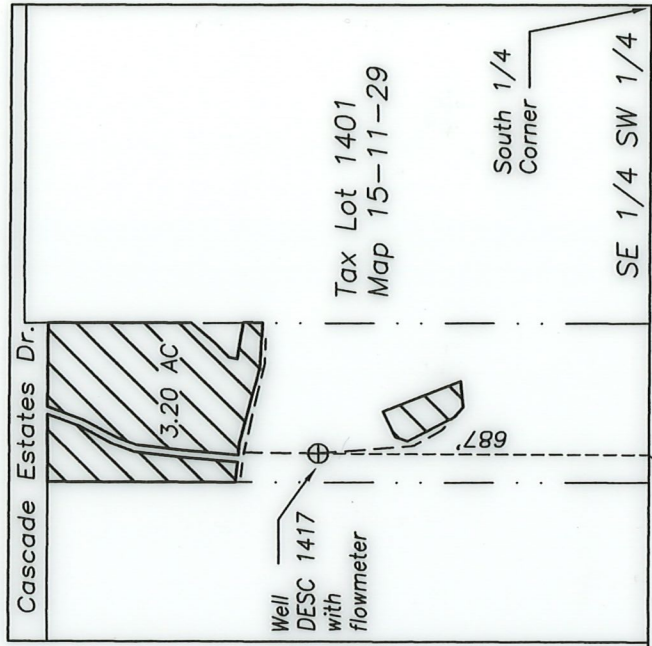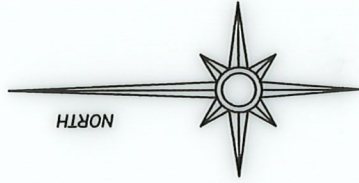

30 29  
21 32  
1718'  
T15S R11E, W.M  
Deschutes Co., Oregon

- · · — Property Line
- Mainline



Land beneficially irrigated under  
Permit G-12579, priority date  
11/1/1993.



GRAPHIC SCALE - FEET

THIS MAP IS FOR THE PURPOSE OF IDENTIFYING THE LOCATION OF THE WATER RIGHT. IT IS NOT INTENDED TO PROVIDE LEGAL DIMENSIONS OR LOCATIONS OF PROPERTY OWNERSHIP LINES.