


Sec. 35

Twp. 35 S.

R. 7 W.

W.M.

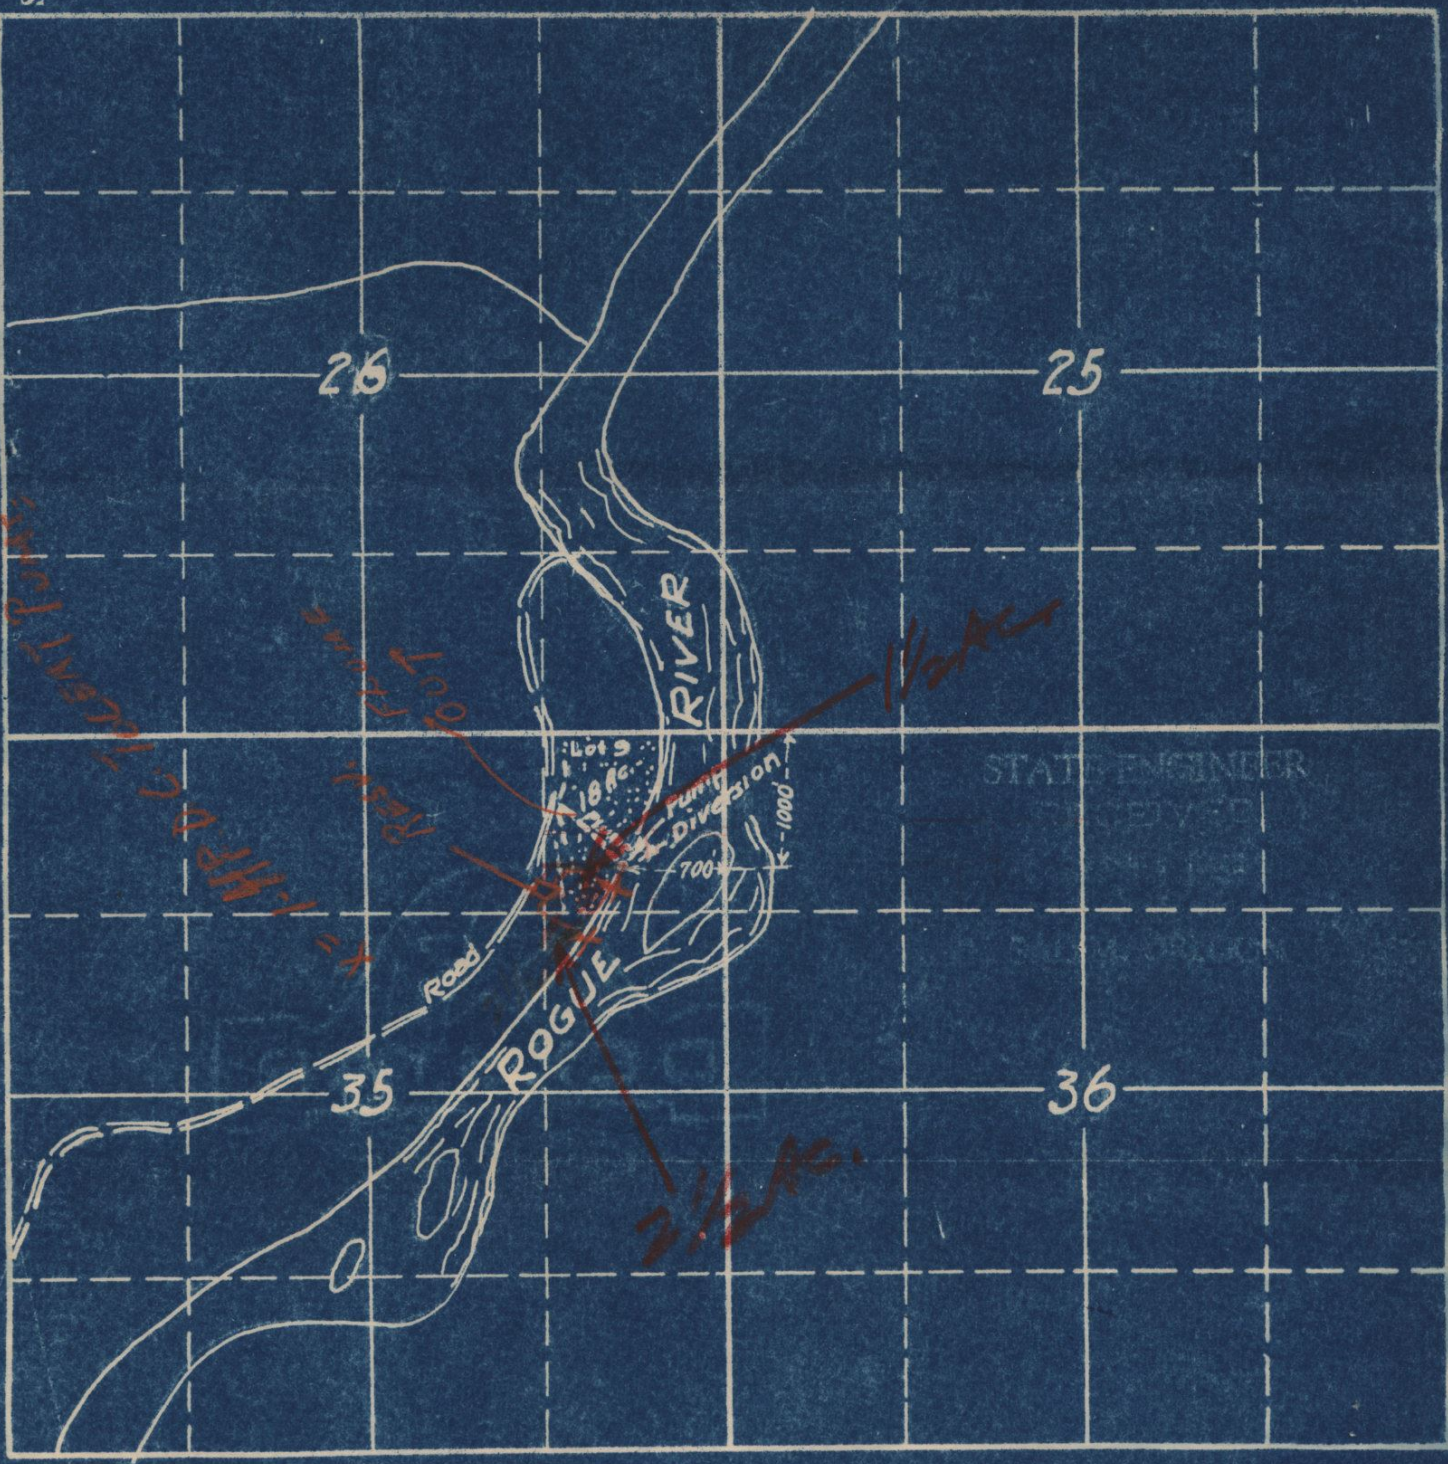

Application No. 14311  
 Permit No. 10354