


WATER RIGHT APPLICATION MAP

T.37S. R.5W. SEC. 30 W.M.

RECEIVED

NOV - 3 1994

WATER RESOURCES DEPT.
SALEM, OREGON

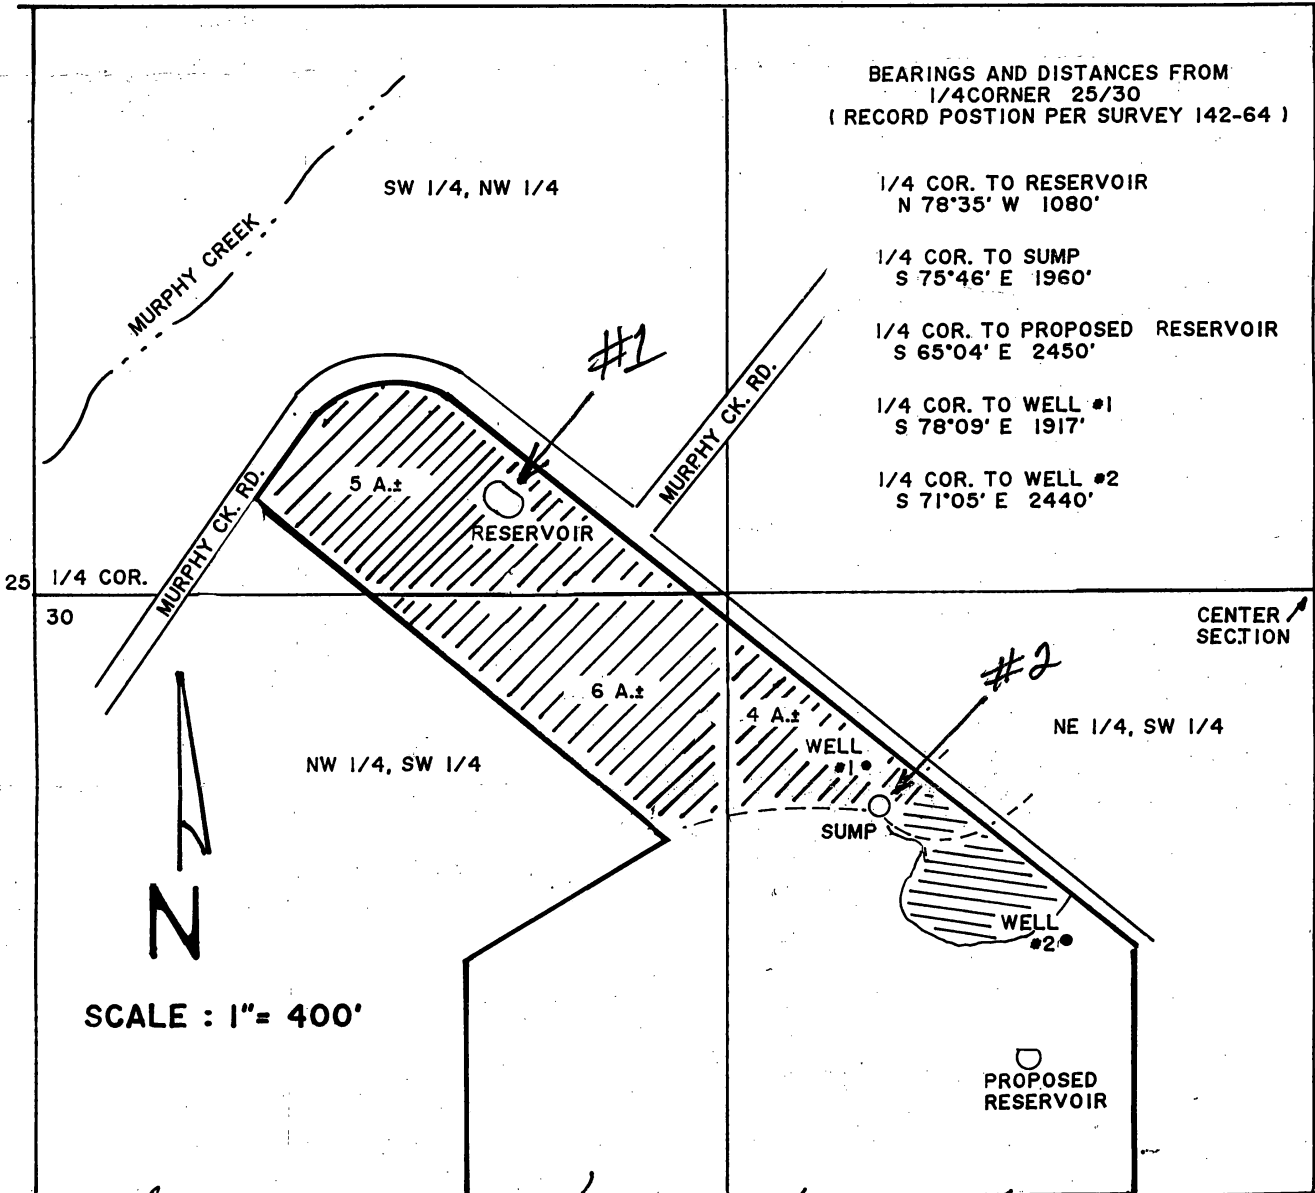

The above reservoirs #1 & #2 have been in place since 1984 when I bought the property. Martin P. Hill. 10/31/94

PREPARED FOR:
MARTIN P. HILL
700 MURPHY CREEK RD.
GRANTS PASS OR 97527
PHONE 862-2302

PREPARED BY:
JONATHAN C. SPERO W.R.E. 123
1002 KINCAID RD./P.O. BOX 16
WILLIAMS, OREGON 97544
PHONE (503) 846-6845

APPLICATION NO. P75167

PERMIT NO.