




Reservoir Map
William and Sue Cox
Section 12 T26S. R6W.
Douglas County
Scale: 1' = 400'

RECEIVED

NOV 08 2018


OWRD

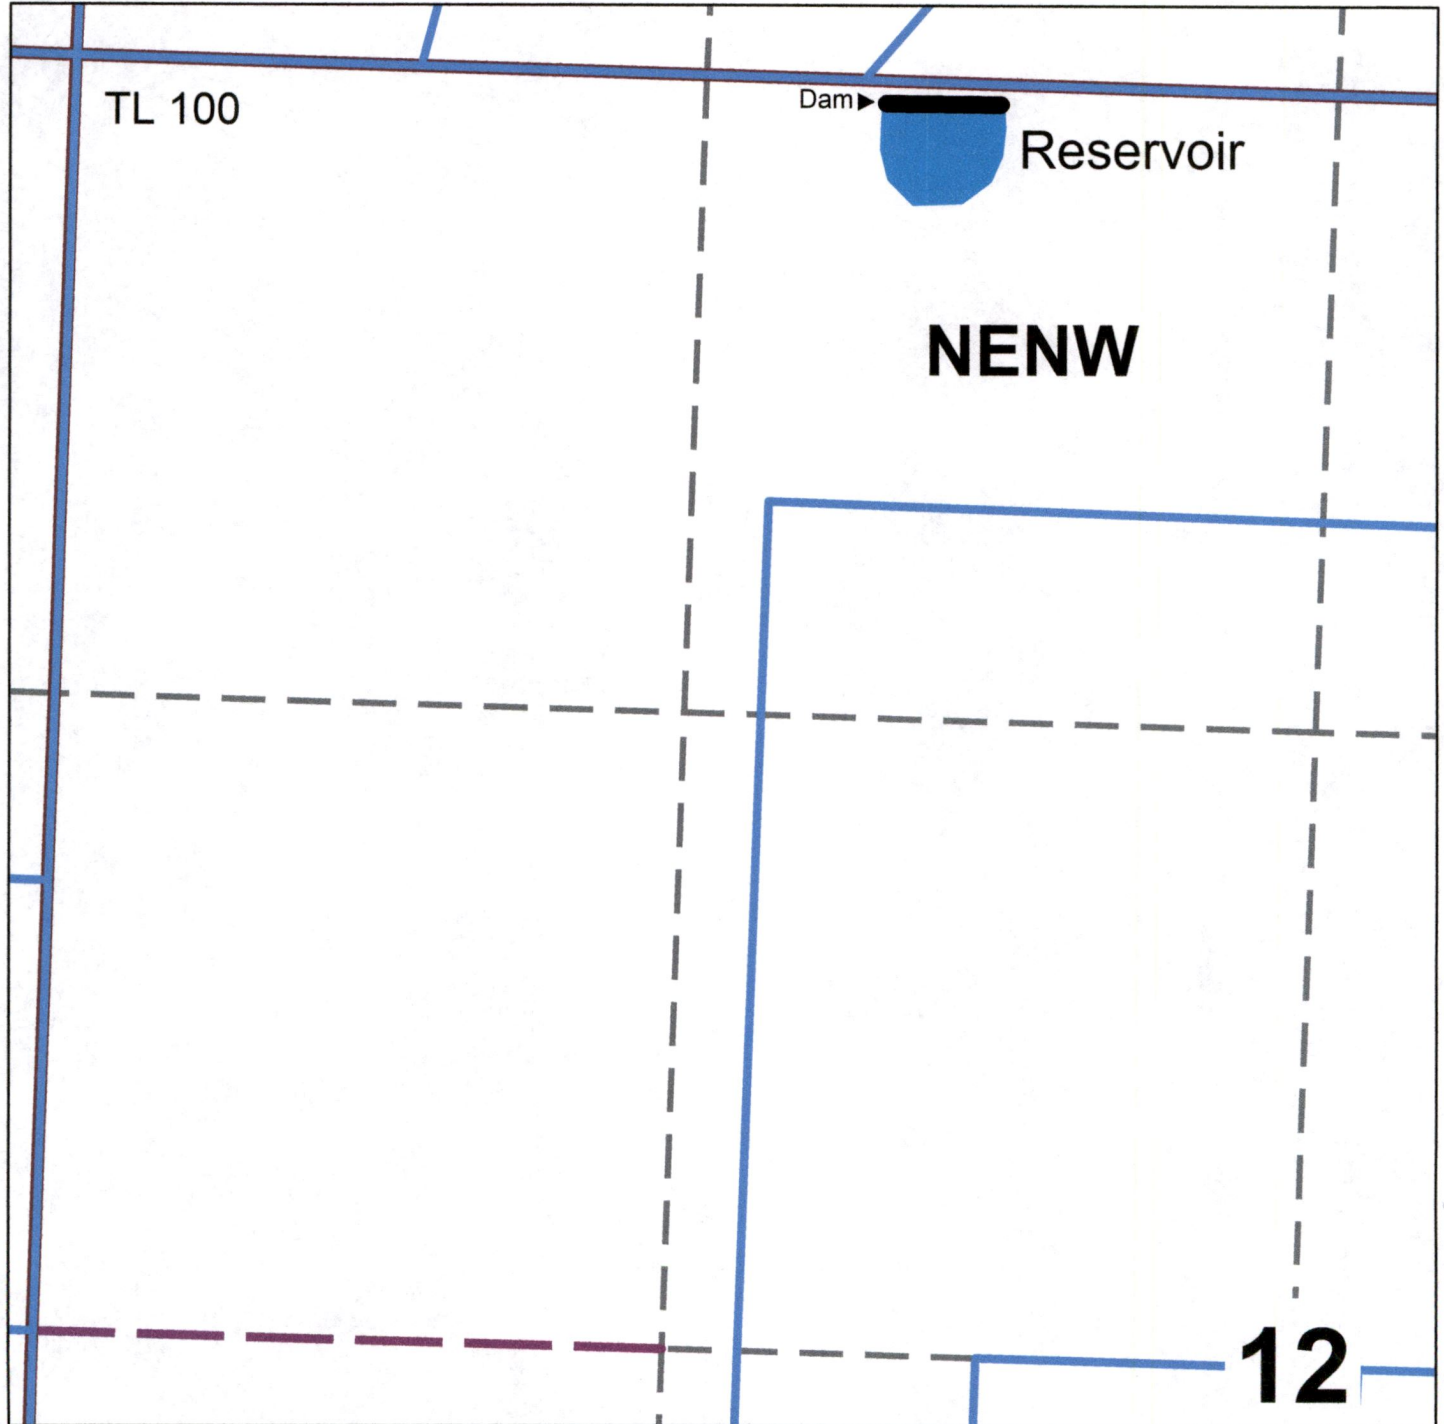

Reservoir is located 50 ft. South and 1800 ft. East from the Northwest Corner of Section 12

R-88678

If the diversion involves a dam, use this space for sketches of the diversion (e.g. cross-section of the dam with its dimensions, dimension and placement of outlet pipe, means of passing live flow outside of the authorized storage season, and means for providing fish passage).

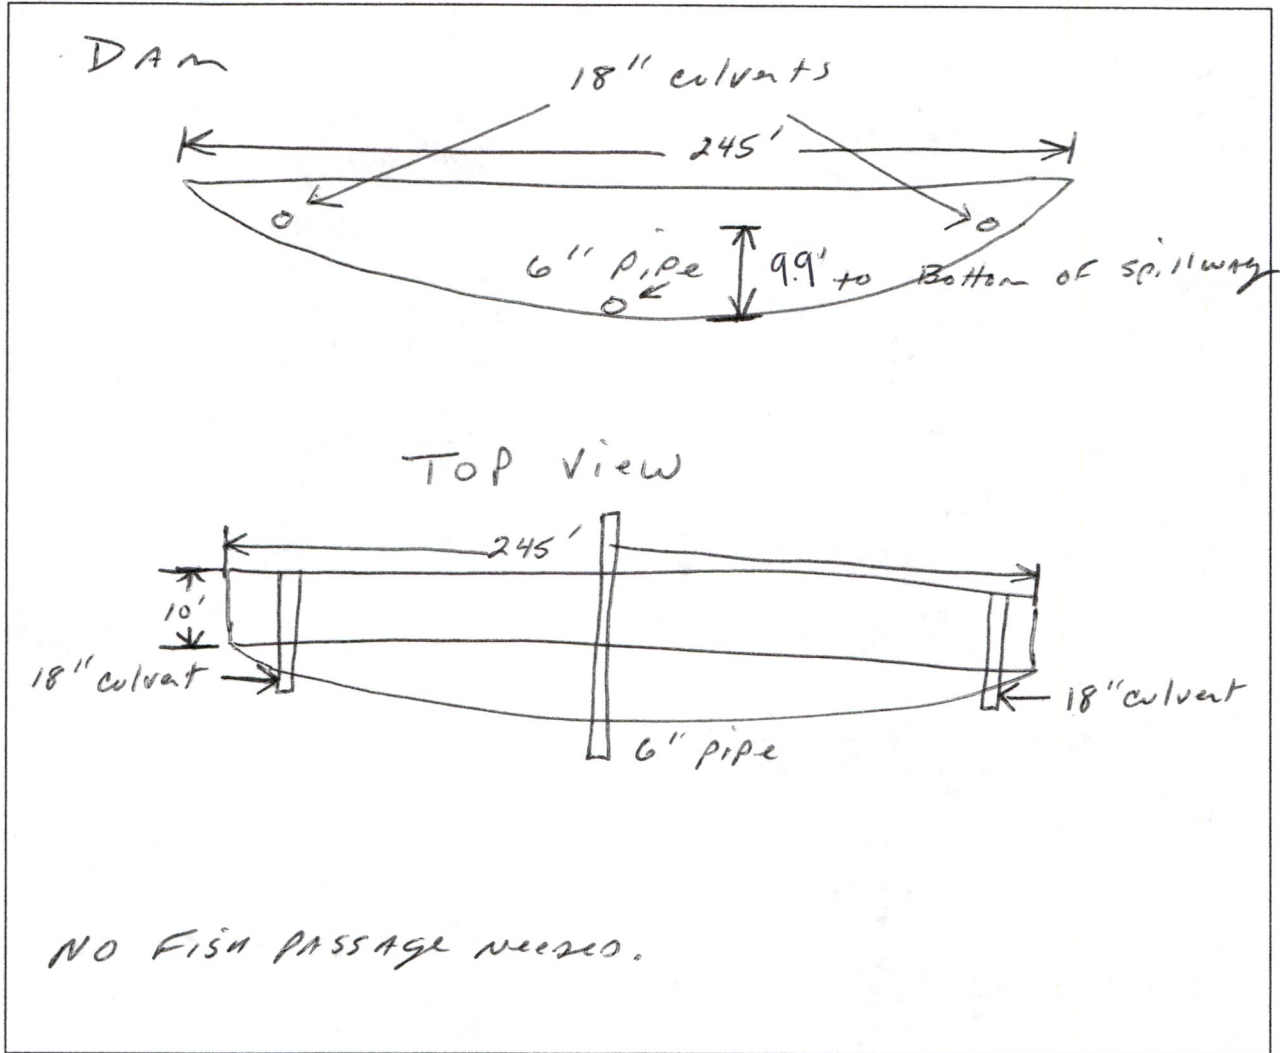

9. SIGNATURE

I swear that all statements made and information provided in this application are true and correct to the best of my knowledge.

Wm. A. Coy
William E. Coy
 Applicant Signature

10-23-18
 10-23-18
 Date

Before you submit your application be sure you have:

- Answered each question completely.
- Included a legible map that includes Township, Range, Section, quarter-quarter and tax lot number.
- The map must meet map requirements to be accepted.
- Included a land use form or receipt stub signed by a local planning official.
- Included a check payable to Oregon Water Resources Department for the appropriate amount.

RECEIVED

NOV 08 2018

OWRD