
Map

1" = 100' Scale

N

NW ¼ of Sec 15, T10S, R1W, WM

Tax Lot 201

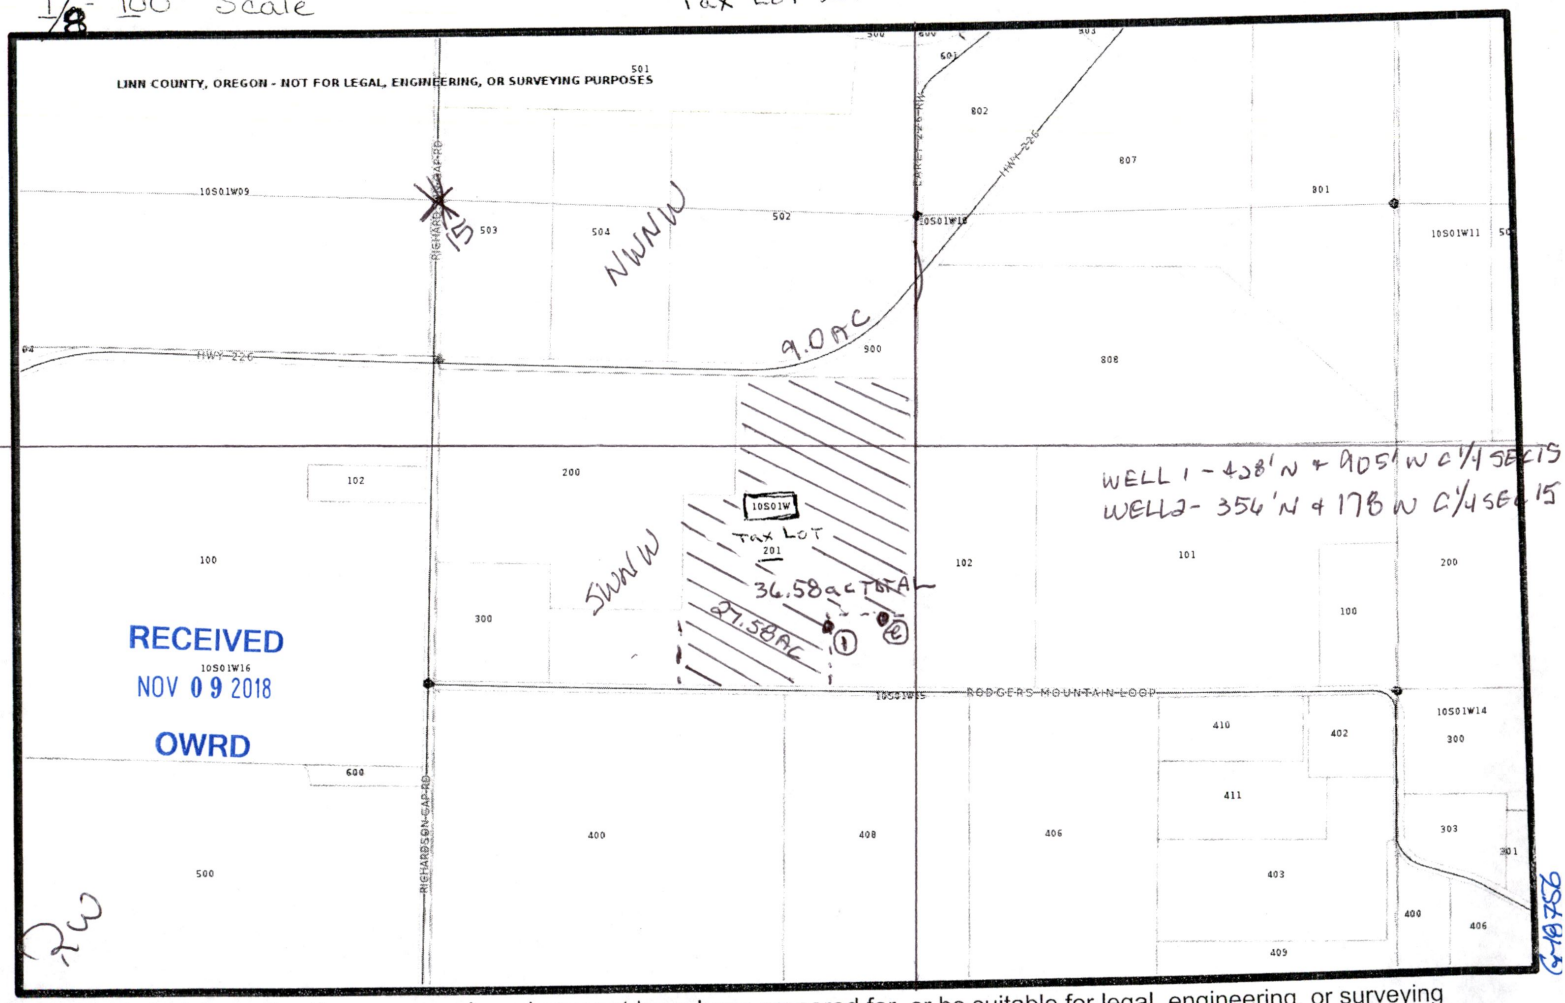

This product is for informational purposes only and may not have been prepared for, or be suitable for legal, engineering, or surveying purposes. Users of this information should review or consult the primary data and information sources to ascertain the usability of the information