Water Resources Department

M	ЕМО						نــ	JUNE	29	, 20	04		
T	0-	A	pplicati	ion G	1579	74							
FI	ROM	G	w:	THE	GAL	1							
st	JBJEC	T Sc	enic W	aterwa	y Interi	ference	Evalua	tion					
	Ye Ye	Th	e sourc	e of app	ropriati	on is wi	thin or	above a	. Scenic	Water	way		
	Ye No	Us	e the Sc	cenic Wa	aterway	conditi	on (Co	ndition '	7J).				
PR	EPONI			EVIDE									
	1	sur	face wa	nat the	propos s neces	sed use	of gro	ound wa	ater wi	ll meas	surably	nderance reduce of a sce	tha
									of Evide	nce box	is not o	checked)	
wat	terway	by the f	rmit is controlled	calculate g amour ced.	ed to recents exp	duce mo ressed a	nthly fl s a prop	ows in portion	of the c	onsum	otive us	Scen	nic
	Jan	Feb	Mar	Apr	May	Jun	Jul	Aug	Sep	Oct	Nov	Dec]
A Lake					TO SECURE AND ASSESSED.		The last of the la				The state of the s		T

PUBLIC INTEREST REVIEW FOR GROUND WATER APPLICATIONS

TO:		Water	Rights S	ection			DateJune 28, 2004								
FROM		Groun	nd Water/	Hydrology	Section	Ivan									
SUBJE	CT:		cation G-	0.5		Rev	iewer's Name persedes re	eview of	Sept	emb	er 16, 2	002 view(s)			
OAR 69 welfare, to determent the pressure.	90-310-1 safety as mine who umption	30 (1) 7 and healt ether the criteria.	The Depart th as descr e presumpt	ibed in ORS ion is establ ew is based	oresume the 5 537.525. Lished. OA upon ava	at a propos Departmen R 690-310- ilable info	t staff review 140 allows t	ater use will v ground wat he proposed l agency poli	er applicati use be mod icies in pla	ons u lified ce at	nder OA or condi	R 690-31 tioned to of evalu	meet ation.		
A1.	Applica	int(s) se	ek(s) 0.1	64 cfs fro	om2	well	(s) in the	Rogue					_ Basin		
	Constance Creek							ad Map: B	oswell Mo	untai	n				
A2. A3.	Propose Well an	ed use: <u>]</u> id aquife	Irrigation er data (at	of 13.4 acr	es, domest imber logs	tic Seas s for existin	sonality: <u>Irr</u> ng wells; ma	ig. <u>Mar 1- O</u> rk proposed	oct 31, dom	estic uch u	year-ro ınder log	und gid):			
Well	Log	id	Applican Well #		oposed quifer*	Propos Rate(c		Location /R-S QQ-Q)			, metes a				
1	JACK	3431	1	В	edrock	0.164	4 35S/0	02W-12NW	SE :	2250' N, 1200' E fr NW cor S 36 114' S, 728' E fr center S 12					
3	Propo	sed	2	В	edrock	0.164	4 35S/0	02W-12NW	SE :	E 382' S, 278' E fr center S					
4						13 4			A				ian ²		
5												111	ROSA		
* Alluviu	ım, CRB,	Bedrock	ζ												
Well	Well Elev	First Water ft bls	ft ble	SWL Date	Well Depth (ft)	Seal Interval (ft)	Casing Intervals (ft)	Liner Intervals (ft)	Perforation Or Scree (ft)		Well Yield (gpm)	Draw Down (ft)	Test Type		
1	ft msl 1430	37	8	1-29-77	82	0-19	0-20	na	na		100	74	Air		
2	1440	na	na	na	na	na	na	na	na		na	na			
				Transaction of the second											
Use data A4.			for proposed	d wells.	has not be	een drilled.									
											-4-				
										+			en de la companya de		
A5. 🛛	manage (Not all	ment of basin r	ground w	ater hydraul in such prov	ically contrisions.)	nected to su	rface water	ules relative	are not,	lopme activa	ent, class ated by th	ification iis applic	and/or ation.		
		4	£1												
A6. 🗌	Name o	of admir	istrative a	rea:				np(s) an aquit					striction		
	Comme	ents:								9					
	1200									1	6				

Appli	cation	G1579	4	continued	Date	June 28, 2004
P C	DOUN	JD WATED	AVAILAE	BILITY CONSIDERATION	S OAR 690-310-130 400-	010 410-0070
Б. <u>G</u>	KOUI	ND WATER	AVAILAL	ILITI CONSIDERATION	5, OAK 090-310-130, 400-	010, 410-0070
B1.	Bas	sed upon avai	lable data, I	have determined that ground war	ter* for the proposed use:	
	a.	period of	f the propose	is not over appropriated, or d use. * This finding is limited cribed in OAR 690-310-130;	annot be determined to be to the ground water portion of t	e over appropriated during any he over-appropriation
	b.			ikely be available in the amounts ound water portion of the injur		
	c.	☐ will not	or 🗌 will l	ikely to be available within the c	apacity of the ground water res	ource; or
	d.	i. 🖂	The permit s	ditioned, avoid injury to existing should contain condition #(s)should be conditioned as indicate	7B, 7C, 7F, 7J,	ground water resource:
				should contain special condition(
B2.	a.	☐ Conditi	on to allow g	ground water production from no	deeper than	_ ft. below land surface;
	b.	☐ Conditi	on to allow g	ground water production from no	shallower than	_ ft. below land surface;
	c.	Condition water res	on to allow g servoir betwe	round water production only from een approximately ft	n the ft. below lar	ground d surface;
	d.	occur wi issuance Water Se	th this use ar of the permi ection.	is necessary to accomplish one of ad without reconstructing are cite t until evidence of well reconstructions.	d below. Without reconstruction is filed with the Department	on, I recommend withholding ent and approved by the Ground
		senior water	er rights, not	within the capacity of the resource	ce, etc):	
B3.		ound water a		emarks: * Require applicant	to install and maintain a proj	perly functioning, totalizing
				upper Eocene siltstone, mudstor	ne, sandstone, conglomerate, an	d coal of the Payne Cliffs
				e river deposited with the prover		
				ternary alluvium. The subject we Well logs in the vicinity of the su		
				encountered in fractures ranging		to bedrock is approximately 2
				37 Well logs with yields of 5 g		d: 110 gpm
				ss than or equal to 100 feet, 3 we		
				nings occurred, three in the mid-1		alumin .
				rea appears to be good for dome lowever, sustainable well yields a		
				ed on general knowledge of the a		
				ring summer months and following		
Water	rlevel	data from JAC	CK 3423 (Bei	nson Well, 35S/2W-12abd1) are	available for this area from app	proximately 1989 to
1995.	The d	lata show seas	onal fluctuat	ions of approximately 40 to nearl	y 100 feet, and no long-term de	ecline. This well is
205 fe				162 feet bgs, and a reported yield		
	Ma	ry Blandau (a)	pplication G	-15943) conducted an aquifer tes	t, indicating the hydraulic conn	ection of her well with
	nei	ghboring wells	s, over the sh	the conceptualization of a pervas ort-term of the test, was not subs		
	the	course of an i	rrigation seas	son.		
	100					

C. GROUND WATER/SURFACE WATER CONSIDERATIONS, OAR 690-09-040

C1. **690-09-040** (1): Evaluation of aquifer confinement:

Well	Aquifer or Proposed Aquifer	Confined	Unconfined
1	Fractured bedrock		
2	Fractured bedrock		

Basis for aquifer confinement evaluation: Well yields in area are generally good, suggesting the aquifer is pervasively	
fractured. Although the aquifer is likely more confined with depth, the water-bearing zones of the applicant's wells are fairly	
shallow and likely more unconfined than confined.	
그는 이번에 하나는 것이 하다면서 가는 것이 되는 것이라고 하는 생각이 하는 것이다.	
	4
	_

C2. **690-09-040** (2) (3): Evaluation of distance to, and hydraulic connection with, surface water sources. All wells located a horizontal distance less than ¼ mile from a surface water source that produce water from an unconfined aquifer shall be assumed to be hydraulically connected to the surface water source. Include in this table any streams located beyond one mile that are evaluated for PSI.

Well	SW #	Surface Water Name	GW Elev ft msl	SW Elev ft msl	Distance (ft)	Hydraulically Connected? YES NO ASSUMED	Potential for Subst. Interfer. Assumed? YES NO
1	1	Constance Creek	1422	1420	200		
2	1	Constance Creek	na	1420	700		
					#5 E		
64-							

Basis for aquifer hydraulic connection evaluation: Surface water flow evaluation by staff during 2003-2004 indicated
Constance Cr flows dominated by precipitation, with very little, if any, groundwater contribution. Groundwater likely
discharges to Rogue River, located approx. 11,000 feet east of the site. Given distance and low primary permeability of aquifer
material, and discontinuity of formations, hydraulic connection with the Rogue was not evaluated.

Water Availability Basin the well(s) are located within: Rogue River above Curry Gage 14359000 (#270)

C3a. 690-040 (4): Evaluation of stream impacts for each well that has been determined or assumed to be hydraulically connected and less than 1 mile from a surface water source. Limit evaluation to instream rights and minimum stream flows that are pertinent to that surface water source, and not lower SW sources to which the stream under evaluation is tributary. Compare the requested rate against the 1% of 80% natural flow for the pertinent Water Availability Basin (WAB). If Q is not distributed by well, use full rate for each well. Any checked box indicates the well is assumed to have the potential to cause PSI.

Well	SW #	Well < ¼ mile?	Qw > 5 cfs?	Instream Water Right ID	Instream Water Right Q (cfs)	Qw > 1% ISWR?	80% Natural Flow (cfs)	Qw > 1% of 80% Natural Flow?	Interference @ 30 days (%)	Potential for Subst. Interfer. Assumed?
				3.3						

Date	June 28,	2004

C3b. 690-09-040 (4): Evaluation of stream impacts by total appropriation for all wells determined or assumed to be hydraulically connected and less than 1 mile from a surface water source. Complete only if Q is distributed among wells. Otherwise same evaluation and limitations apply as in C3a above.

	SW #	Qw > 5 cfs?	Instream Water Right ID	Instream Water Right Q (cfs)	Qw > 1% ISWR?	80% Natural Flow (cfs)	Qw > 1% of 80% Natural Flow?	Interference @ 30 days (%)	Potential for Subst. Interfer. Assumed?
			1	,		,			
				- 8					
Comm	ents:								

C4a. **690-09-040 (5):** Estimated impacts on **hydraulically connected surface water sources greater than one mile** as a percentage of the proposed pumping rate. Limit evaluation to the effects that will occur up to one year after pumping begins. This table encompasses the considerations required by 09-040 (5)(a), (b), (c) and (d), which are not included on this form. Use additional sheets if calculated flows from more than one WAB are required.

	istributed	Wells											
Well	SW#	Jan	Feb	Mar	Apr	May	Jun	Jul	Aug	Sep	Oct	Nov	Dec
		%	%	%	%	%	%	%	%	%	%	%	%
Well Q	as CFS							,					do T
Interfere	ence CFS				lu .								
Dietrib	outed Well	c											
Well	SW#	Jan	Feb	Mar	Apr	May	Jun	Jul	Aug	Sep	Oct	Nov	Dec
., сп	J .,	%	%	%	%	%	%	%	%	%	%	%	%
Well Q	as CFS												
	ence CFS												
- 7		%	%	%	%	%	%	%	%	%	%	%	%
Well Q	as CFS				39								1 - 4
	ence CFS											The state of the s	
		%	%	%	%	%	%	%	%	%	%	%	%
Well Q	as CFS							9 1			10 1 41		
Interfere	ence CFS												
		%	%	%	%	%	%	%	%	%	%	%	%
Well Q	as CFS												Her.
Interfere	ence CFS		4 /										
		%	%	%	%	%	%	%	%	%	%	%	%
Well Q	as CFS						-						
Interfere	ence CFS				19.								
(A) = To	tal Interf.												
,	% Nat. Q								100				
-	% Nat. Q												
$(\mathbf{D}) = (\mathbf{A}$		i sh	岭	pÅ.	A	is A	Š	A	s ^A	À	jė,	A	pÅ.
$(\mathbf{E}) = (\mathbf{A}$	/B) x 100	%	%	%	%	%	%	%	%	%	%	%	%


(A) = total interference as CFS; (B) = WAB calculated natural flow at 80% exceed. as CFS; (C) = 1% of calculated natural flow at 80% exceed. as CFS; (D) = highlight the checkmark for each month where (A) is greater than (C); (E) = total interference divided by 80% flow as percentage.

lication <u>G-15794</u> continued	Date	June 28, 2004
Paris for inverse and applications		
Basis for impact evaluation:		
	5p 5- 5	
690-09-040 (5) (b) The potential to impair or detriment Rights Section.	ally affect the public interest is to be d	letermined by the Wa
 ✓ If properly conditioned, the surface water source(s) can be under this permit can be regulated if it is found to substantia i. ✓ The permit should contain condition #(s) 	lly interfere with surface water:	and/or ground water u
ii. The permit should contain special condition(s) a	as indicated in "Remarks" below;	
in Z The permit should contain special containence)	,,,,,,,,,,,	
SW / GW Remarks and Conditions ** Require applican	t to install and maintain a properly fu	inctioning, totalizing
meter on each POA.		
See file for staff report on Constance Creek flows. Constance Cr	reek appears to gain little, if any, baseflo	w from groundwater
discharge, and is dry during the summer months. The Rogue Riv	ver is likely the regional groundwater dis	scharge point for this
equifer, and this is the likely location of any impact to surface wa		
mpact, no evaluation was conducted to assess impact to river flo	w from the applicant's groundwater use.	•
References Used: <u>USGS Boswell Mtn., Oregon 1:24,000 qu</u>		
Wiley, T.J., and F.R. Hladky, 1991. Geology and Mineral Resources.		drangle, Jackson Cour
Oregon. Oregon Dept. of Geology and Mineral Industries, GMS	:-/U.	
Water Street Str		

App	olication G-15/94 continued	Date	June 28, 2004
	AND A GONGED VICTORY OF B (00 400		
D. <u>V</u>	WELL CONSTRUCTION, OAR 690-200		
D1.	Well #: Logid:		
D2.	THE WELL does not meet current well construction	standards based upon:	
	a. review of the well log;	*	
	b. ifield inspection by		
	c. report of CWRE		
	d. other: (specify)		
D3.	THE WELL construction deficiency:		
D3.	a. Constitutes a health threat under Division 200 r	iles:	
	b. commingles water from more than one ground		
		water reservoir,	
		water recervoirs	
	d. permits the de-watering of one or more grounde. other: (specify)		
	c		
D4.	THE WELL construction deficiency is described as f	ollows:	
D4.	THE WELL construction deficiency is described as i		
D5.	THE WELL a. was, or was not constru	cted according to the standards in effect at	the time of
	original construction or mos		
	이렇게 많은 경우를 다고 하셨다면서 하셨다.		
	b. I don't know if it met stand	ards at the time of construction.	
D6.		sholding issuance of the permit until eviden	nce of well reconstruction
	is filed with the Department and approved by the Enforce	ement Section and the Ground Water Sect	ion.
TH	IIS SECTION TO BE COMPLETED BY ENFORCE	EMENT PERSONNEL	
D7	. Well construction deficiency has been corrected by the	following actions:	
D/.	. Well construction deficiency has been corrected by the	ollowing actions.	
		1979	
			200
	(Enforcement Section Signature)		, 200
	(Emorement Section Signature)		
D8.	. Route to Water Rights Section (attach well reconstr	uction logs to this page).	
_			

35S - 02W - 12NWSE Taxlot 411
Ron and Jacqueline Decker 6-15794
Boswell Mountain Quad
Scale 1:24,000



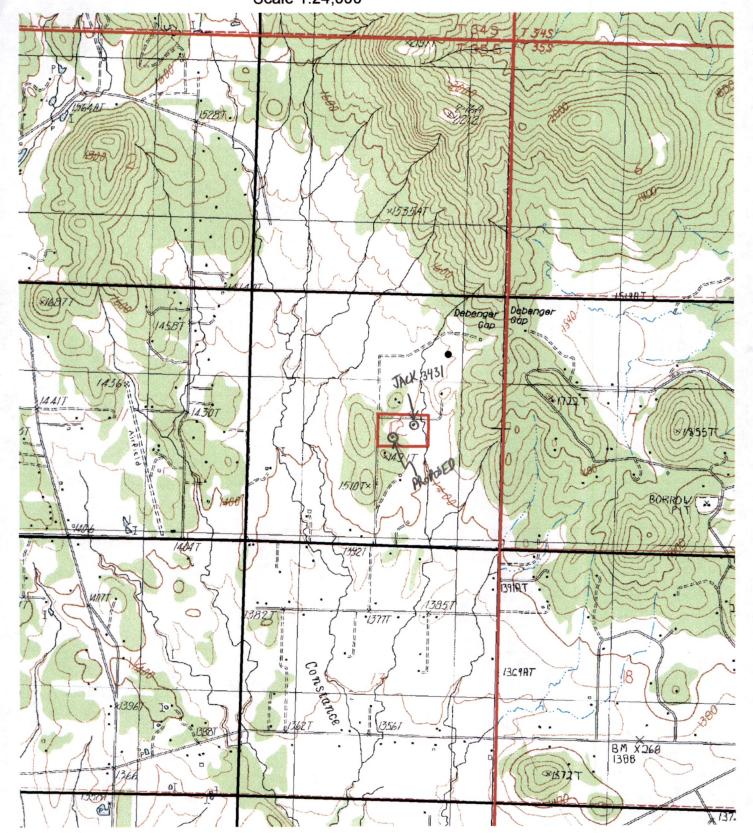

NOTICE TO WATER WELL CONTRACTOR The original and first copy of this report are to be filed with the

STATE ENGINEER, SALEM, OREGON 97310 within 30 days from the date of well completion.

WATER WELL REPORT E IVED

(Please type or print) FEB 41977


State Permit No. ...

(Do not write above this line) RESOURCES DEPT. (10) LOCATION OF WELL: (1) OWNER: Driller's well number ANDY MULLIA T355 R. QU 1456 14 Section /2 Bearing and distance from section or subdivision corner (2) TYPE OF WORK (check): 1400 N CORNER Abandon Deepening Reconditioning New Well If abandonment, describe material and procedure in Item 12, (11) WATER LEVEL: Completed well. (4) PROPOSED USE (check): (3) TYPE OF WELL: Depth at which water was first found Rotary Driven 🗆 ft. below land surface. Date /- 29-77 Domestic Industrial | Municipal | Static level Jetted [Cable Irrigation

Test Well
Other Bored Artesian pressure lbs. per square inch. Date CASING INSTALLED: Threaded | Welded (12) WELL LOG: Diameter of well below casing ... 6 ..." Diam. from O ft. to 30 ft. Gage 250 Depth drilled ft. Depth of completed well " Diam. from ft. Gage Formation: Describe color, texture, grain size and structure of materials; ft. toft. Gage " Diam. from and show thickness and nature of each stratum and aquifer penetrated, with at least one entry for each change of formation. Report each change in position of Static Water Level and indicate principal water-bearing strata. PERFORATIONS: Perforated? | Yes X No. MATERIAL. From Type of perforator used Size of perforations LAYSTONE, BLUE ... perforations from ft. to perforations from ft. perforations from (7) SCREENS: 09 Well screen installed?

Yes No Manufacturer's Name ... WATER RESOURCES DEPT Model No. .. SALEM, OREGON Diam. Slot size Set from ft. to ... Diam. Slot size Şet from Drawdown is amount water level is lowered below static level JUN 2 7 2002 (8) WELL TESTS: Was a pump test made? Tyes Yes No If yes, by whom? WATER RESOURCES DER ft. drawdown after hrs. SALEM, OREGON gal./min. with gal./min. with 74 hrs. Artesian flow g.p.m. Work started 1-29 1977 Completed 197 Depth artesian flow encountered .. perature of water Date well drilling machine moved off of well 197 (9) CONSTRUCTION Drilling Machine Operator's Certification: Well seal-Material used TRESSUPE This well was constructed under my direct supervision. Materials used and information reported above are true to my best knowledge and delief Well sealed from land surface to . Diameter of well bore to bottom of seal ... [Signed] Consla Diameter of well bore below seal Number of sacks of cement used in well seal sacks Drilling Machine Operator's License No. Number of sacks of bentonite used in well seal ... Brand name of bentonite Water Well Contractor's Certification: Number of pounds of bentonite per im gallons This well was drilled under my jurisdiction and this report is lbs./100 gals. true to the best of my knowledge and belief. Name MARTINSON WEL Was a drive shoe used?

Yes No Plugs Size: location ft. Did any strata contain unusable water? Q Yes X No depth of strata Type of water? Method of sealing strata off Size of gravel: Was well gravel packed? Yes X No Contractor's License No. Gravel placed from

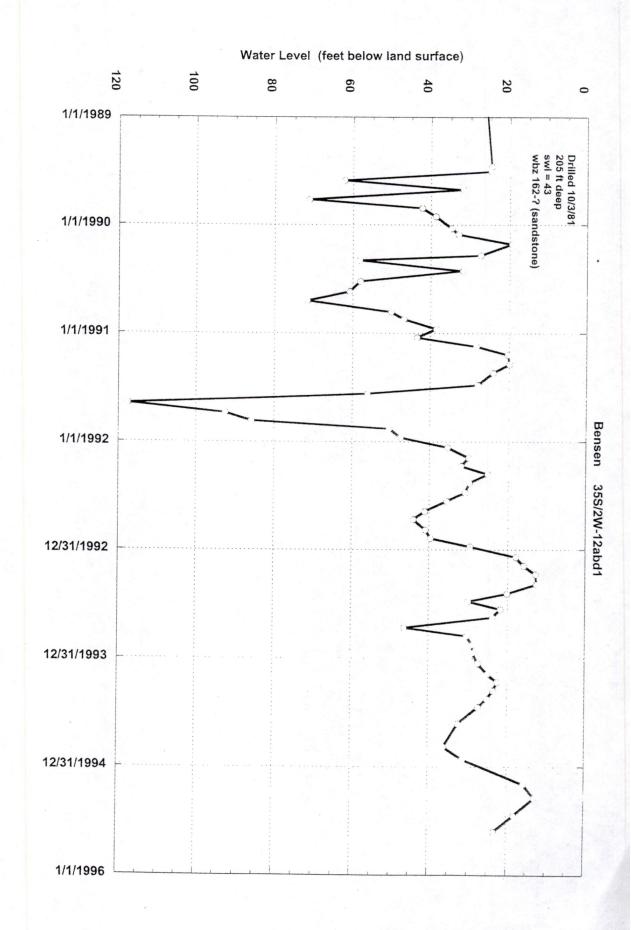

/ATER WELL REPORT STATE OF OREGON

RECEINED 355 Qw-129d OCT 20 1981 State Permit No. WATER RESOURCES DEPT

SALT ! OREGON

(1) OWNER:	(10) LOCATION OF WELL:			
Name Mary Benson	County Jackson Driller's well	number	108	
Address 4278 Beagle Rd.	SE 4 NE 4 Section 12 T. 35	R. 2N		W.M.
City Central Point, Oregon State 97502	Tax Lot # 100 Lot Blk	Sub	division	
(2) TYPE OF WORK (check):	Address at well location: Same as 1			
New Well X Deepening □ Reconditioning □ Abandon □				
If abandonment, describe material and procedure in Item 12.	(11) WATER LEVEL: Completed w	ell.		
	Depth at which water was first found 162 ft.			
(3) TYPE OF WELL: (4) PROPOSED USE (check):	Static level 43 ft. below land surface. Date 10-3-81			
l Air G Driven Domestic Industrial Municipal L., Mud Dug Irrigation X Test Well Other	Artesian pressure lbs. per square inch. Date (12) WELL LOG: Diameter of well below casing 8			
Lame Mud Dug Irrigation X Test Well Other Cable Bored Thermal: Withdrawal Reinjection				
(E) CACINIC INCOMALLED	Depth drilled 205 ft. Depth of			
(5) CASING INSTALLED: Steel K Plastic Welded K Welded K	Formation: Describe color, texture, grain size and structure of materials; and show			
"Diam from 0 ft. to 40 ft. Gauge 250	thickness and nature of each stratum and aquifer pene	trated, with	at least one	entry
"Diam. from	for each change of formation. Report each change in and indicate principal water-bearing strata.	position of a	Static Water	Level
LINER INSTALLED:	MATERIAL	From	To SV	
	soil brown	0	1	WL
(4) DEDUCA	claystone brown	1	15	
(6) PERFORATIONS: Perforated? □ Yestal No	sandstone brown	15	26	
Type of perforator used	claystone gray	26	50	
Size of perforations in. by in.	sandstone gray		205 4	3
perforations from		-		
perforations from				
perforations from ft. to ft.				
(7) SCREENS: Well screen installed? TYes ONO				
Manufacturer's Name			7.52	-
Type				
Diam. Slot Size Set from ft. to ft.				
Diam. Slot Size				
WELL TESTS: Drawdown is amount water level is lowered below static level				
Was a pump test made? ☐ Yes ☐XNo If yes, by whom?				
Yield: gal/min with ft. drawdown after hrs.				
		-		
Air test 110 gal./min. with drill stem at 205 ft. $1\frac{1}{2}$ hrs.		-	-	
r test gal./min. with ft. drawdown after hrs.				
Artesian flow g.p.m.				-
Temperature of water 56 Depth artesian flow encountered ft.	Work started 10-1 19 81 Complete	. 10	2	04
(9) CONSTRUCTION: Special standards: Yes □ No ☒	Work started 10-1 19 01 Complete Date well drilling machine moved off of well	10-		981
Well seal—Material usedC.ement		10.	-) 1	981
Well sealed from land surface to	Drilling Machine Operator's Certification: This well was constructed under my direct supervision. Materials used			
Diameter of well bore to bottom of seal12 in.	and information reported above are true to my b	apervision est knowle	i. Materials	used
Diameter of well bore below seal	[Signed] Miller Mel Round	Date	10-5 19	81
Number of sacks of cement used in well seal	[Signed] Date 10-5, 19.81.			
How was cement grout placed?pressure pumped	Drilling Machine Operator's License No483			
	Water Well Contractor's Certification:			
	This well was drilled under my jurisdiction and this report is true to			
Was pump installed? Type HP Depth ft.	the best of my knowledge and belief.			
Was a drive shoe used? ☐ Yes ☐ No ☐ Plugs Size: location ft.	Name Gribble Well Drilling (Type or print)			
Did any strata contain unusable water?Yes	Address 195 Country Lane Gold H	III, Ore	egon 97	525
Type of Water? depth of strata	[Signed]			7
Method of sealing strata off Was well gravel packed? □ Yes 돈 No Size of gravel:	(Water Well Contracto	or)	••••••	
Gravel placed fromft. toft.	Contractor's License No705Date	105.	, 19	.81.