


T.4N.R.28E.W.M.

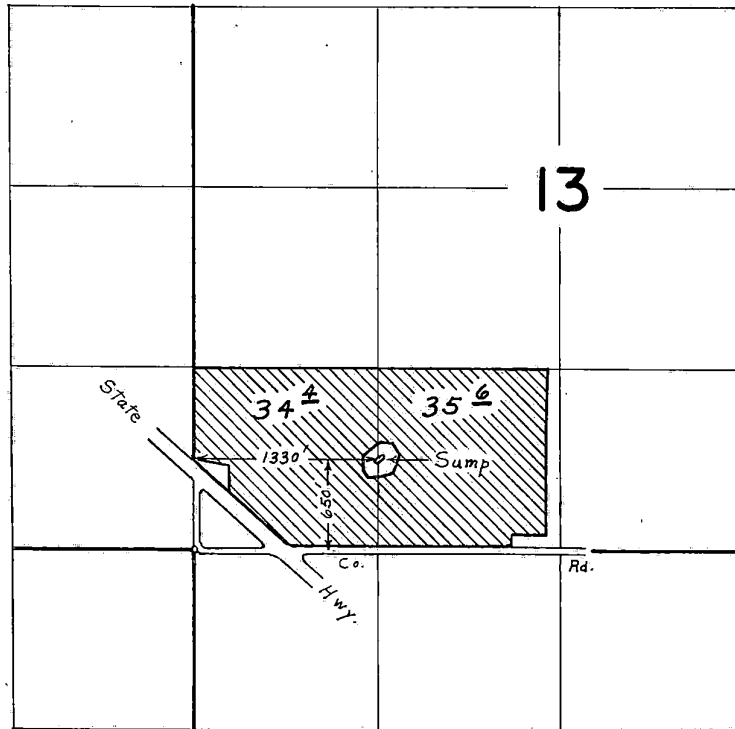

FINAL PROOF SURVEY
UNDER

Application No. G-3161 Permit No. G-2974
IN NAME OF
THOMAS N. ABLE, JR.

Surveyed June 27, 1967, by L. E. Gould