


OWYHEE IRRIGATION DISTRICT

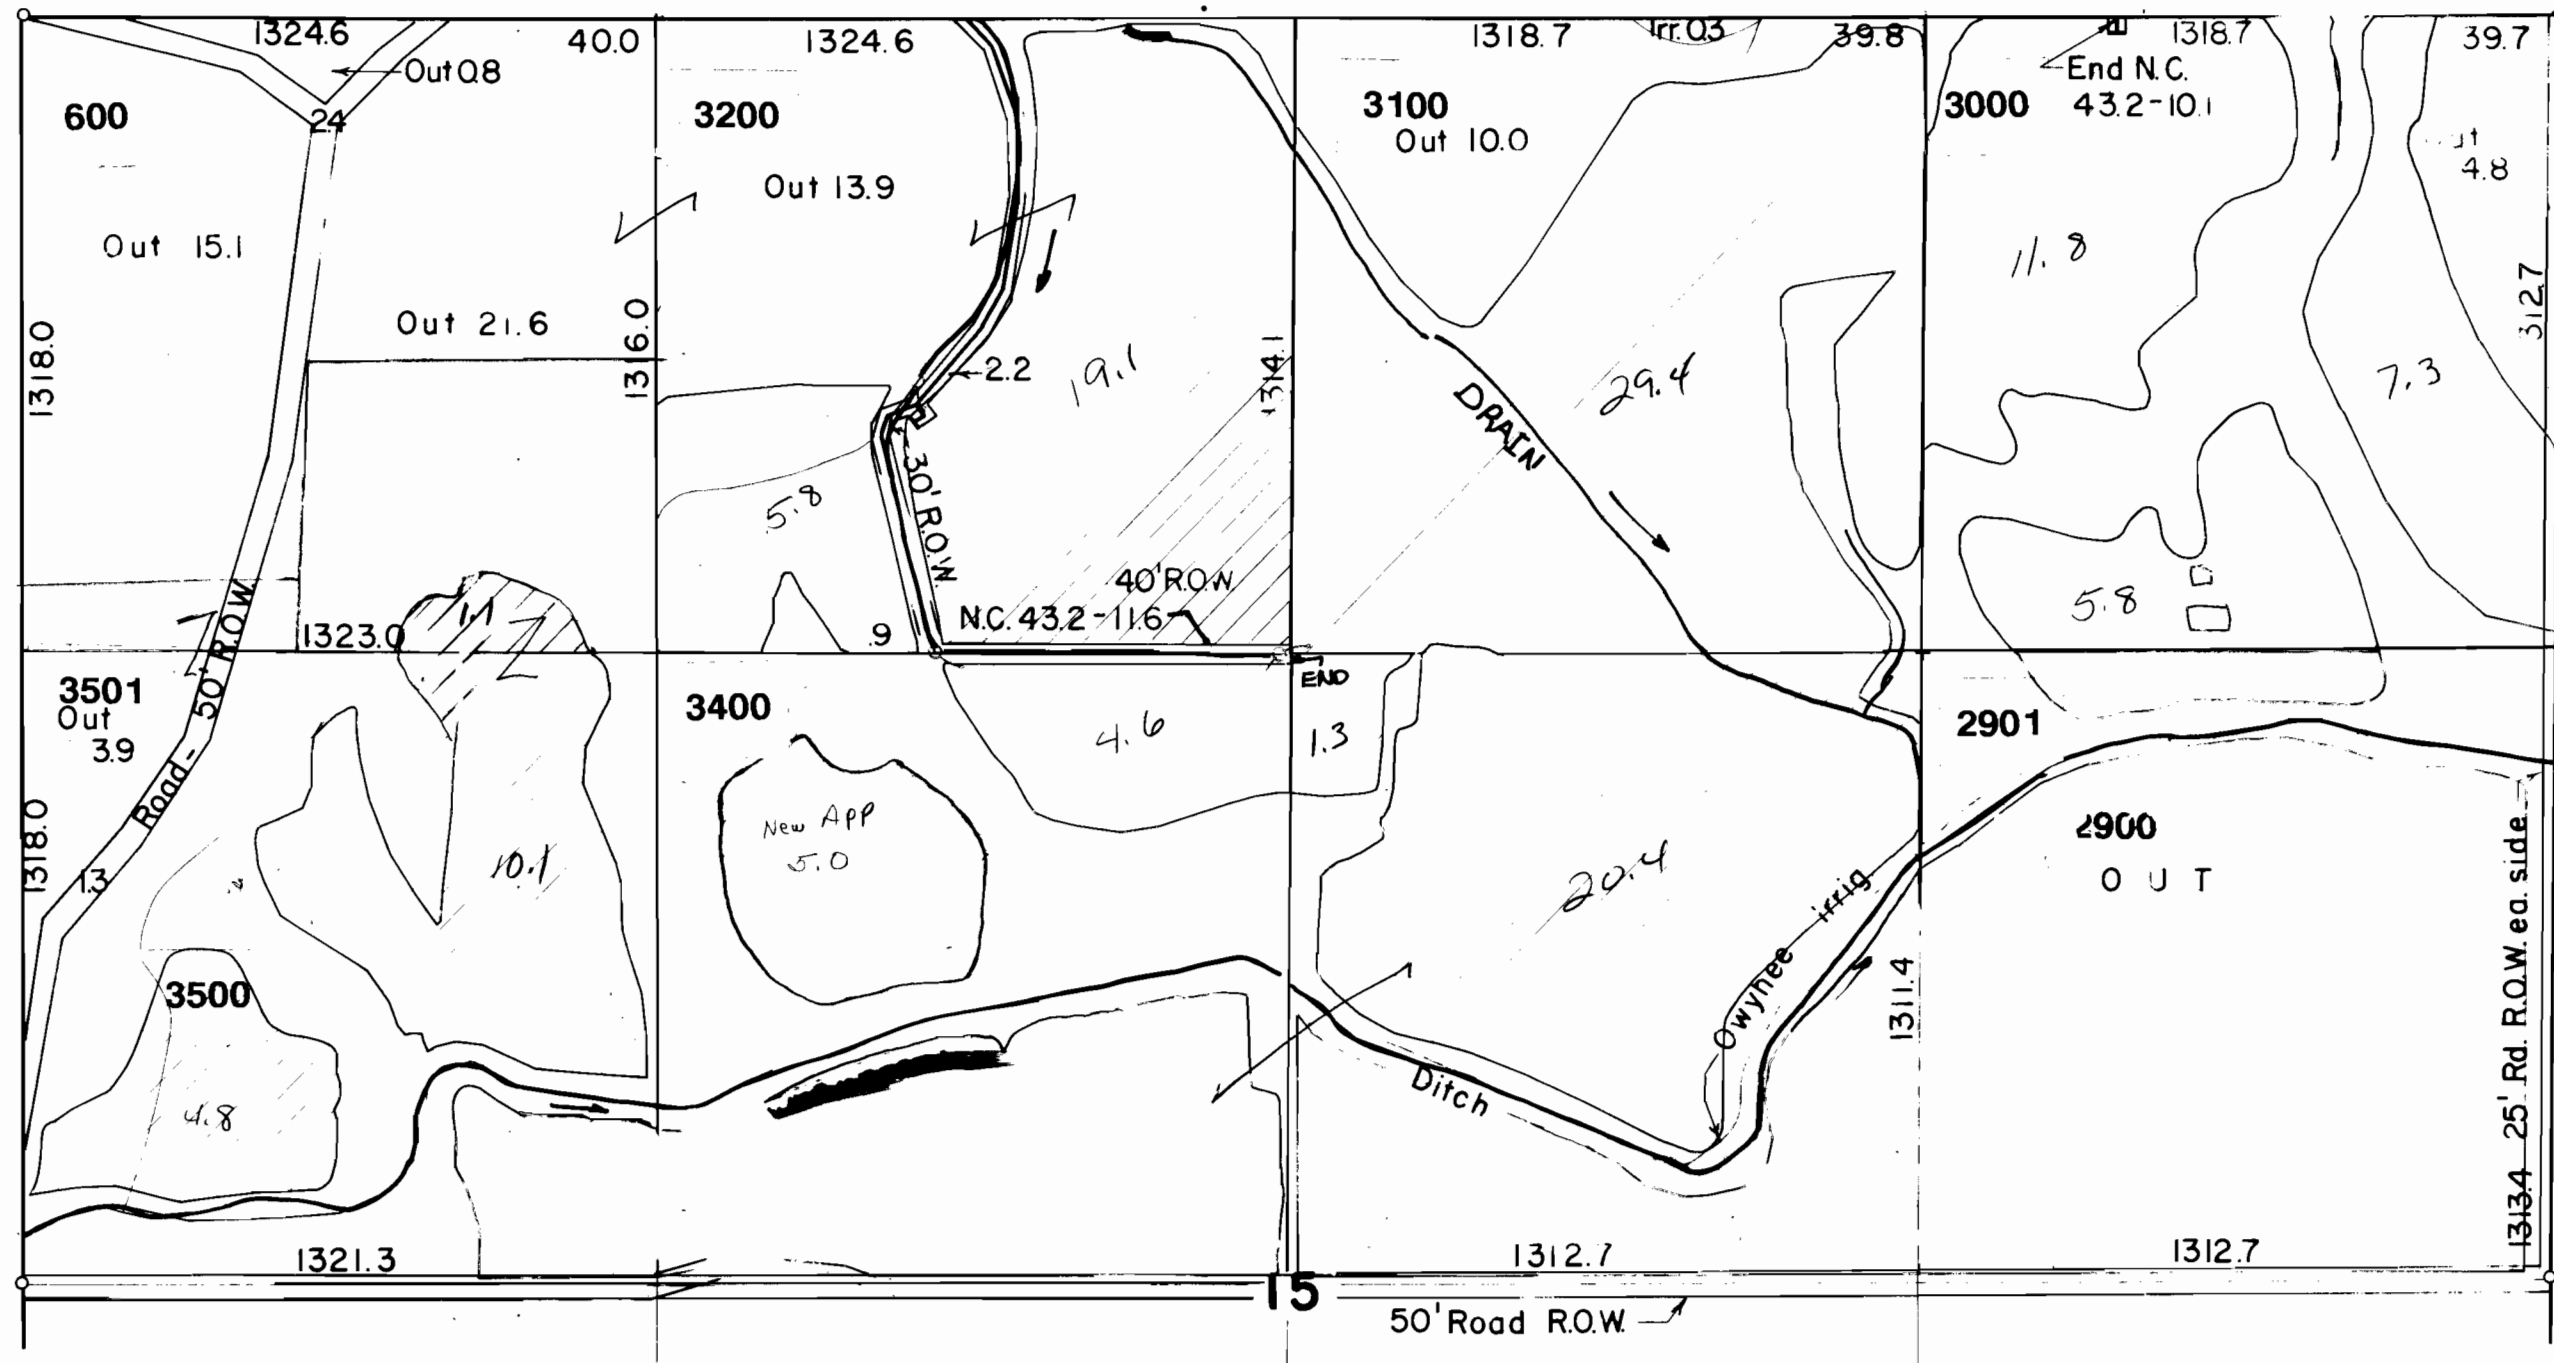

↑
N.
SCALE: 1" = 400'
[Hatched Box] - permit #8171

SEC. 15 - T. 18 S. - R. 45 E. - W.M. 48-102-1411