


OWYHEE IRRIGATION DISTRICT

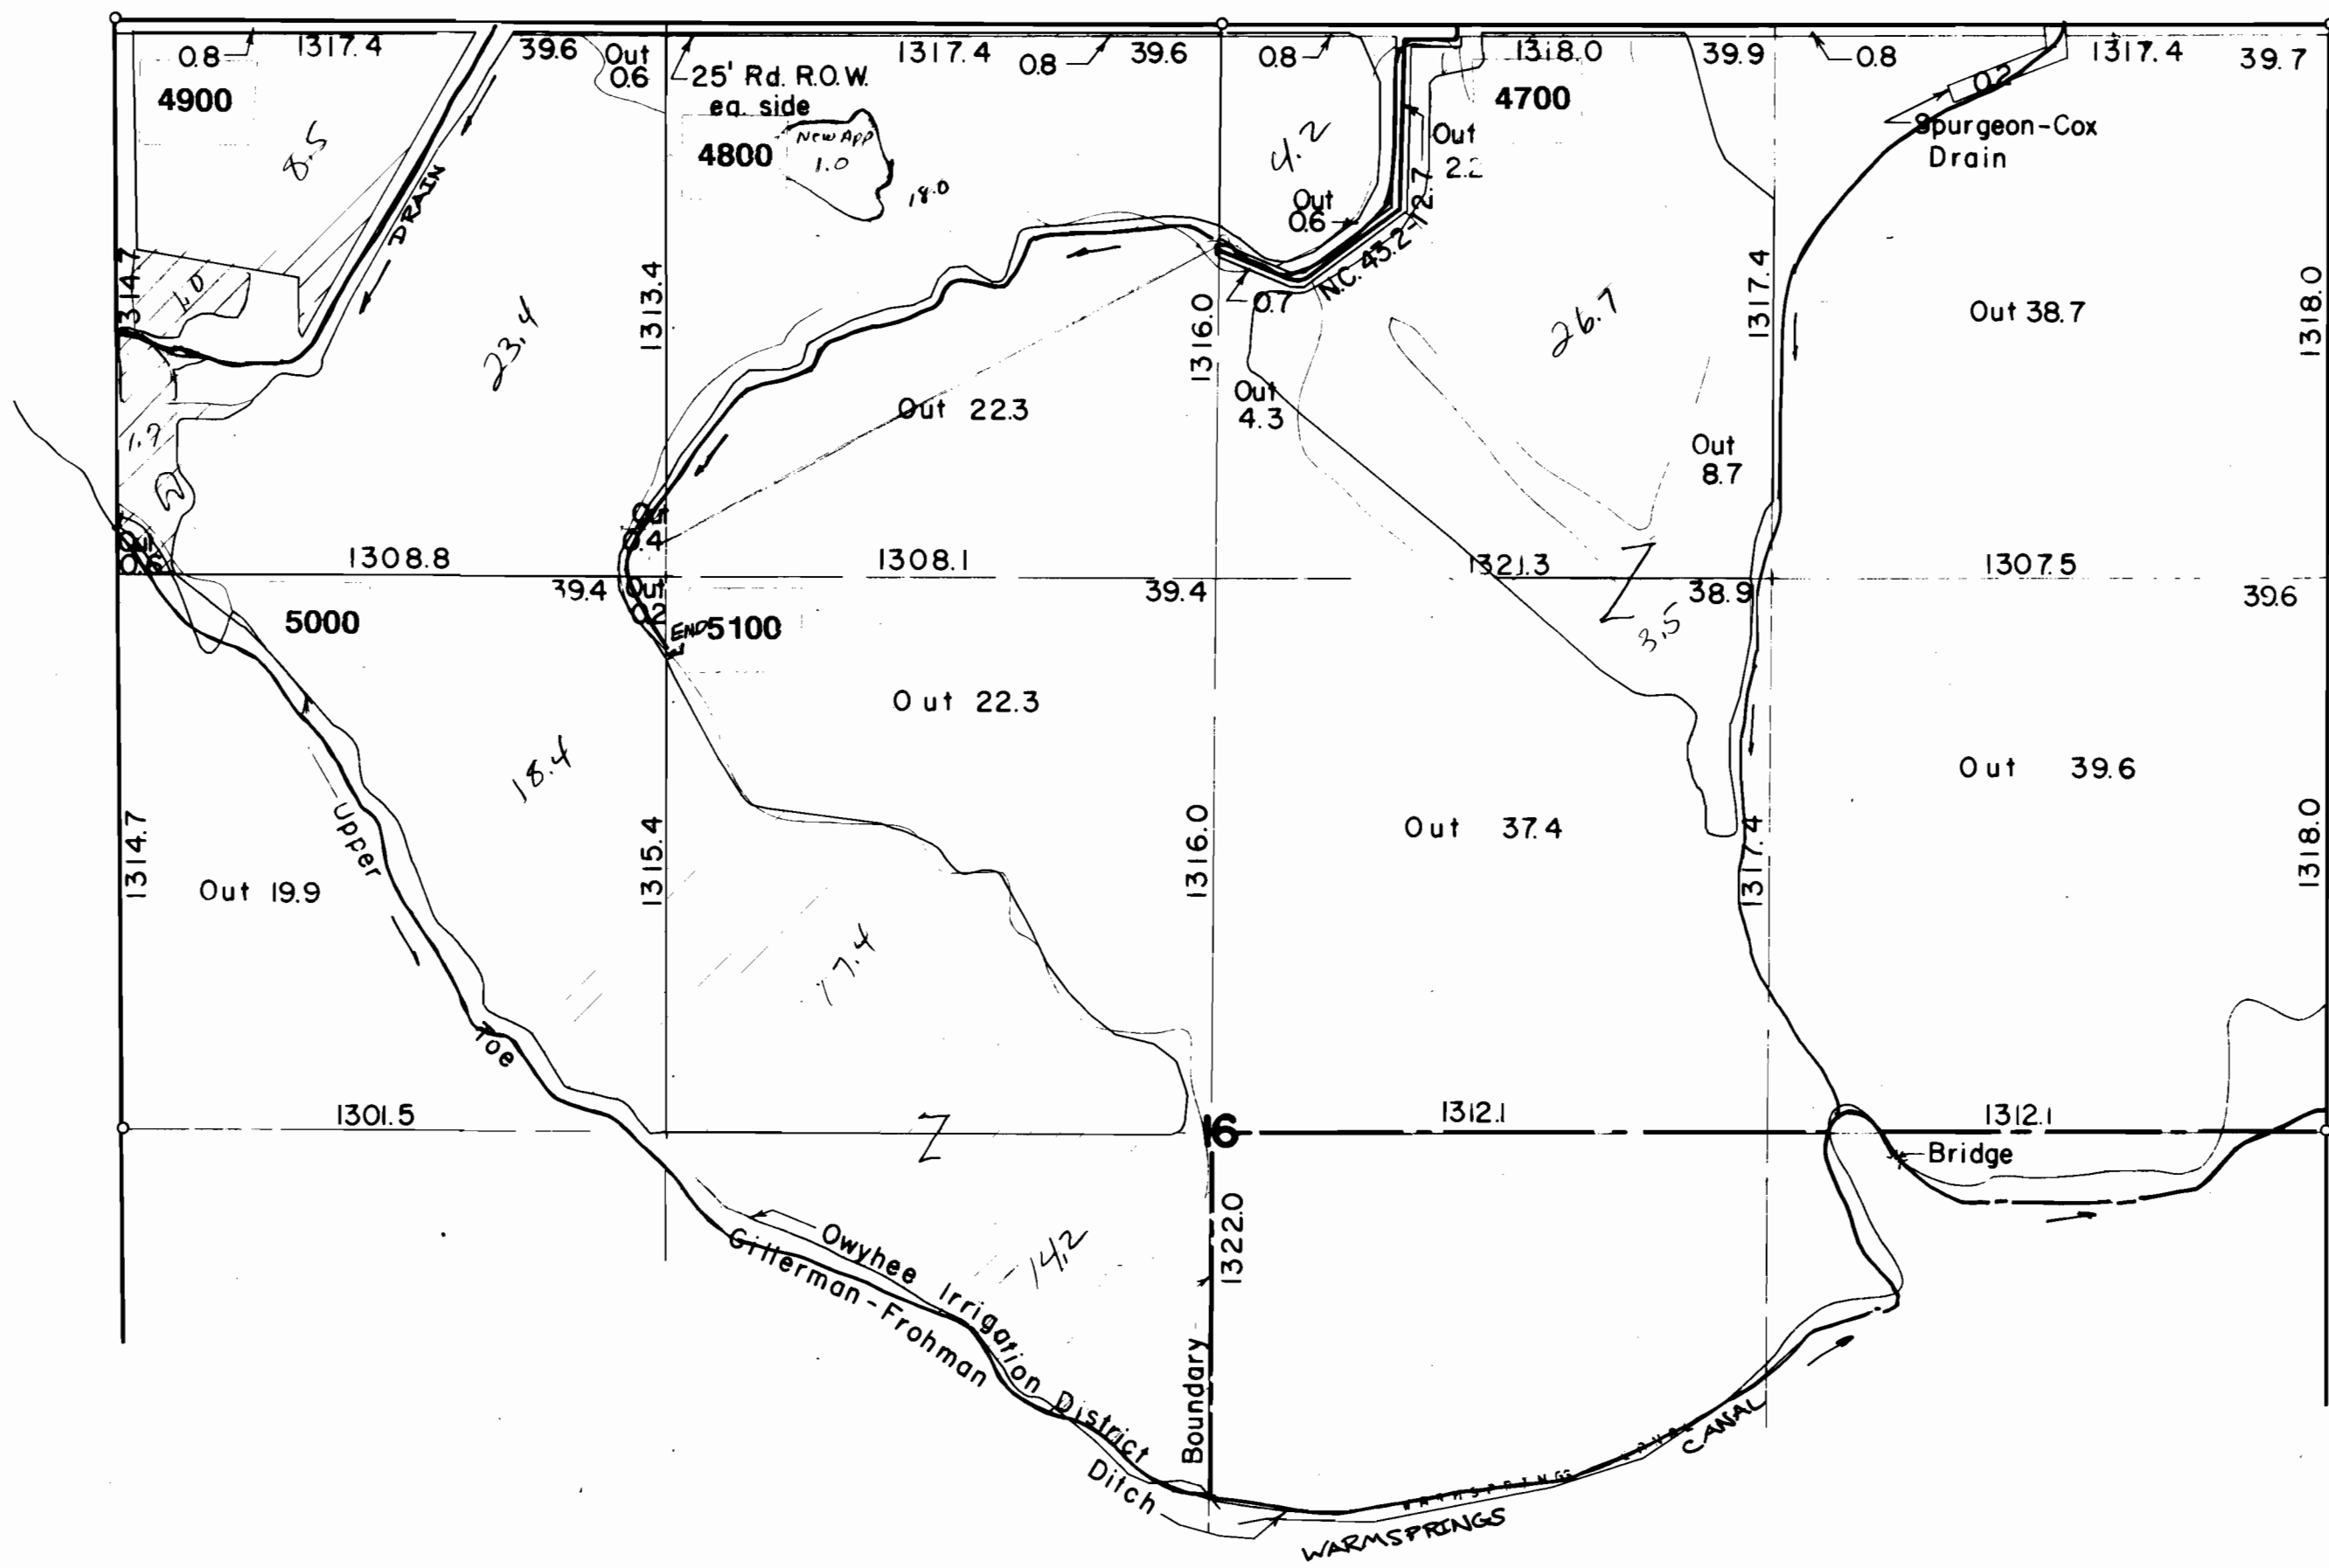

↑
N
SCALE: 1"=400'
[Symbol] = Permit #8171

SEC. 16 - T. 18 S. - R. 45 E. - W. M. 48-102-1412