


OWYHEE IRRIGATION DISTRICT

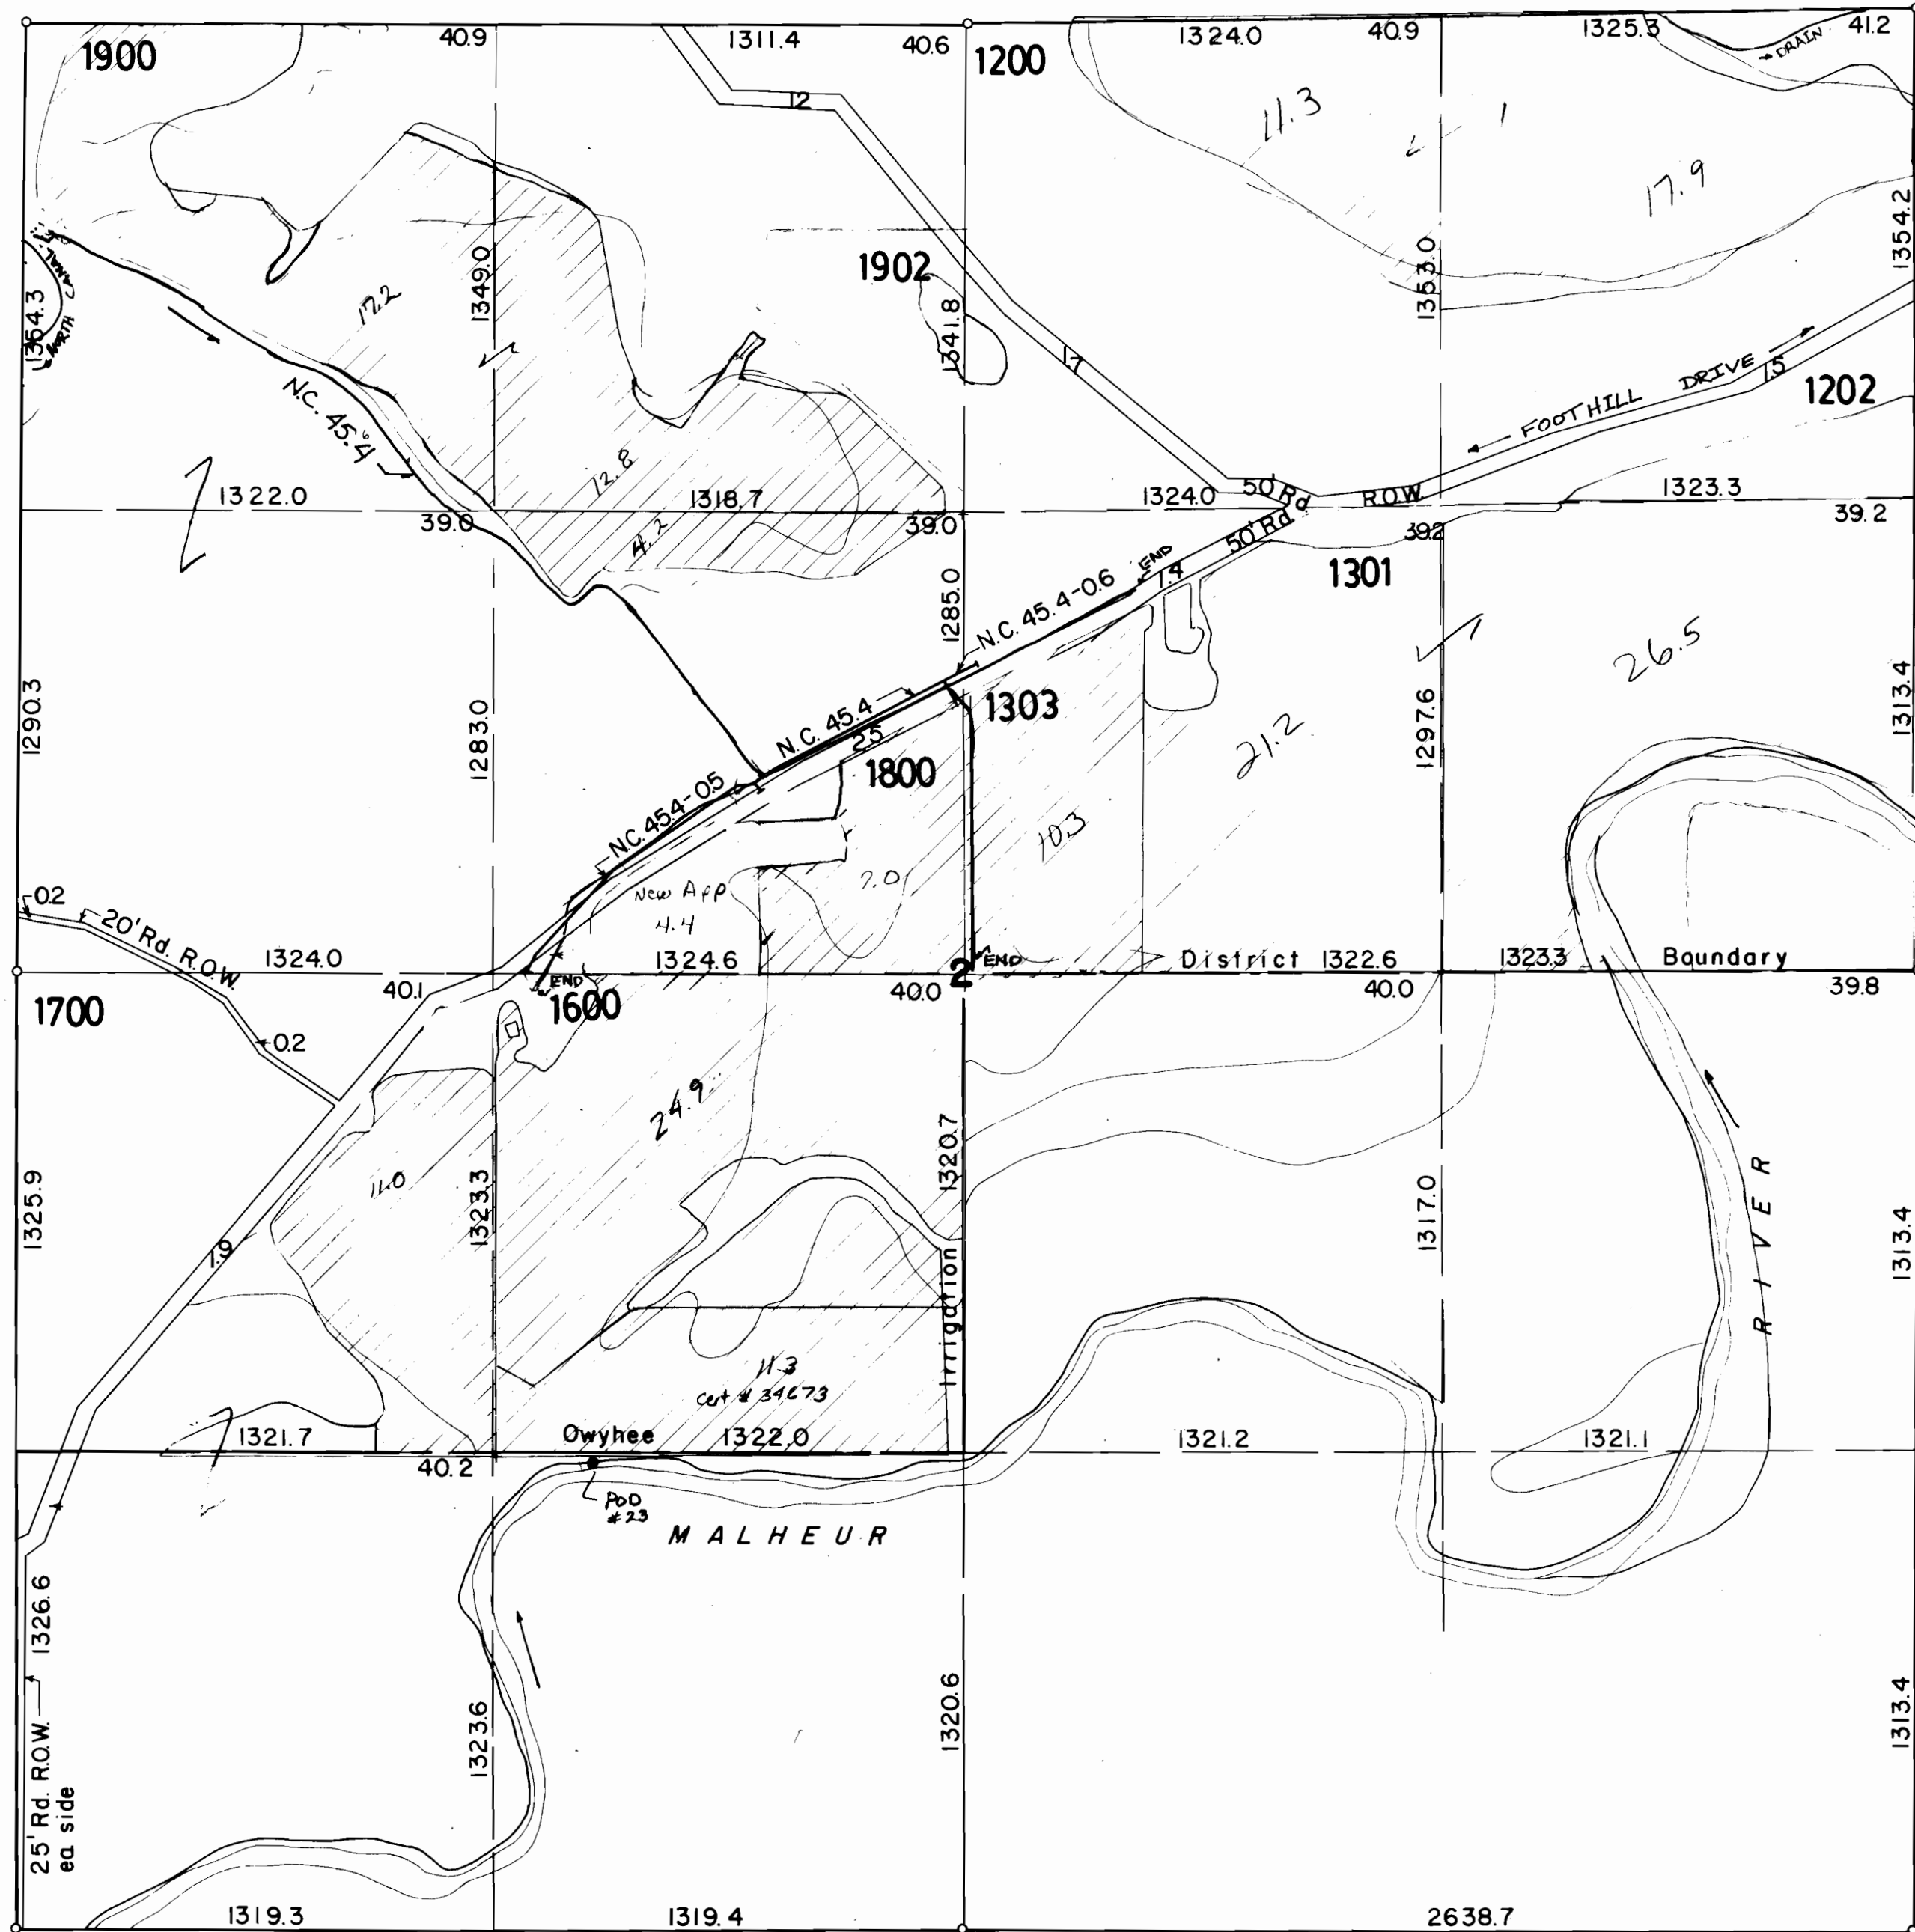

↑
N
SCALE: 1" = 400'
Permit # 3111

SEC. 2 - T. 18S. - R. 46E. - W. M. 48-102-1416