OWYHEE IRRIGATION DISTRICT

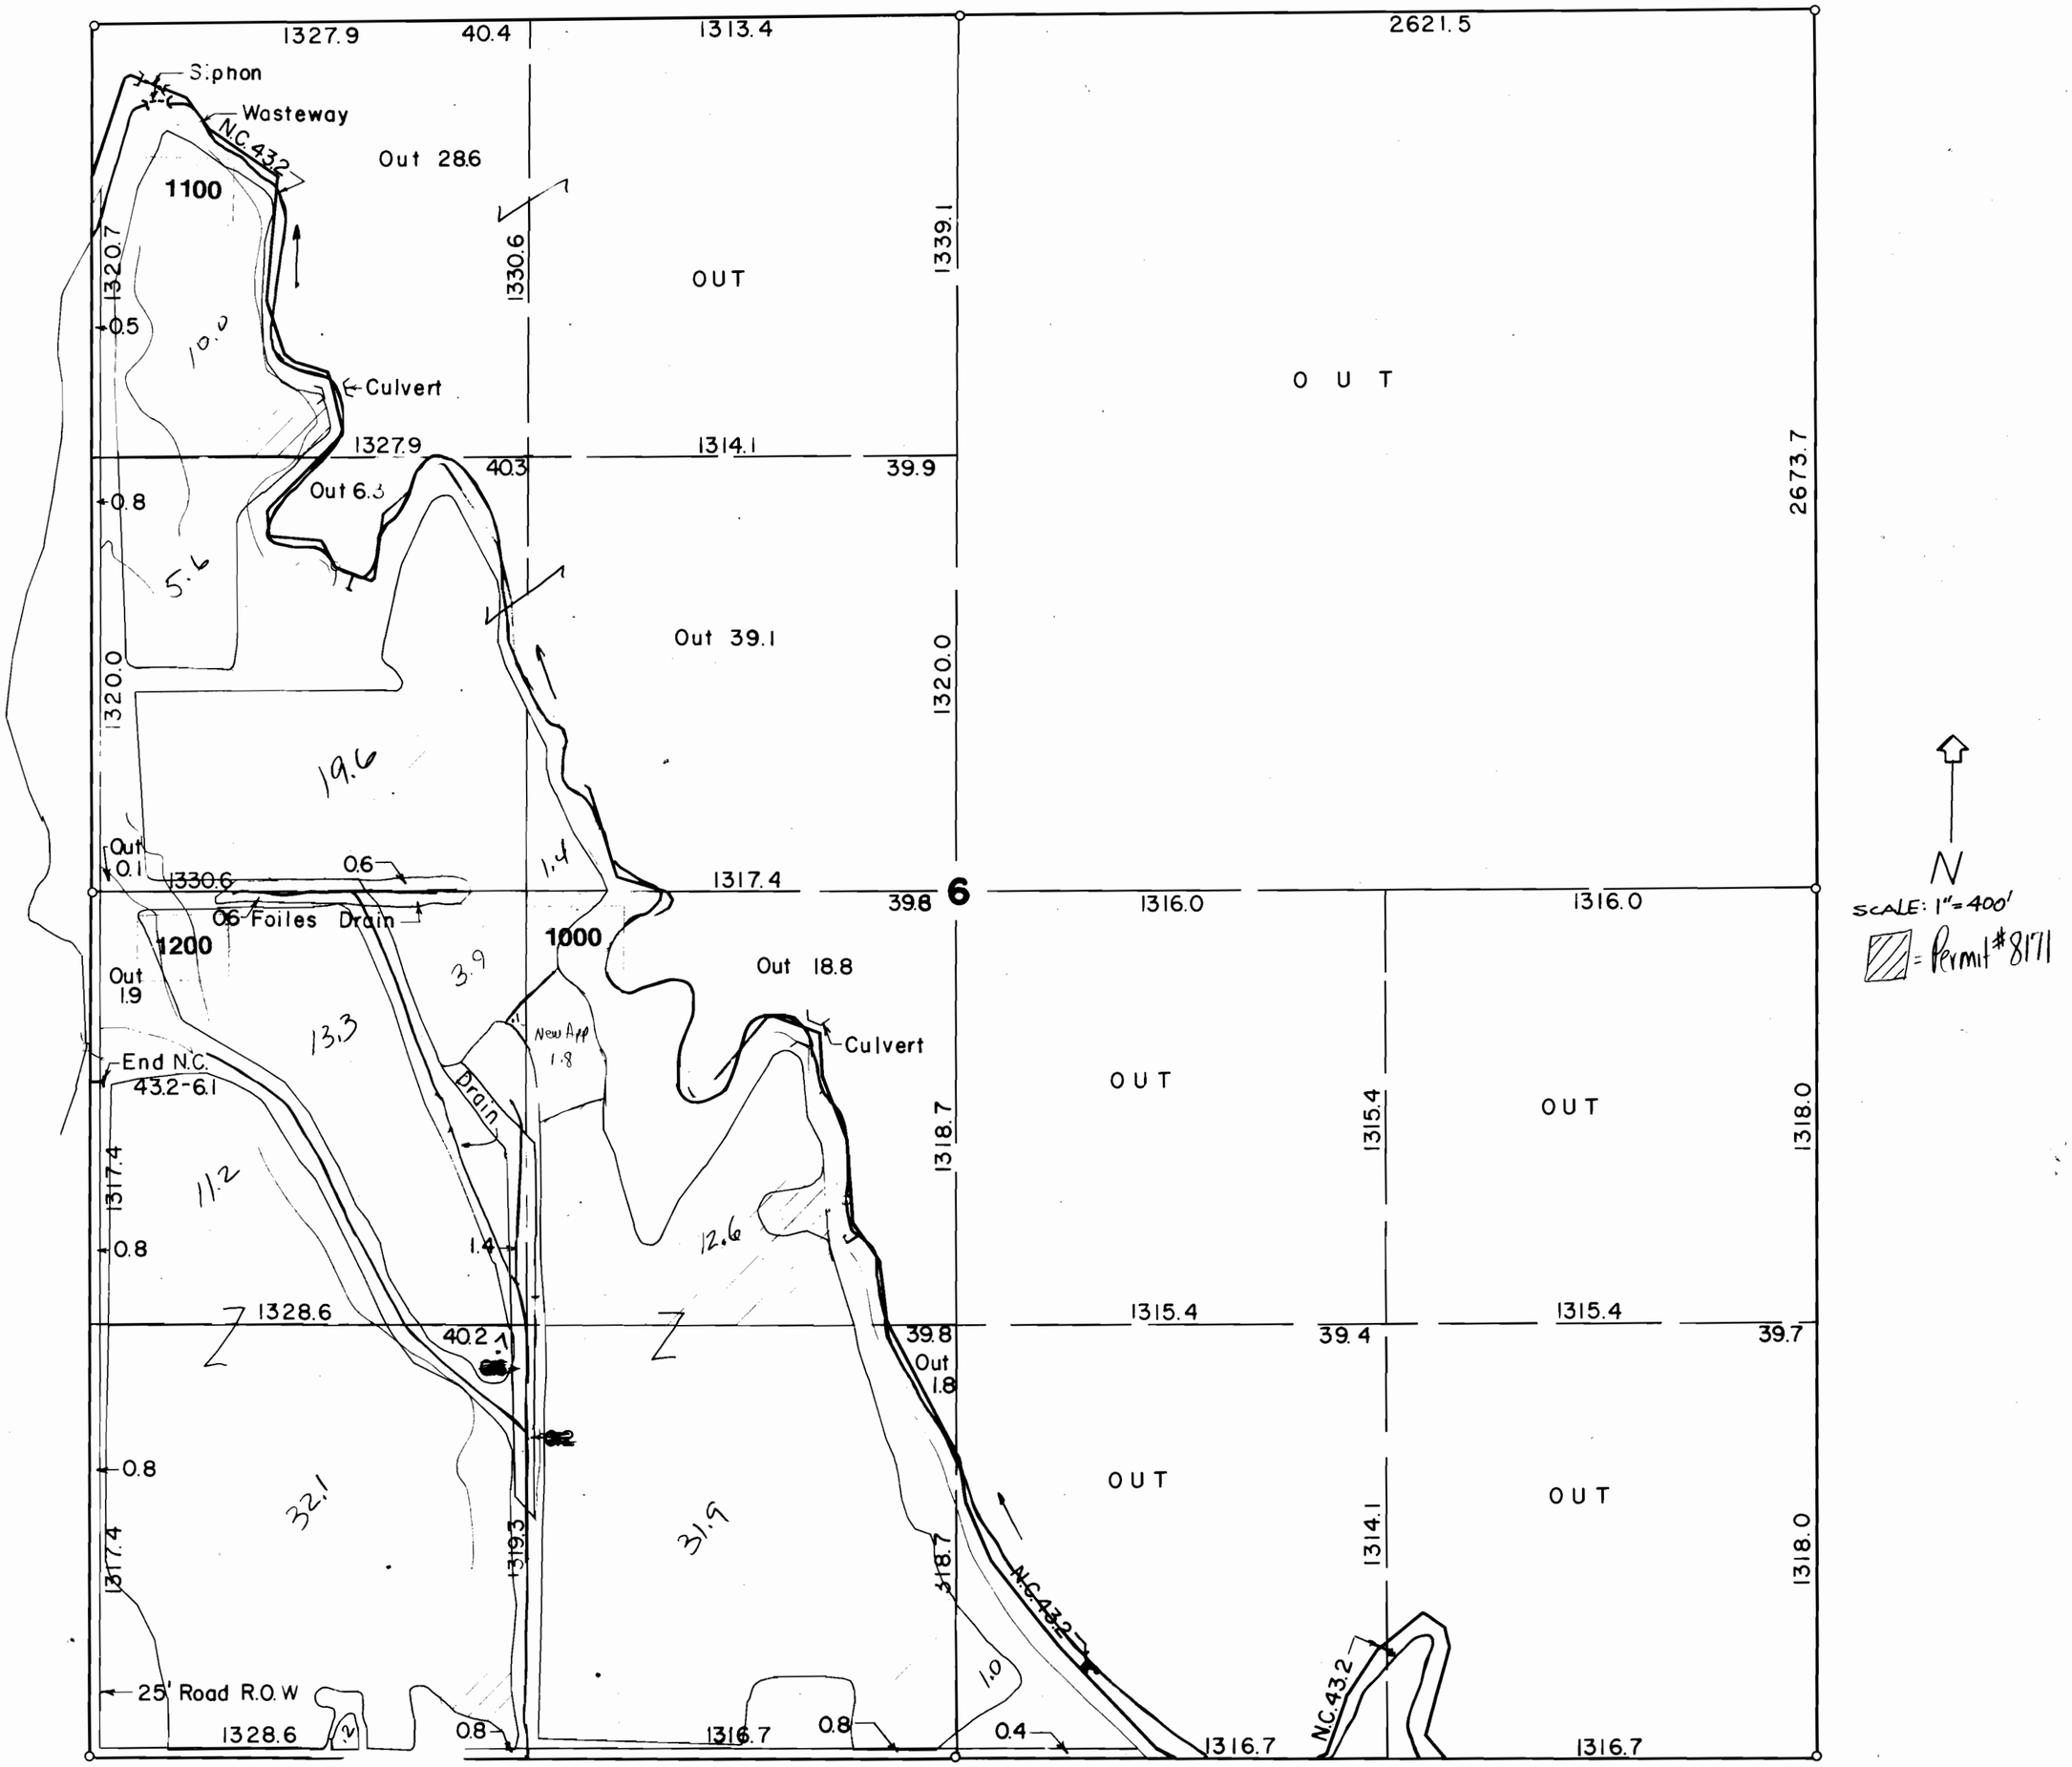

SEC. 6 - T. 18 S.-R. 46 E.-W. M. 48-102-1418

[redacted] REVISED 12-86