


1" = 1320'

Tax Lot: 1N3W-25-00100

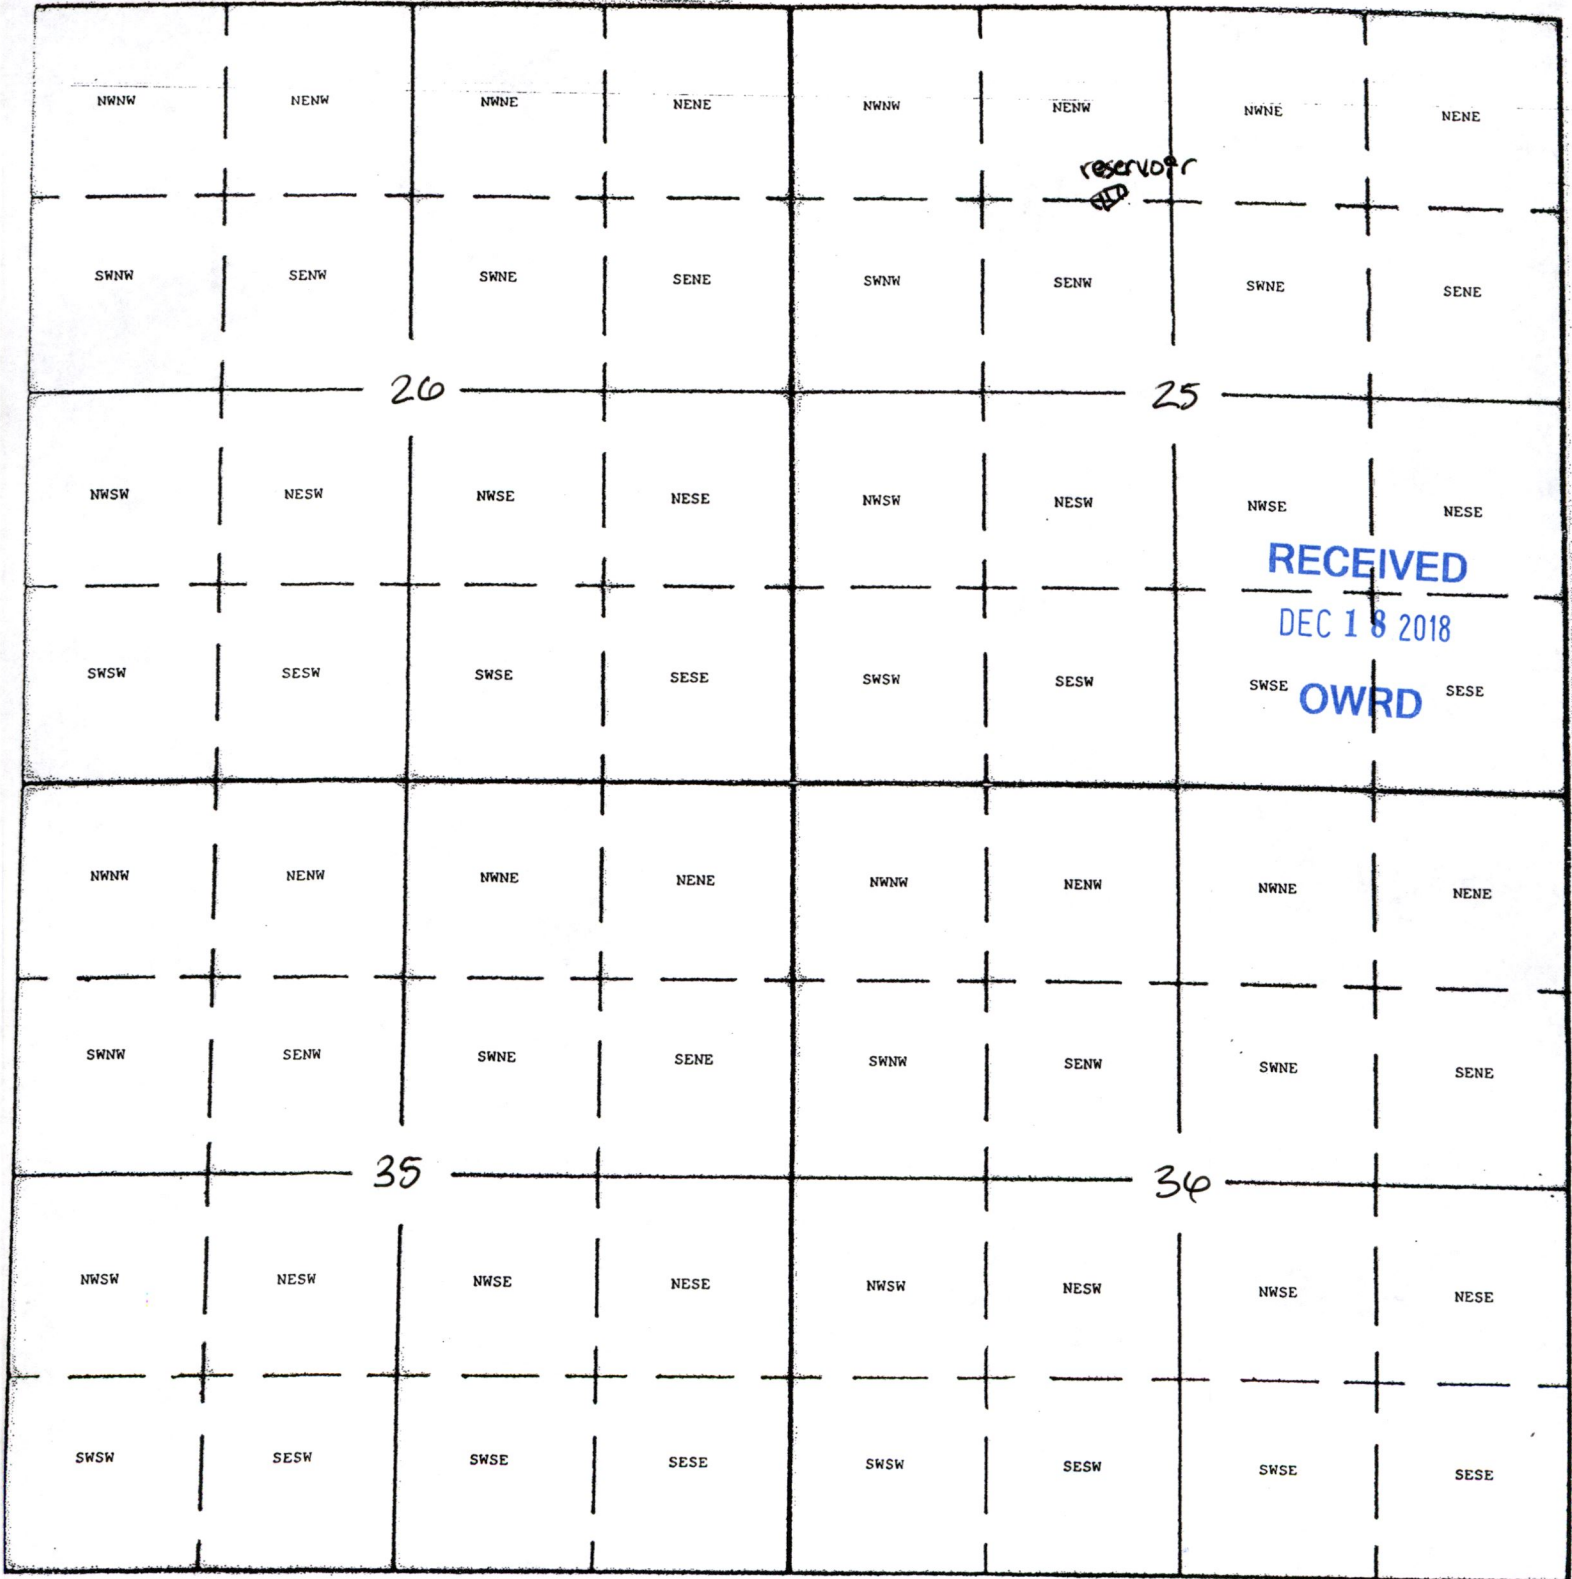

The center of the reservoir is located:
1375' N and 371' W of the center of
section 25.

E.G. 12/18/18.


R-88684

RECEIVED
OWRD

1N 3 25B

1N 3 25B

Exhibit D

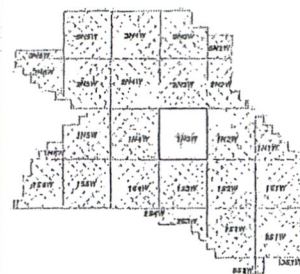

WASHINGTON COUNTY OREGON
 NW 1/4 SECTION 25 T1N R3W W.M.
 SCALE 1" = 200'

08	09	10	11	12	13	14	15
16	17	18	19	20	21	22	23
24	25	26	27	28	29	30	31
1368	1369	1370	1371	1372	1373	1374	1375
1376	1377						