


Rat Colney

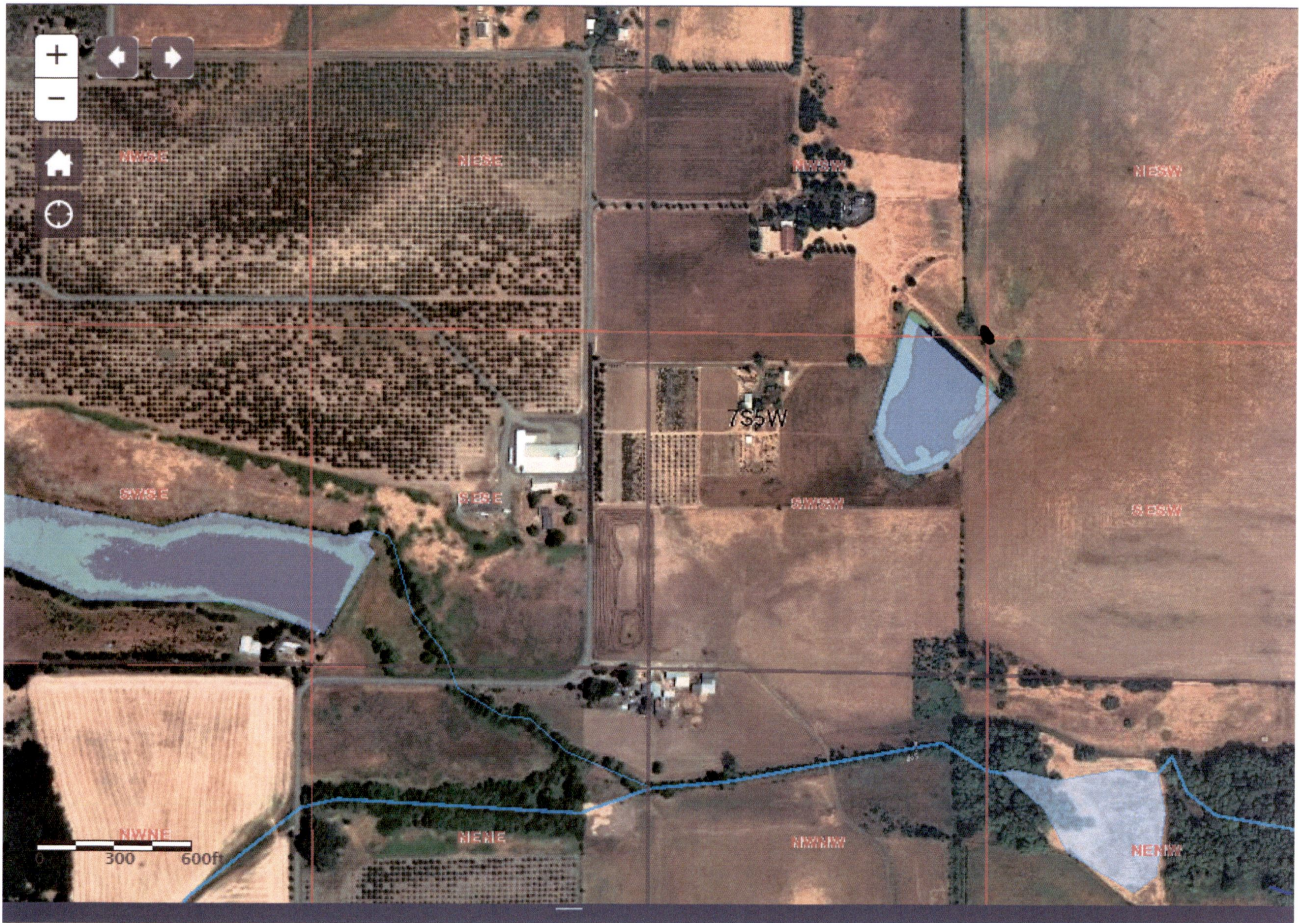

RECEIVED

JAN 02 2019


OWRD

< - 88689

North ↑

Pump

130 S and 390 W from
NE corner, SWSW sez 23

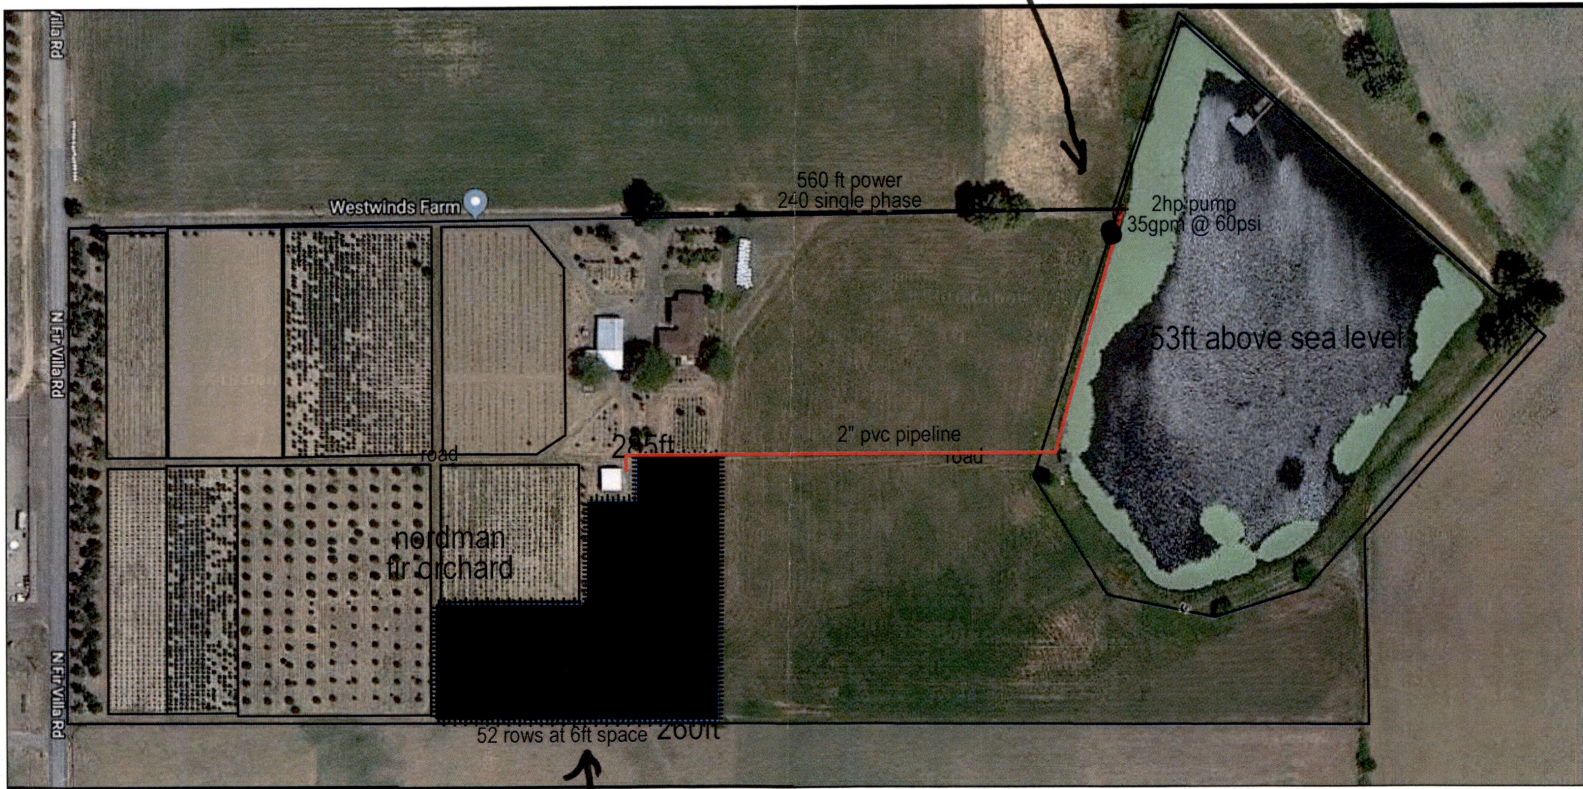

2 acres SWSW

RECEIVED

JAN 02 2019

OWRD

6-00100

~~505~~ 800-469 3981

