




N

1" = 1320 ft

T.14S.R.6W.W.M.

Tax Lot 1200

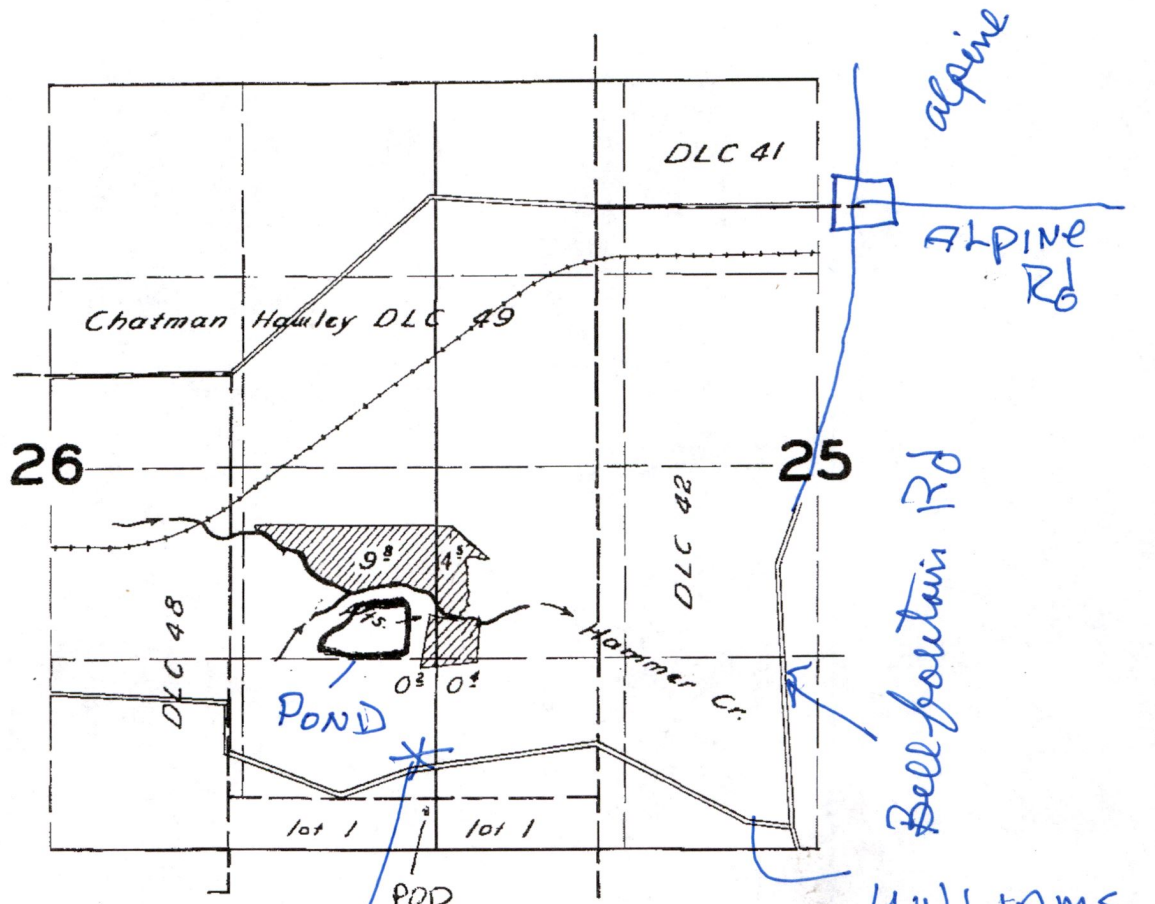

Dam: 330 ft N & 490 ft W from SE corner, NESE, Section 26
 POD: 240 ft N & 110 ft W from SE corner, Section 26

24842 Williams Rd
 manaeor
 97456

RECEIVED
 JAN 07 2019
 OWRD

R-88891