

Application for Permit to Appropriate Groundwater

Lots, 17 and 18, Section 19, T.1S., R.33E., W.M.

Detail

0 400
Scale: 1" = 400'

Northwest corner
Tax Lot 3501
S75°13'35"E,
891.96' from
West 1/4 Corner.

Stewart Cr. Road

1/4
Cor.

20' access easement

Well, S65°51'25"E,
1126.53' from West
1/4 Corner.


Lot 18,
0.65 ac.

Lot 17,
4.35 ac.

Tax Lot 3501,
5.00 acres.


Note:
Tax Lot 3500
surrounds
Tax Lot 3501
on all sides.

NOTE:
The information shown
on this map is solely
for Water Rights
purposes. The data
shown does not represent
ownership information.

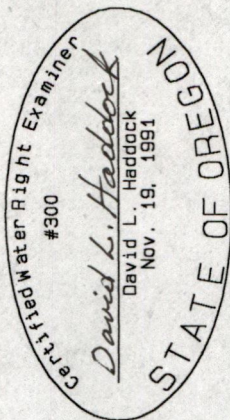

(renews 6-30-01)

0 2640
Scale: 1" = 2640'

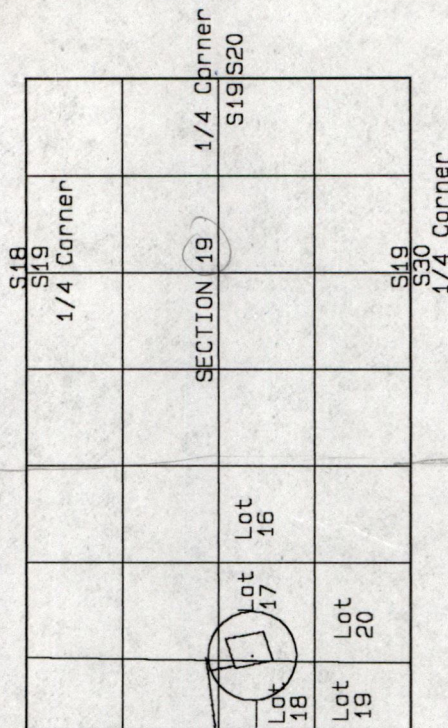

West 1/4 Corner
Section 19,
Found Stone.

See Detail

RECEIVED

DEC 01 2000

WATER RESOURCES DEPT
SALEM, OREGON

Application No. 915257
Permit No. 913992

Survey Date: November, 2000.

SURVEY FOR

Janet Haddock
P. O. Box 974
Pilot Rock, OR 97868
(541) 443-2920


David L. Haddock, Surveyor and Engineer
P. O. Box 1574
Pendleton, Oregon 97801
(541) 275-2174

HADDOCK SURVEYING




TOTAL STATION

Sevenmile
Creek

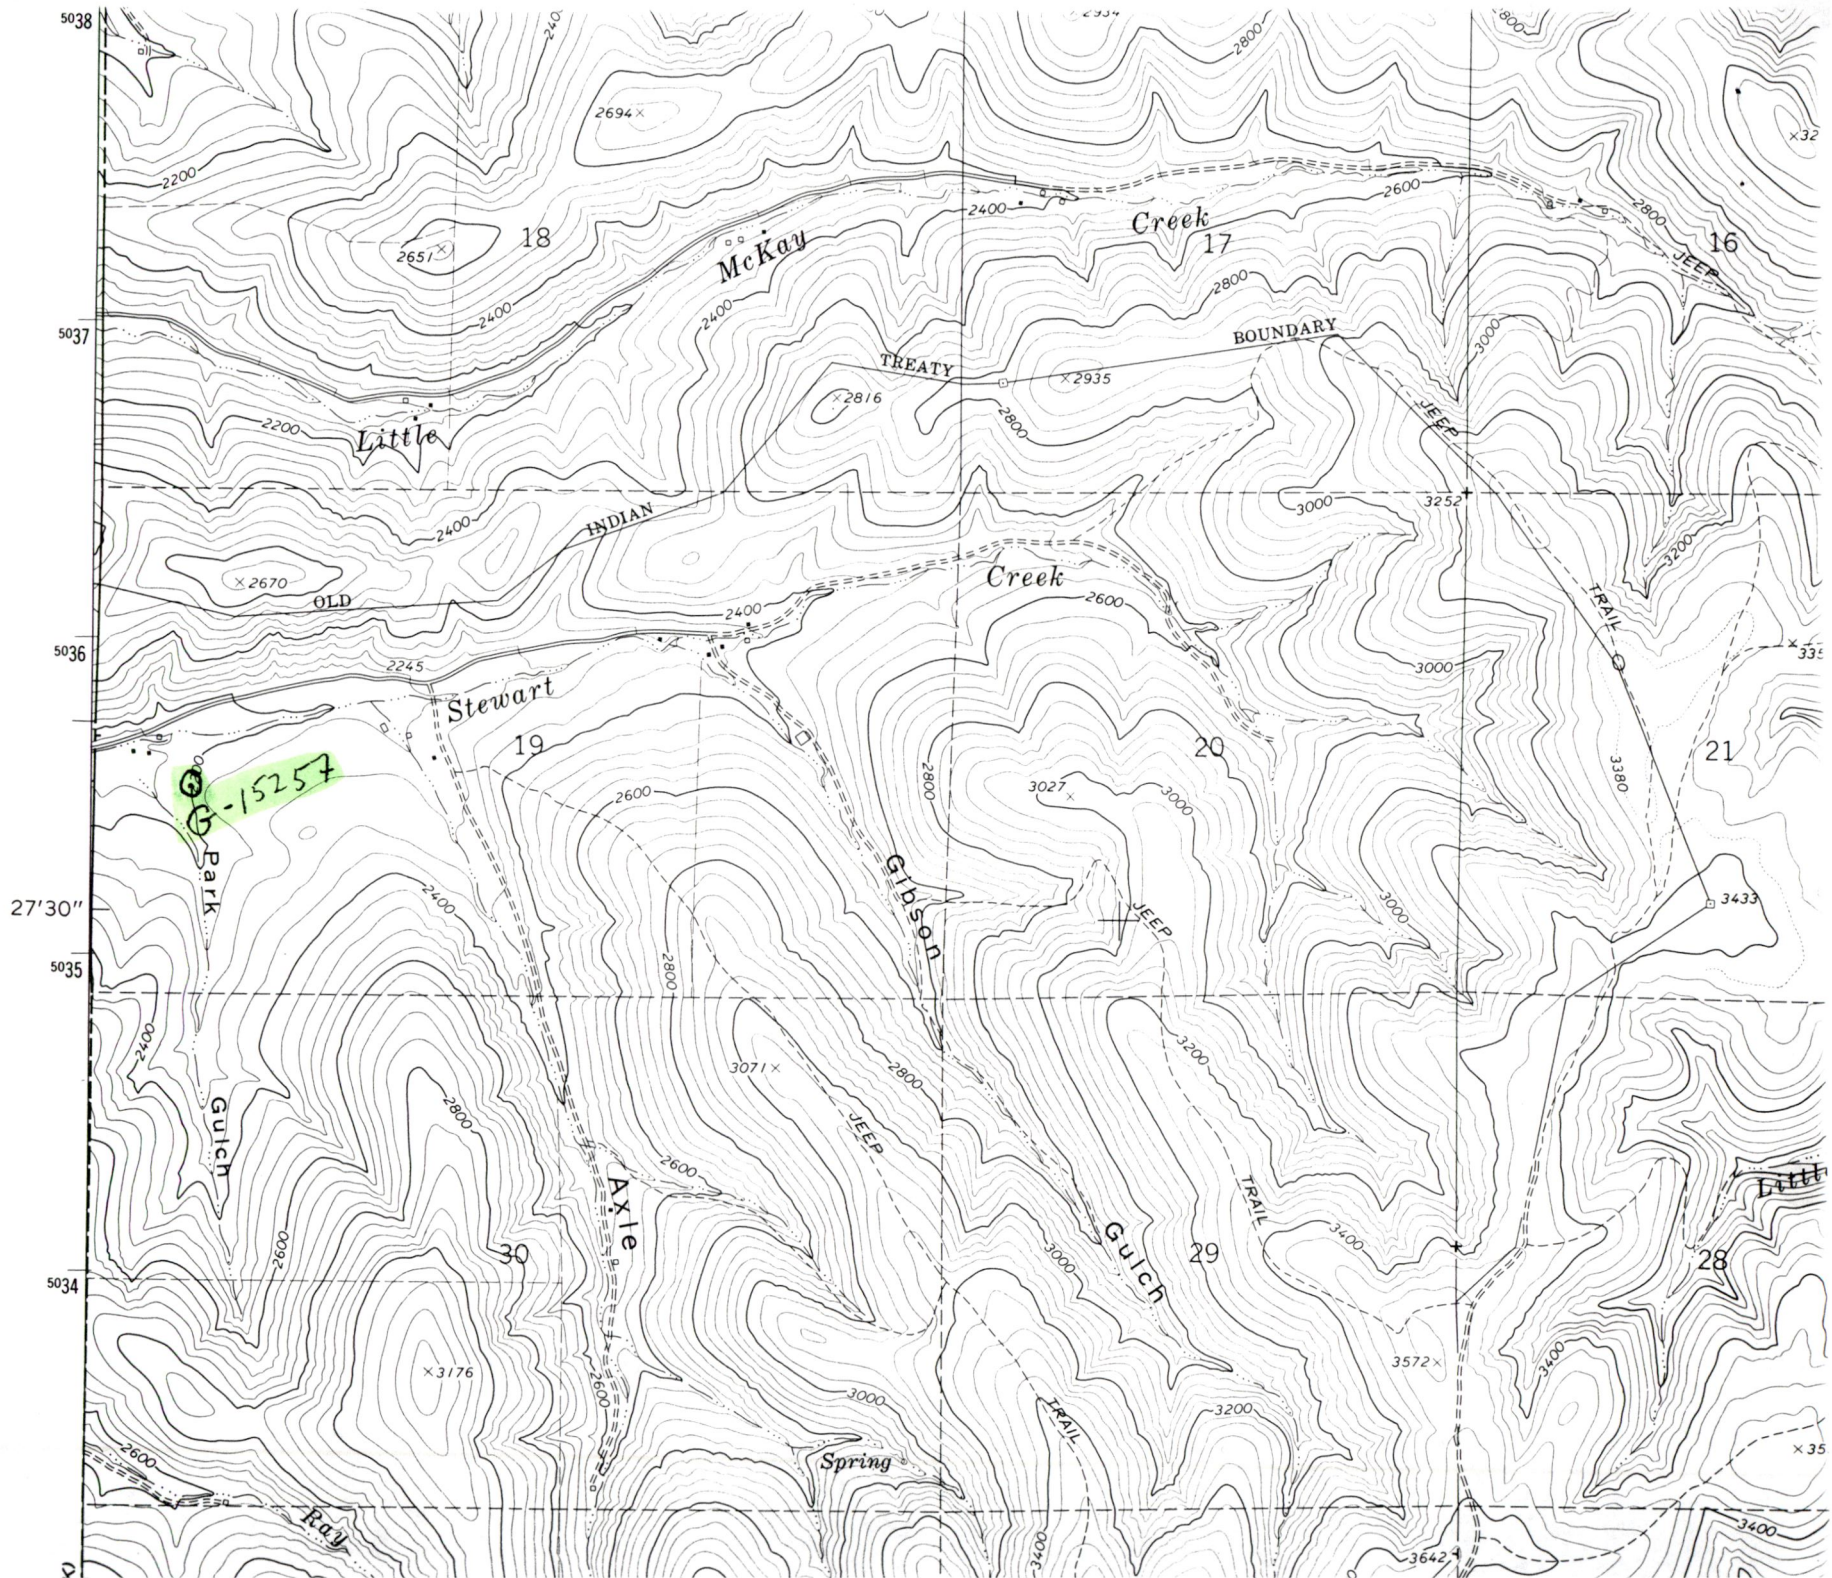


Wells in the vicinity of application G 15257

- Application well(s) in this 1/4-1/4 section
- Well(s) identified in this section from OWRD's well log database within 1 mi. radius of application well(s)
- Well(s) identified in this 1/4-1/4 section from OWRD's well log database within 1 mi. radius of application well(s)
- ✕ Permitted well(s) in this 1/4-1/4 section within 1 mi. radius of application well(s)
- Conditioned, permitted well(s) in this 1/4-1/4 section within 5 mi. radius of application well(s)
- ▲ OWRD Observation well and well-id within 5 mi. radius of application well(s)
- Critical GW Area
- - - Regulated GW Area

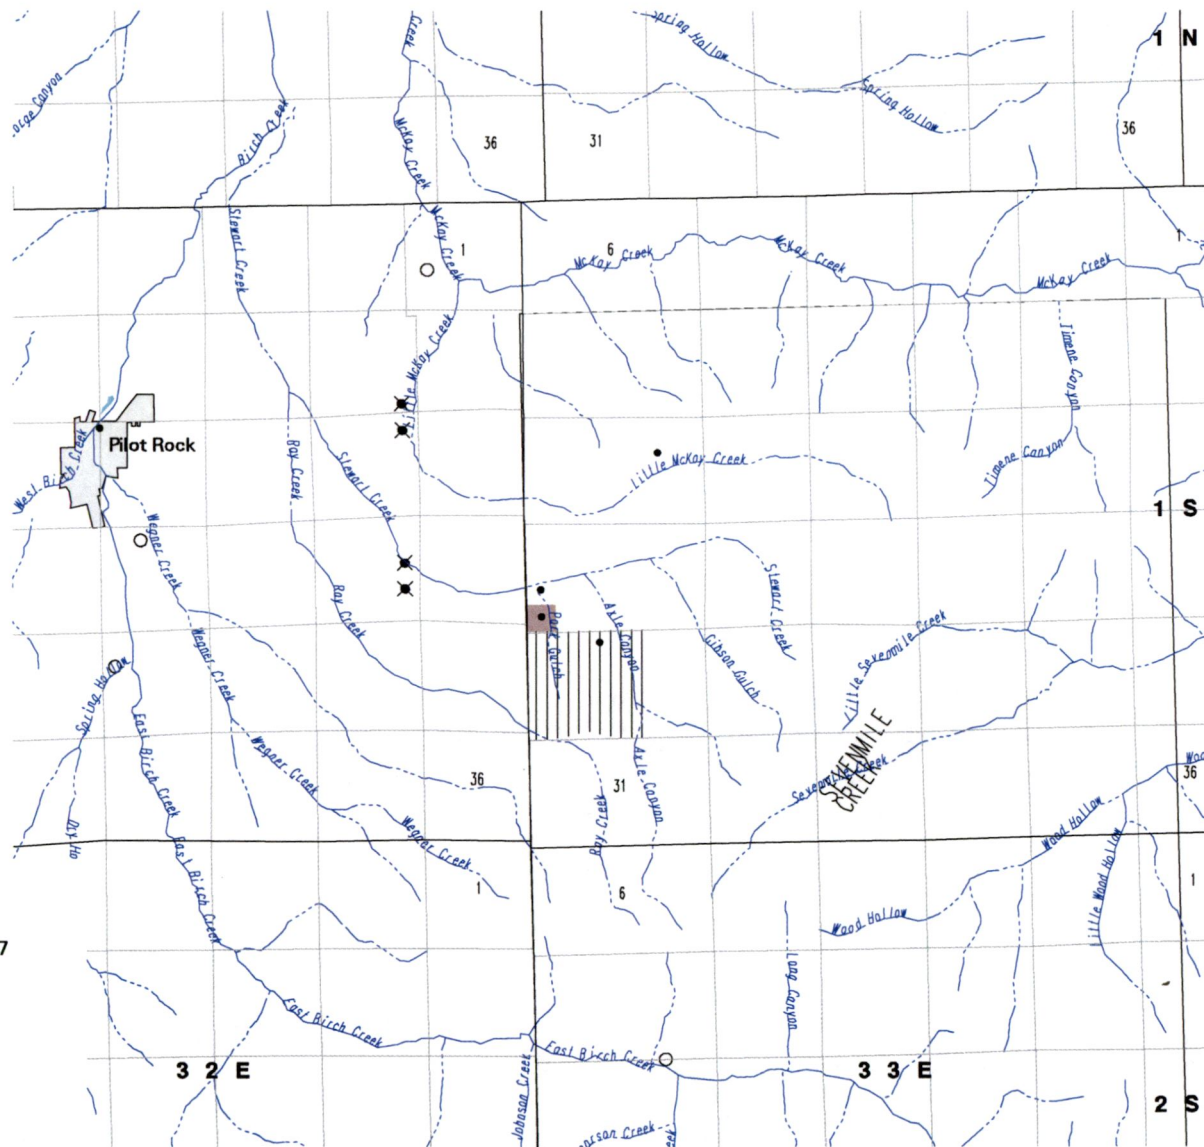

WELLS WITHIN 1 MILE OF G 15257
DO 6
IR 4

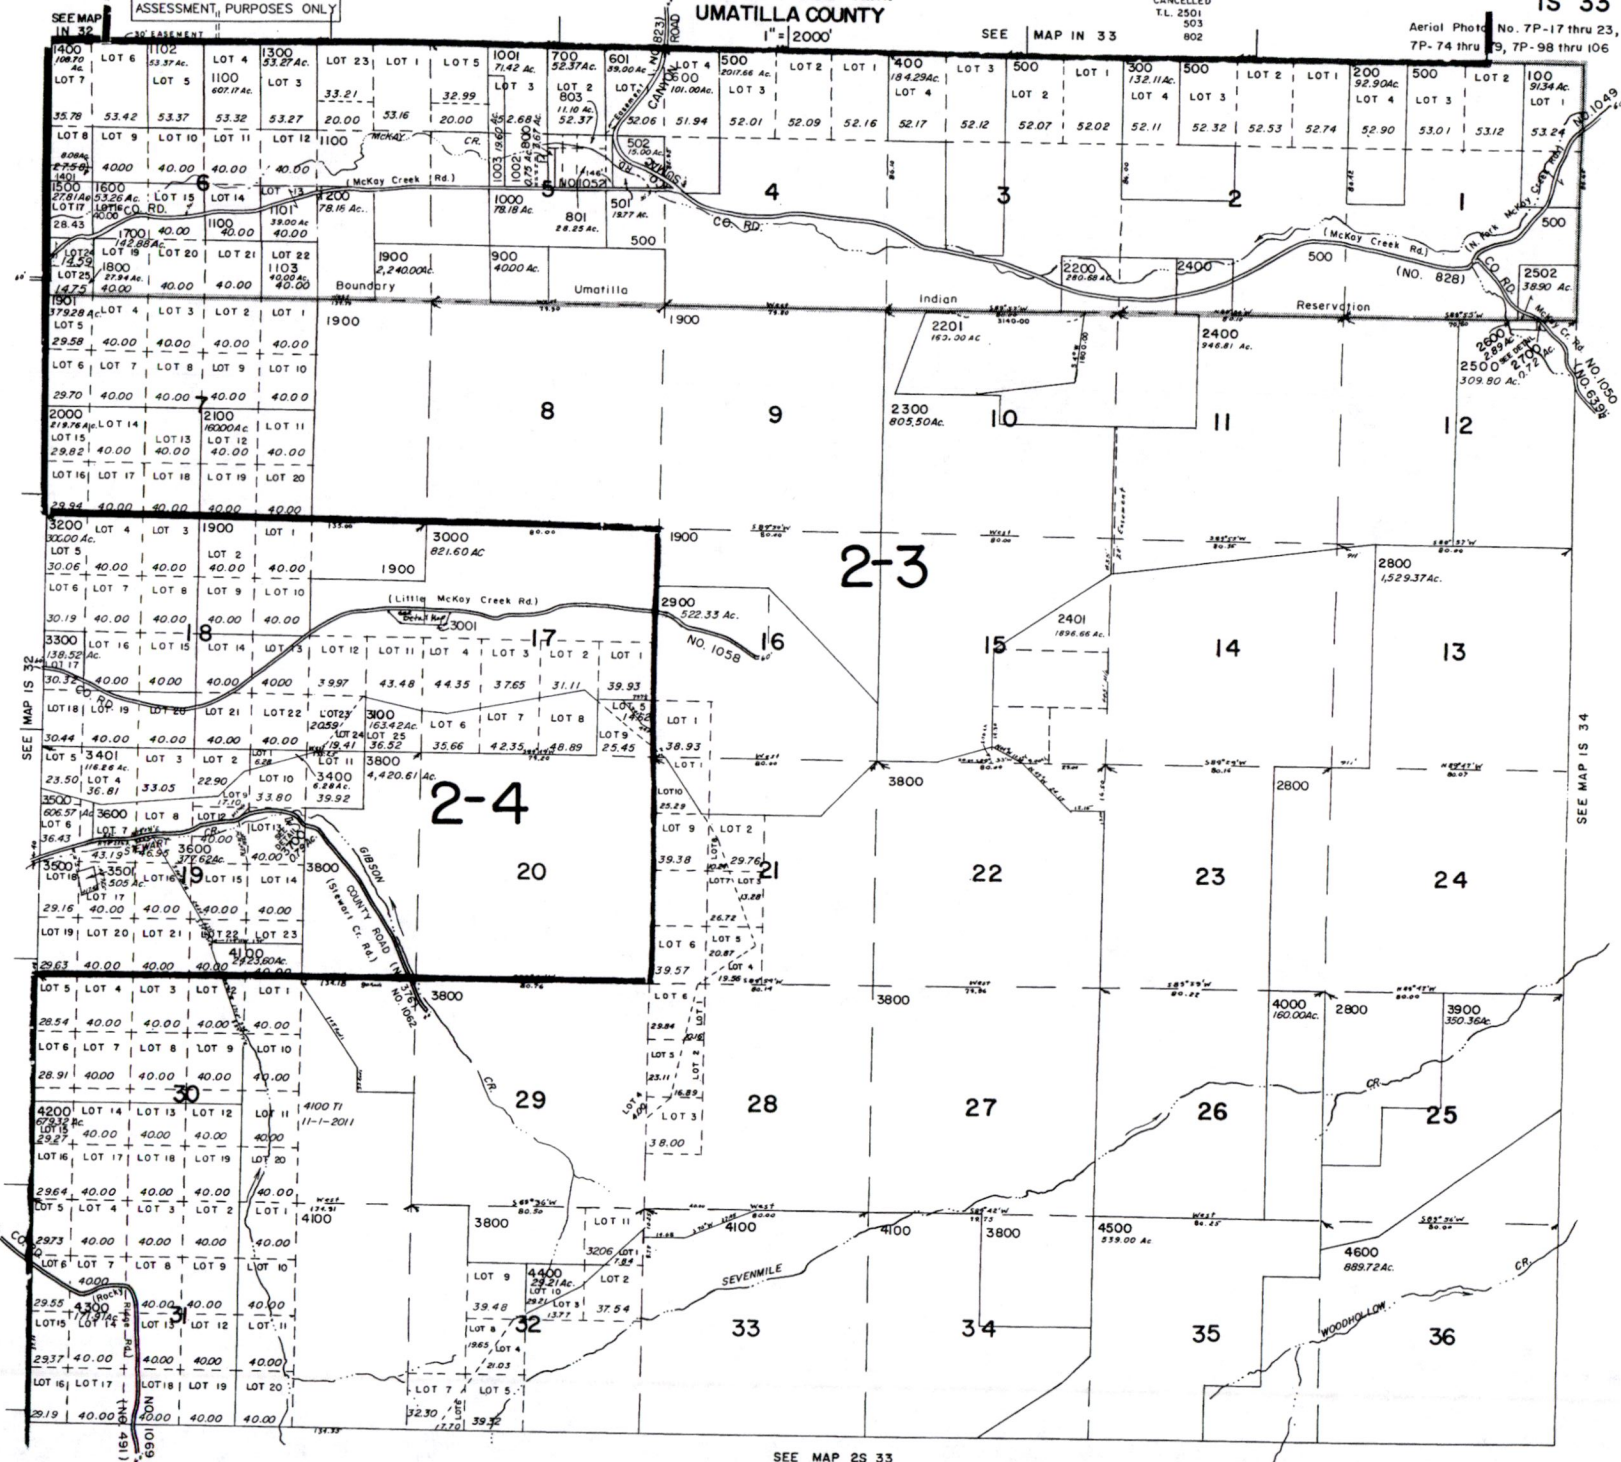

Address: