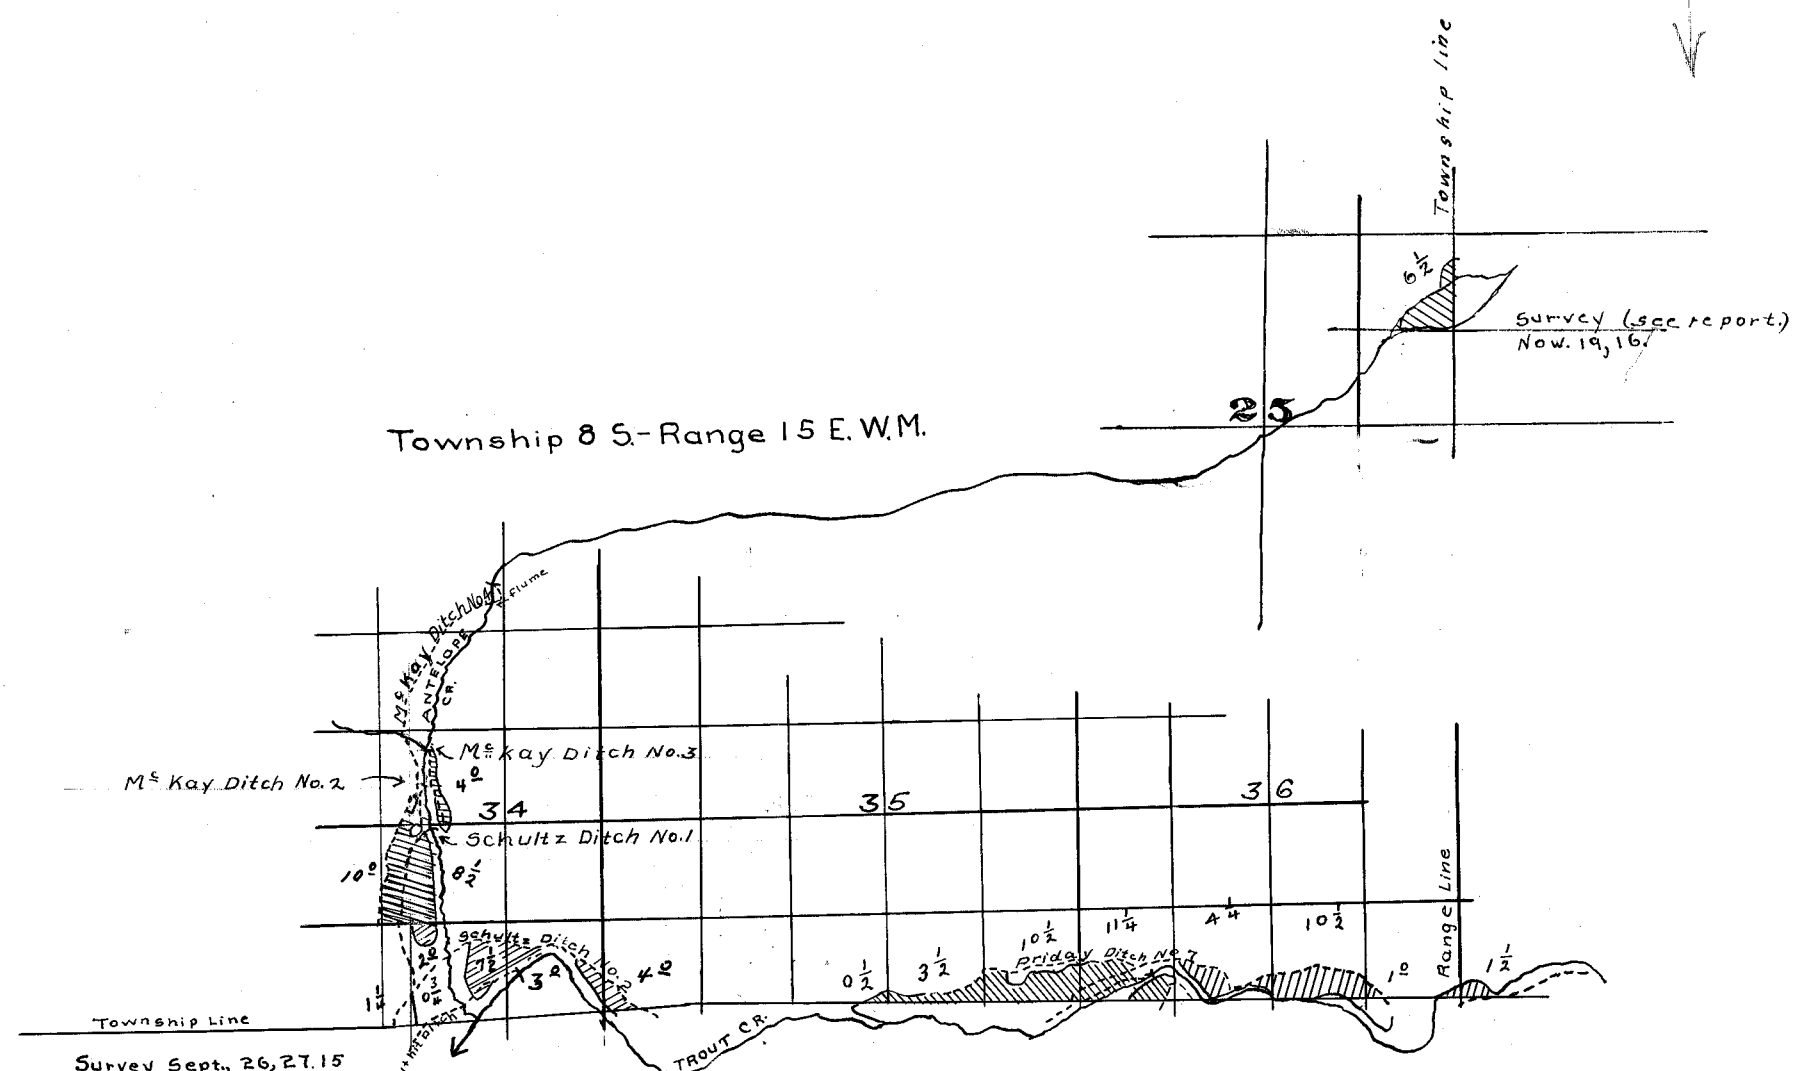

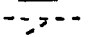



PRINT



- LEGEND -

-  Irrigated land with areas
-  Ditches.
-  Streams.

Survey Sept, 26, 27. 15
Scale: 2" = 1 mile.

Adjudication Survey
Trout Creek
and
Tributaries