


9-18779

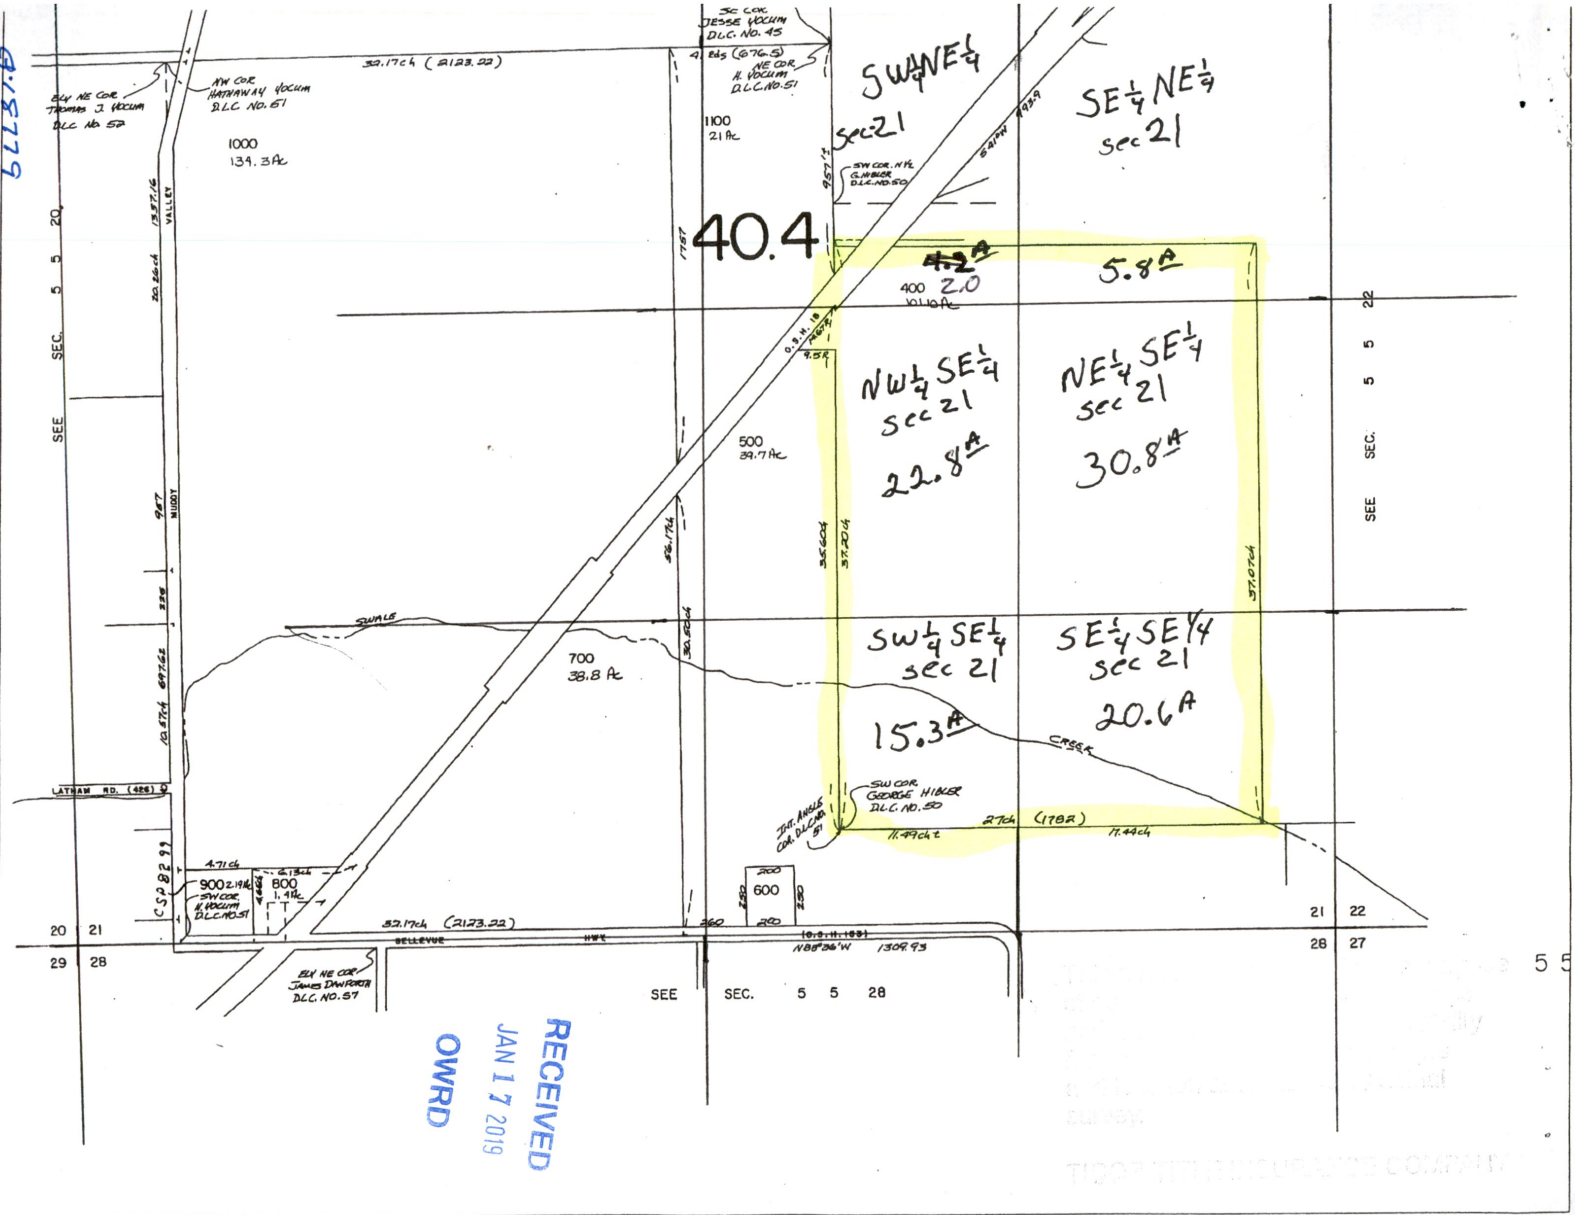

RECEIVED
 JAN 17 2019
 OWRD

TIDOR TITLE INSURANCE COMPANY


19-18779

THIS MAP WAS PREPARED FOR ASSESSMENT PURPOSE ONLY

SECTION 21 T5S R5W W.M. YAMHILL COUNTY 1" = 400'

5 5 21

CANCELLED

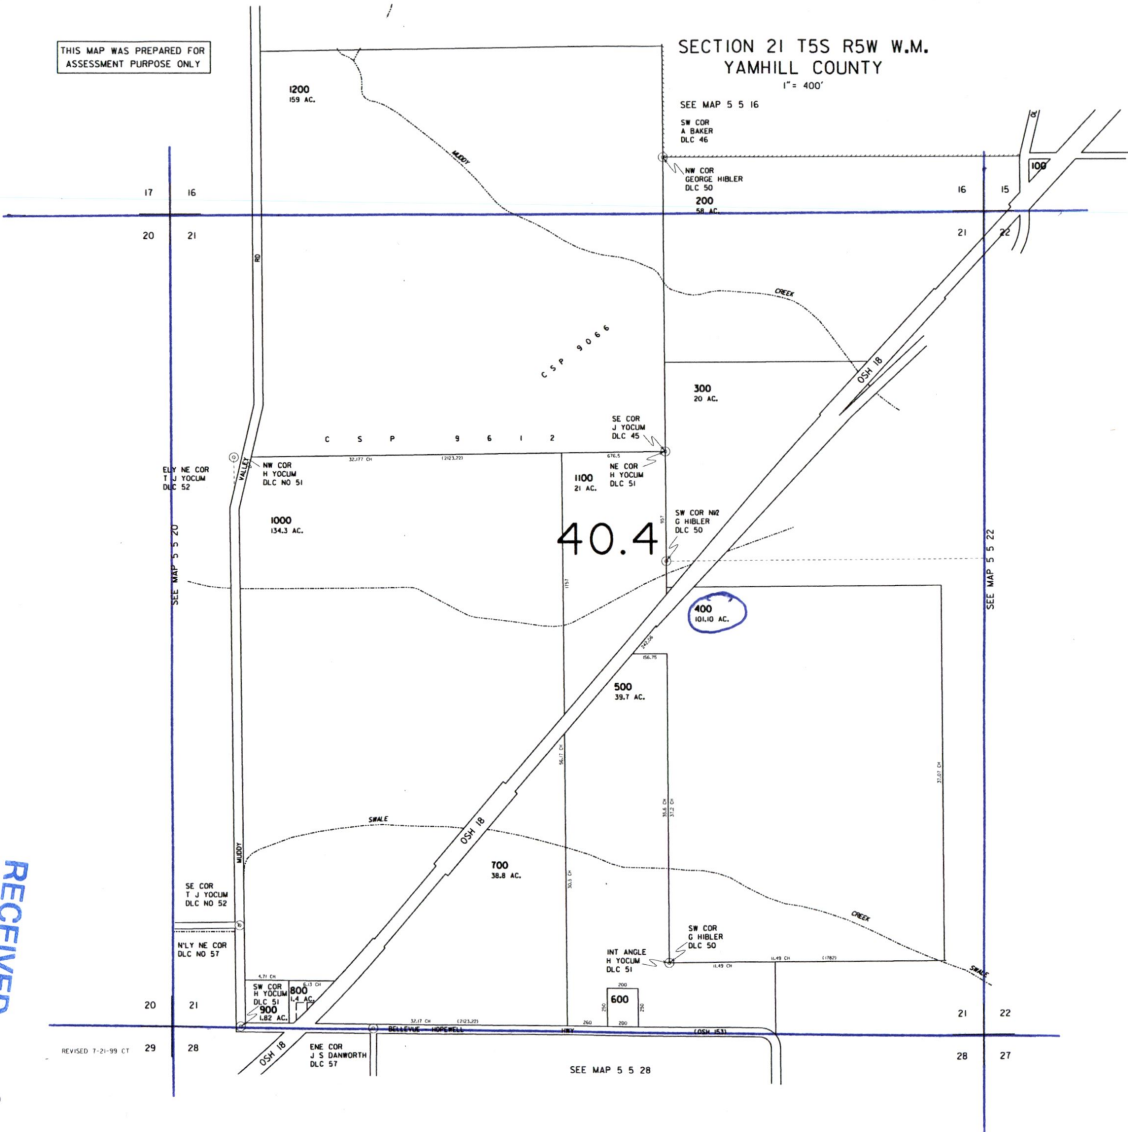

RECEIVED
JAN 17 2019
OWRD

5 5 21


1" = 1320'

100 acres irrigation



Tax Lot:

Township 5 South, Range 5 West, Section 21, Tax Lot 400

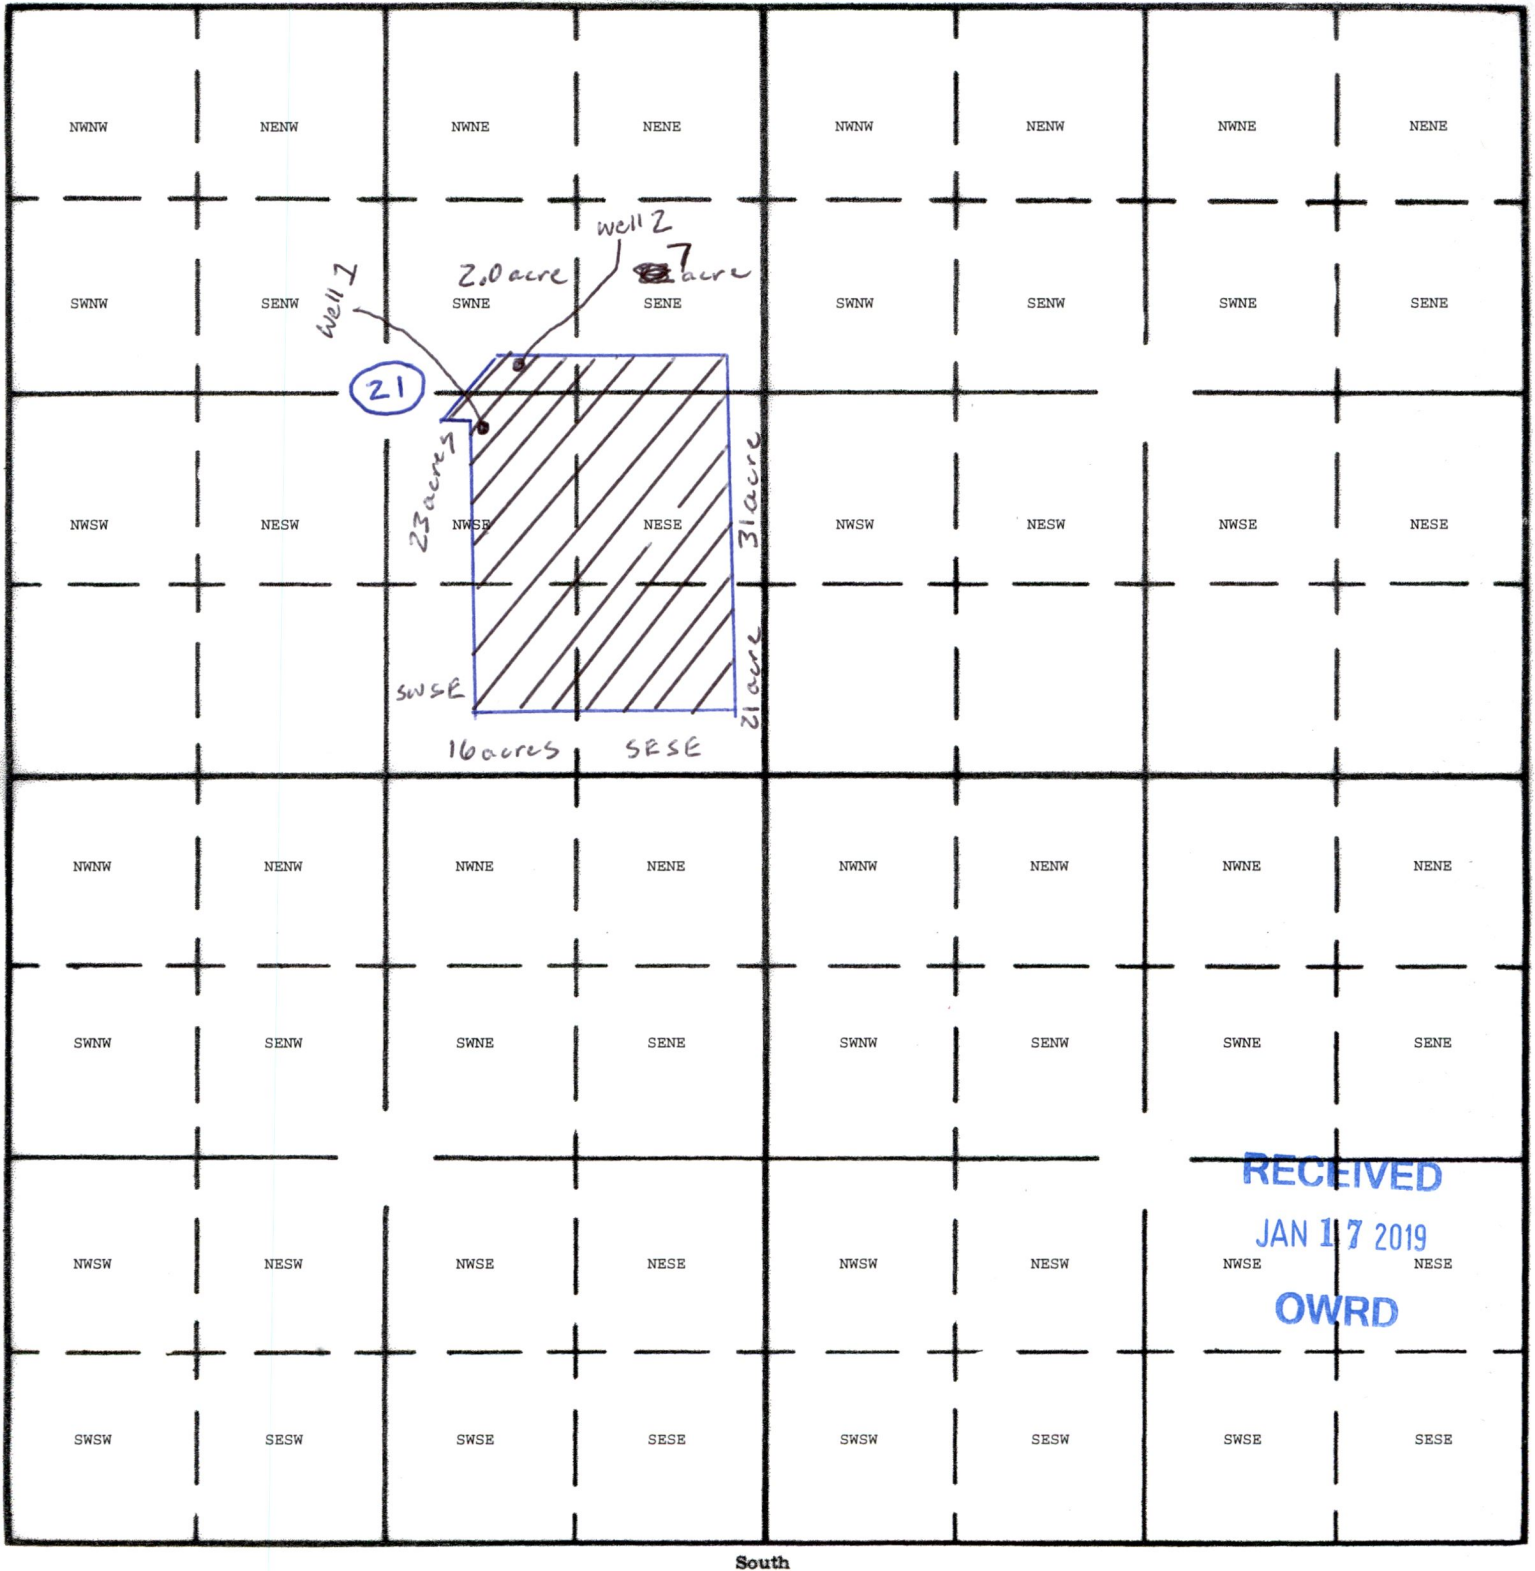

RECEIVED
 JAN 17 2019
 OWRD

Well 1 YAMH 54039: 2370 North and 1950 West from SE corner section 21
 Well 2: 2795 North and 1760 West from SE corner section 21

Markel Beavel 1-17-19