


SEC. 18 T.3N. R.1W. W.M.
COLUMBIA COUNTY

THIS MAP HAS BEEN PREPARED FOR ASSESSMENT PURPOSES ONLY

SEC. 17 T.3N. R.1W. W.M.
COLUMBIA COUNTY

THIS MAP HAS BEEN PREPARED FOR ASSESSMENT PURPOSES ONLY

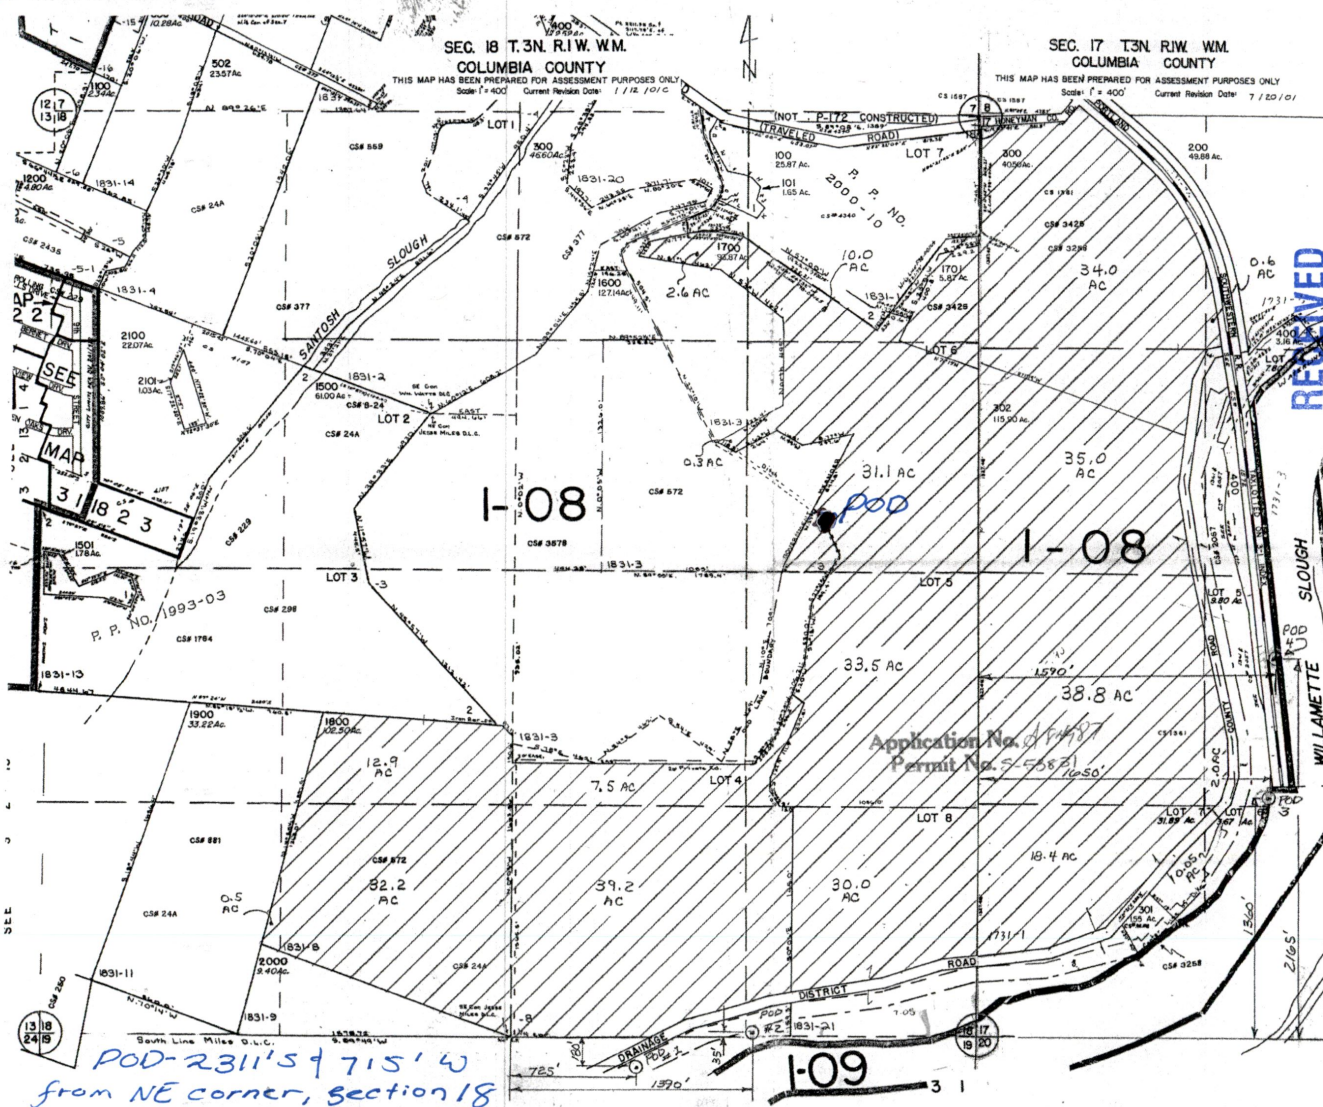

RECEIVED
DEC 12 2001
WATER RESOURCES DEPT

RECEIVED

JAN 17 2019

OWRD

designed by	date
drawn	12-7-01
checked	12-7-01
sheet no.	1 / 1
drawing no.	00-C-04

REPRODUCER OF THIS MAP IS FOR THE PURPOSE OF IDENTIFYING THE LOCATION OF THE PROPERTY DESCRIBED IN THE PERMIT TO PROVIDE AMENITIES AS INDICATED BY PROPERTY LINES AND LINES.




VERBOORT ENGINEERING
AGRICULTURE · CIVIL · WATER RESOURCES
HILLSBORO, OREGON

FRED and MARY ELLEN BERNET
51364 DIKE RD
SCAPPOOSE, OR 97056

from NE corner, Section 18

5-88694

Figure 1: Map of Division 33 Areas

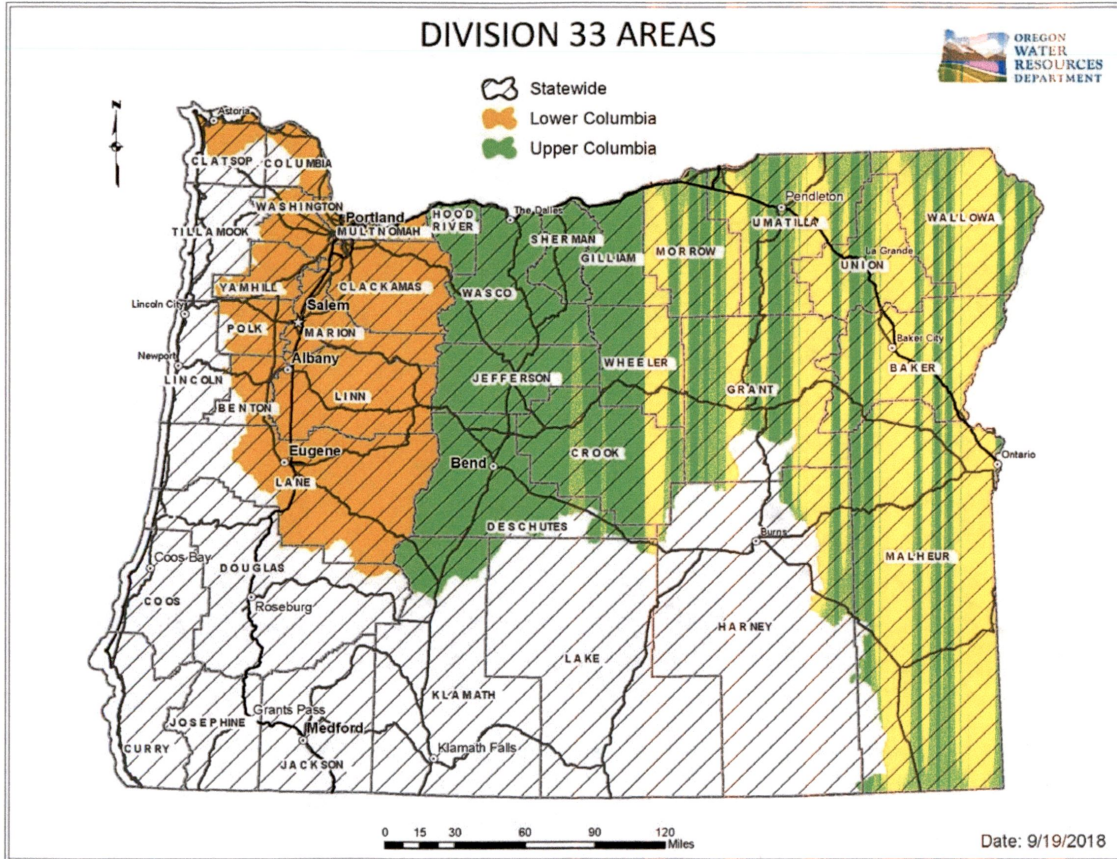

For more detailed information, click on the following link and enter the TRSQQ or the Lat/Long of a POD and click on "Submit" to retrieve a report that will show which section, if any, of the Division 33 rules apply: https://apps.wrd.state.or.us/apps/misc/lkp_trsqq_features/

5-88694

RECEIVED
JAN 17 2019
OWRD