




Polk County

Township 9 South, Range 5 West from the Willamette Meridian

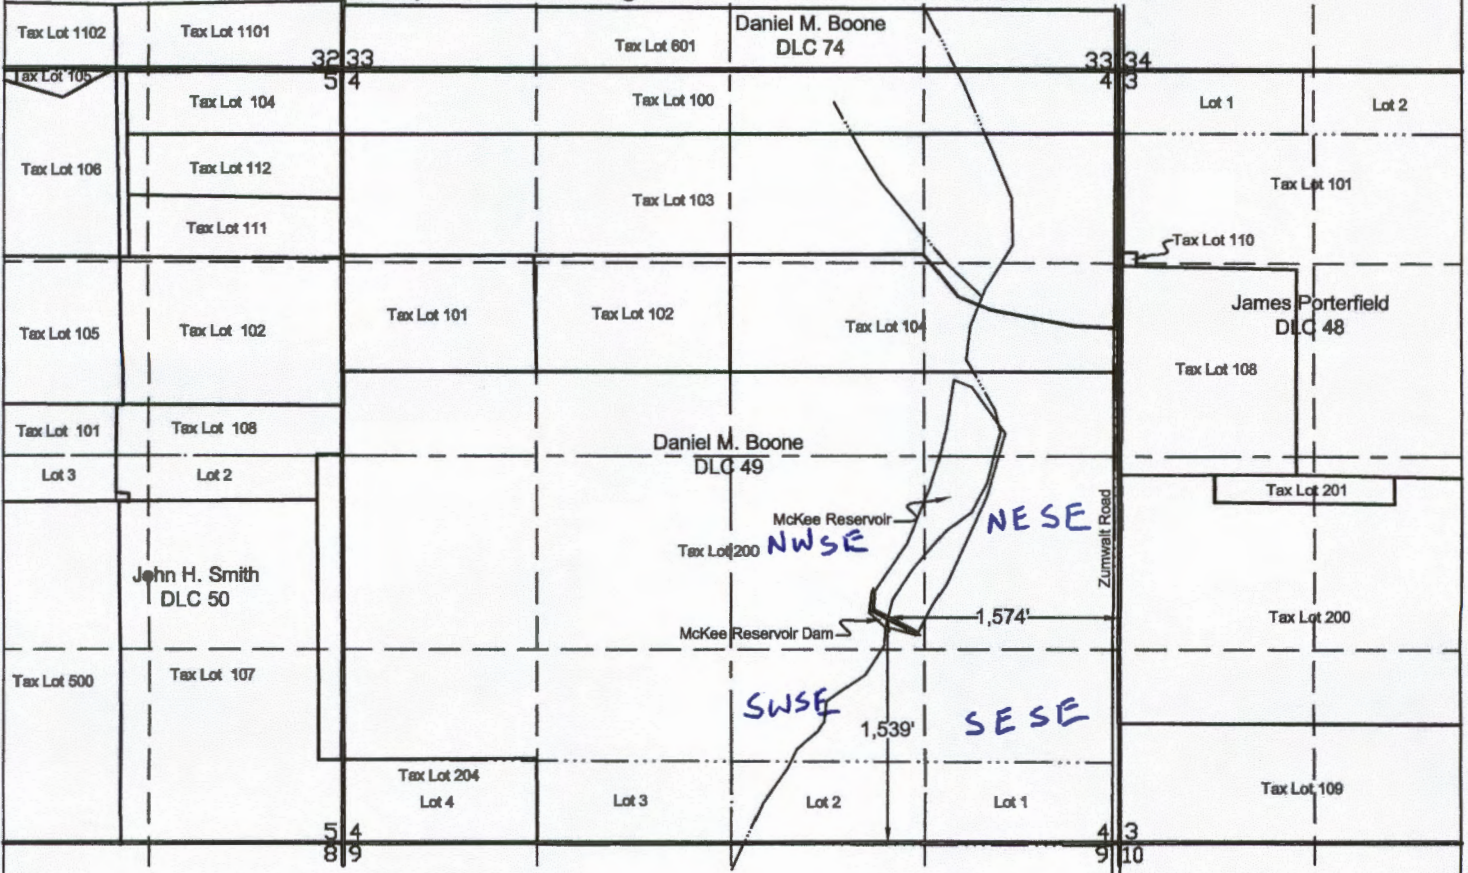

Map Legend

- - - - - Quarter Quarter Section Line
- - - - - Half Section Line
- Section Line
- Tax Lot Boundary Line
- DLC Boundary Line
- Intermittent Stream

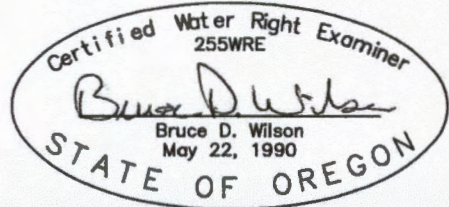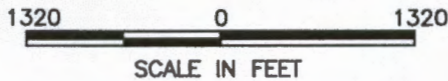

RECEIVED

DEC 09 2016

WATER RESOURCES DEPT
SALEM, OREGON

PERMIT APPLICATION MAP

FOR

Application R-_____ Permit R-_____
in the name of

McKee Properties LLC

McKee Reservoir Dam is located 1,574 feet west and 1,539 feet north of the southeast corner of Section 4, Township 9 South, Range 5 West from the Willamette Meridian. The McKee Reservoir is located in the northwest of the southeast $\frac{1}{4}$, the northeast of the southeast $\frac{1}{4}$ and the southeast of the northeast $\frac{1}{4}$ of Section 4, Township 9 South, Range 5 West from the Willamette Meridian. The McKee Dam and Reservoir are located within the Daniel M. Boone DLC 49 and Tax Lot 200.

NOTE: THIS MAP WAS PREPARED FOR THE PURPOSE OF IDENTIFYING THE LOCATION OF A WATER RIGHT ONLY AND IS NOT INTENDED TO PROVIDE LEGAL DIMENSIONS OR LOCATION OF PROPERTY OWNERSHIP LINES.

R-08238

R-88338

Monmouth



Google Earth
RECEIVED



CORVALLIS

DEC 09 2016

WATER RESOURCES DEPT
 SALEM, OREGON

2-8878

[Disclaimer](#) [Ug](#)


Search Tools

Sketch Tools

Advanced Tools

Print Map

Simple Taxlot Search

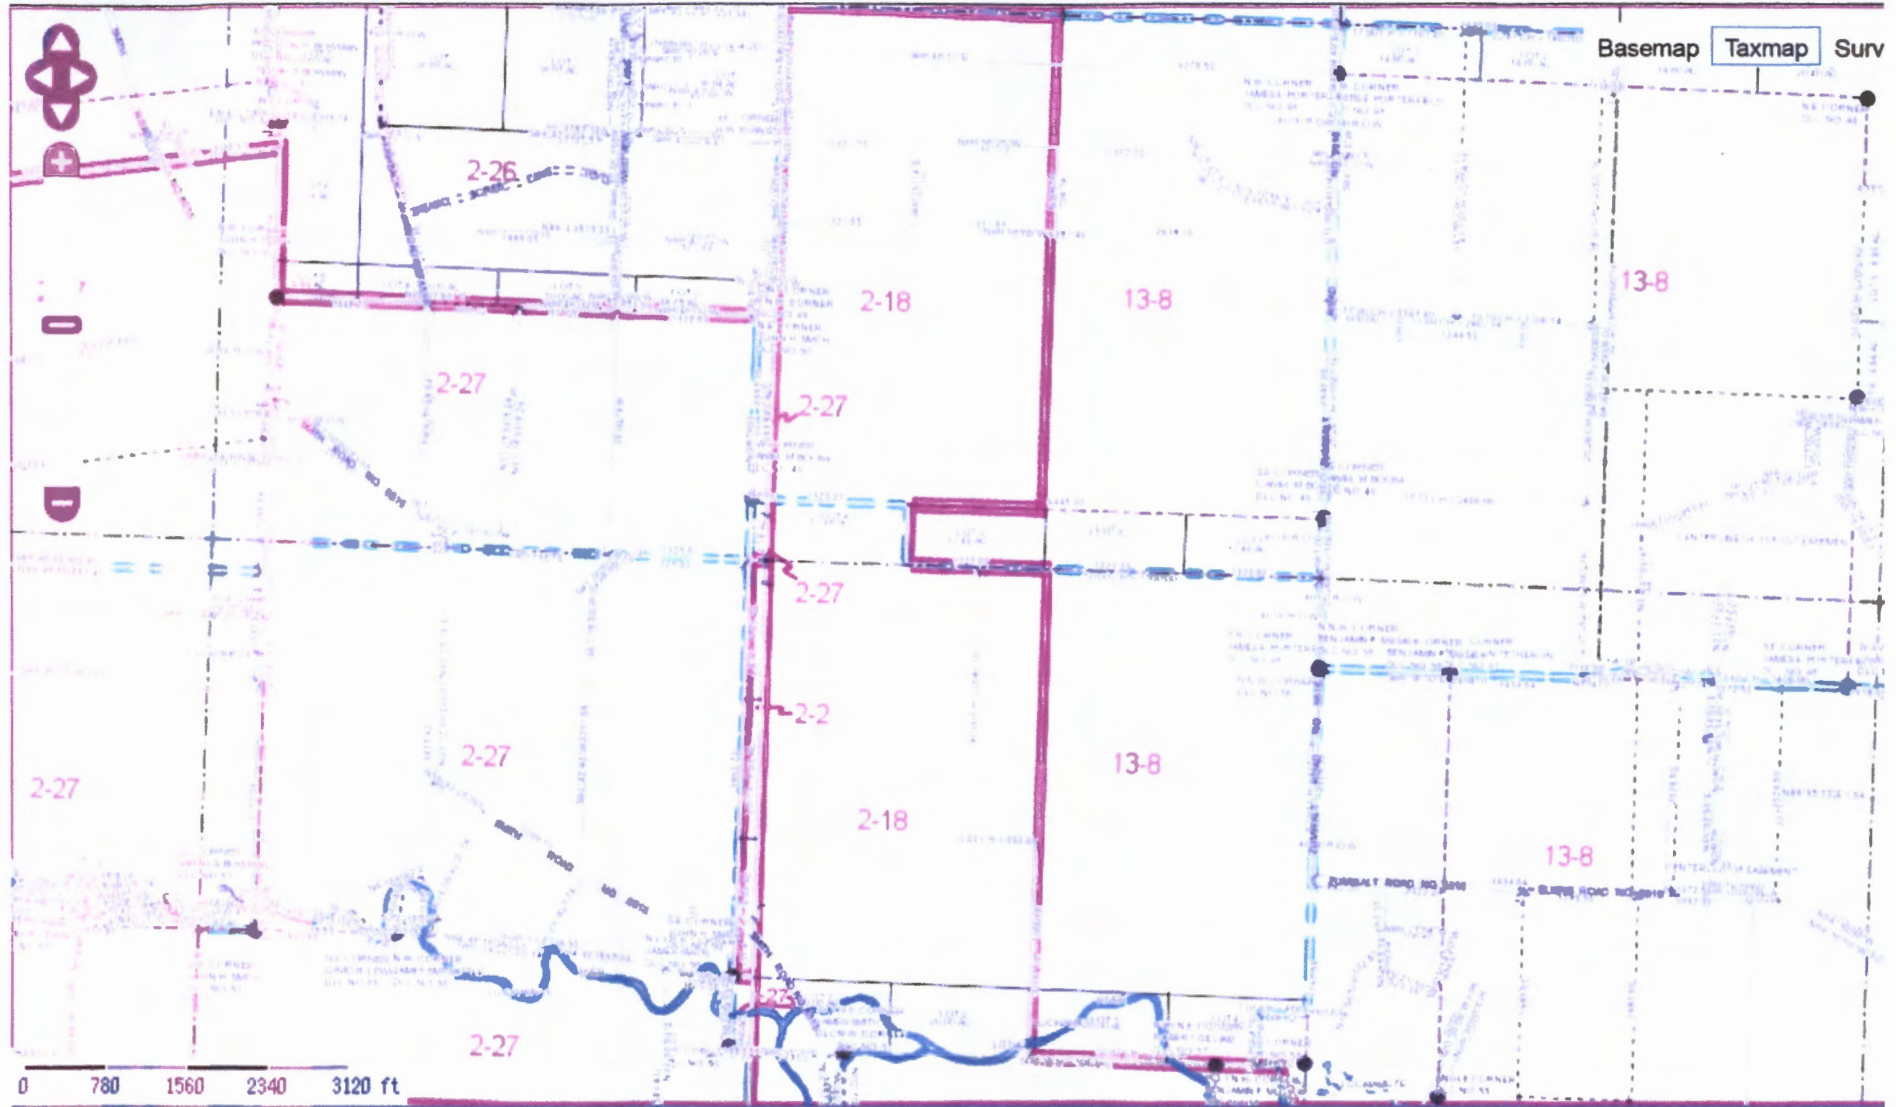

Basemap Taxmap Surv

0 780 1560 2340 3120 ft

GM-OR-2.6.1 1:16435

X,Y: 7477496, 431500 Lat, Lon: 44.816, -123.293 USNG: 10TDQ76836254

RECEIVED

DEC 09 2016

WATER RESOURCES DEPT
SALEM, OREGON

2-8222

[Disclaimer](#) [Up](#)


Search Tools

Sketch Tools

Advanced Tools

Print Map

Simple Taxlot Search

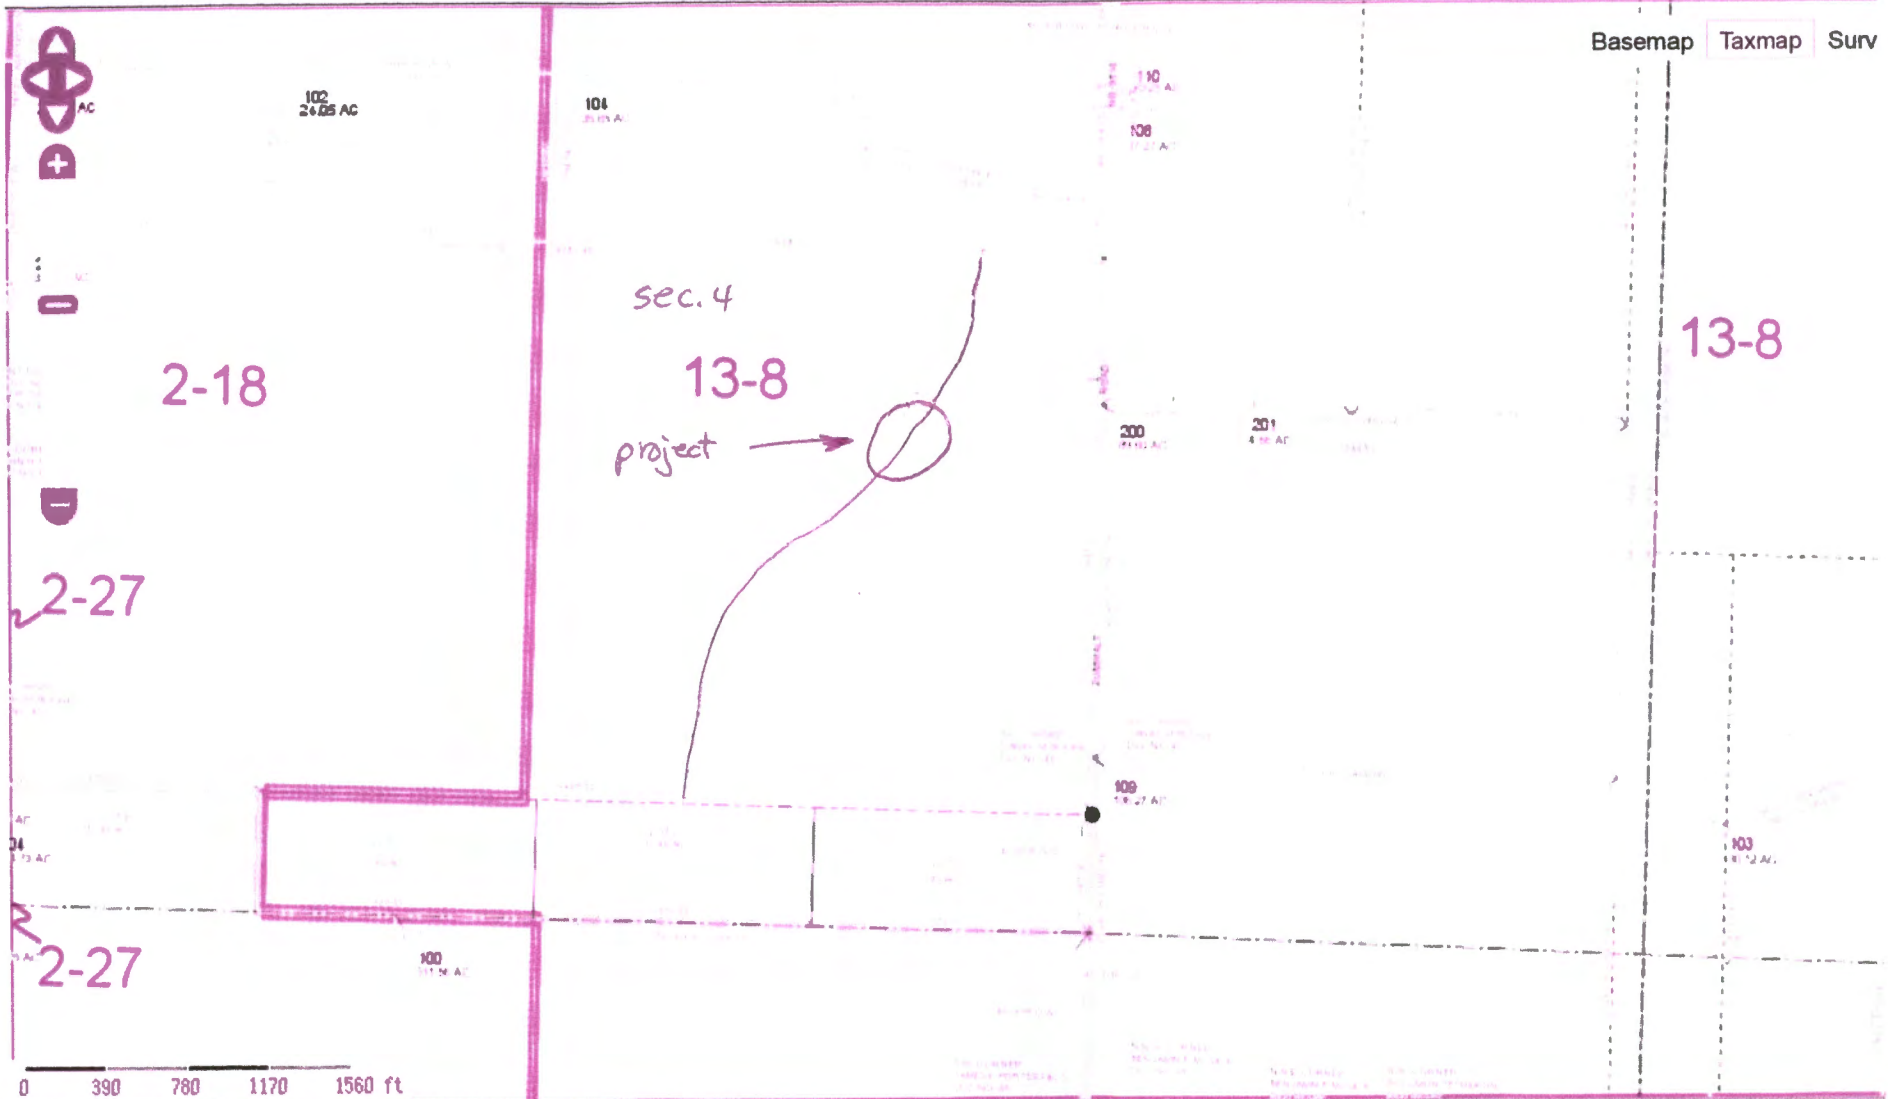

Basemap Taxmap Surv


GM-OR-2.6.1 1:8218





X,Y: 7479308, 432989 Lat, Lon: 44.820, -123.286 USNG: 10TDQ7737163010

RECEIVED

DEC 09 2016

WATER RESOURCES DEPT
SALEM, OREGON

 Oregon Water Resources Department
Water Rights Mapping Tool

 Main
 Return  Contact Us 

Search

Identify Non-Water Right Features


Tax Lots

Tools

Layers

- Water Rights by Type
- Water Rights by Use
- Water Rights by Type-Use
- Water Rights by Prim./Suppl'
- Water Rights - Municipal Only
- Administrative Boundaries
- Rules
- Surface Water
- Hydrography
- River miles
- Transportation
- Stream Gages
- PODs by Source Type
- PLSS
- PLSS (1:30K)
- Townships

Print

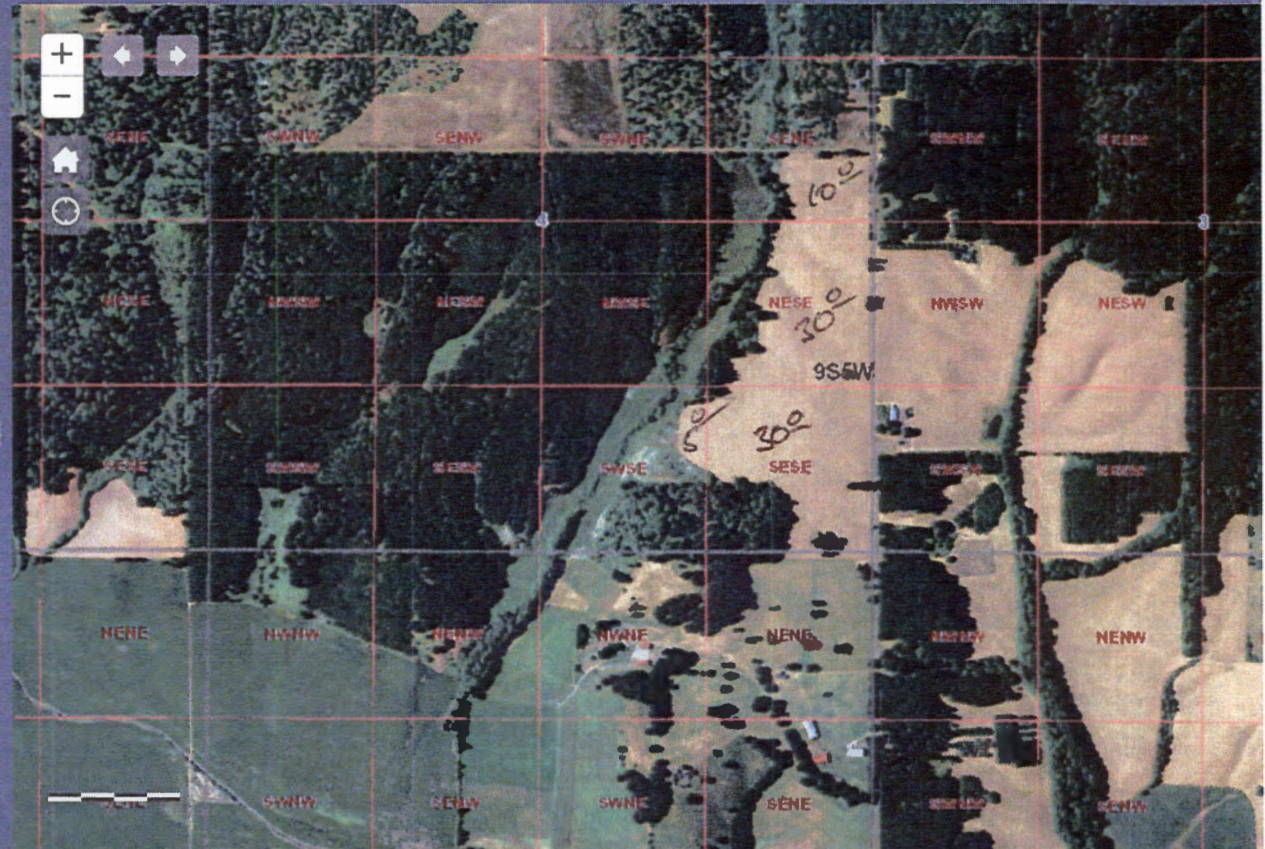


POD POU

RECEIVED

DEC 09 2016

WATER RESOURCES DEPT
SALEM, OREGON


R-88338

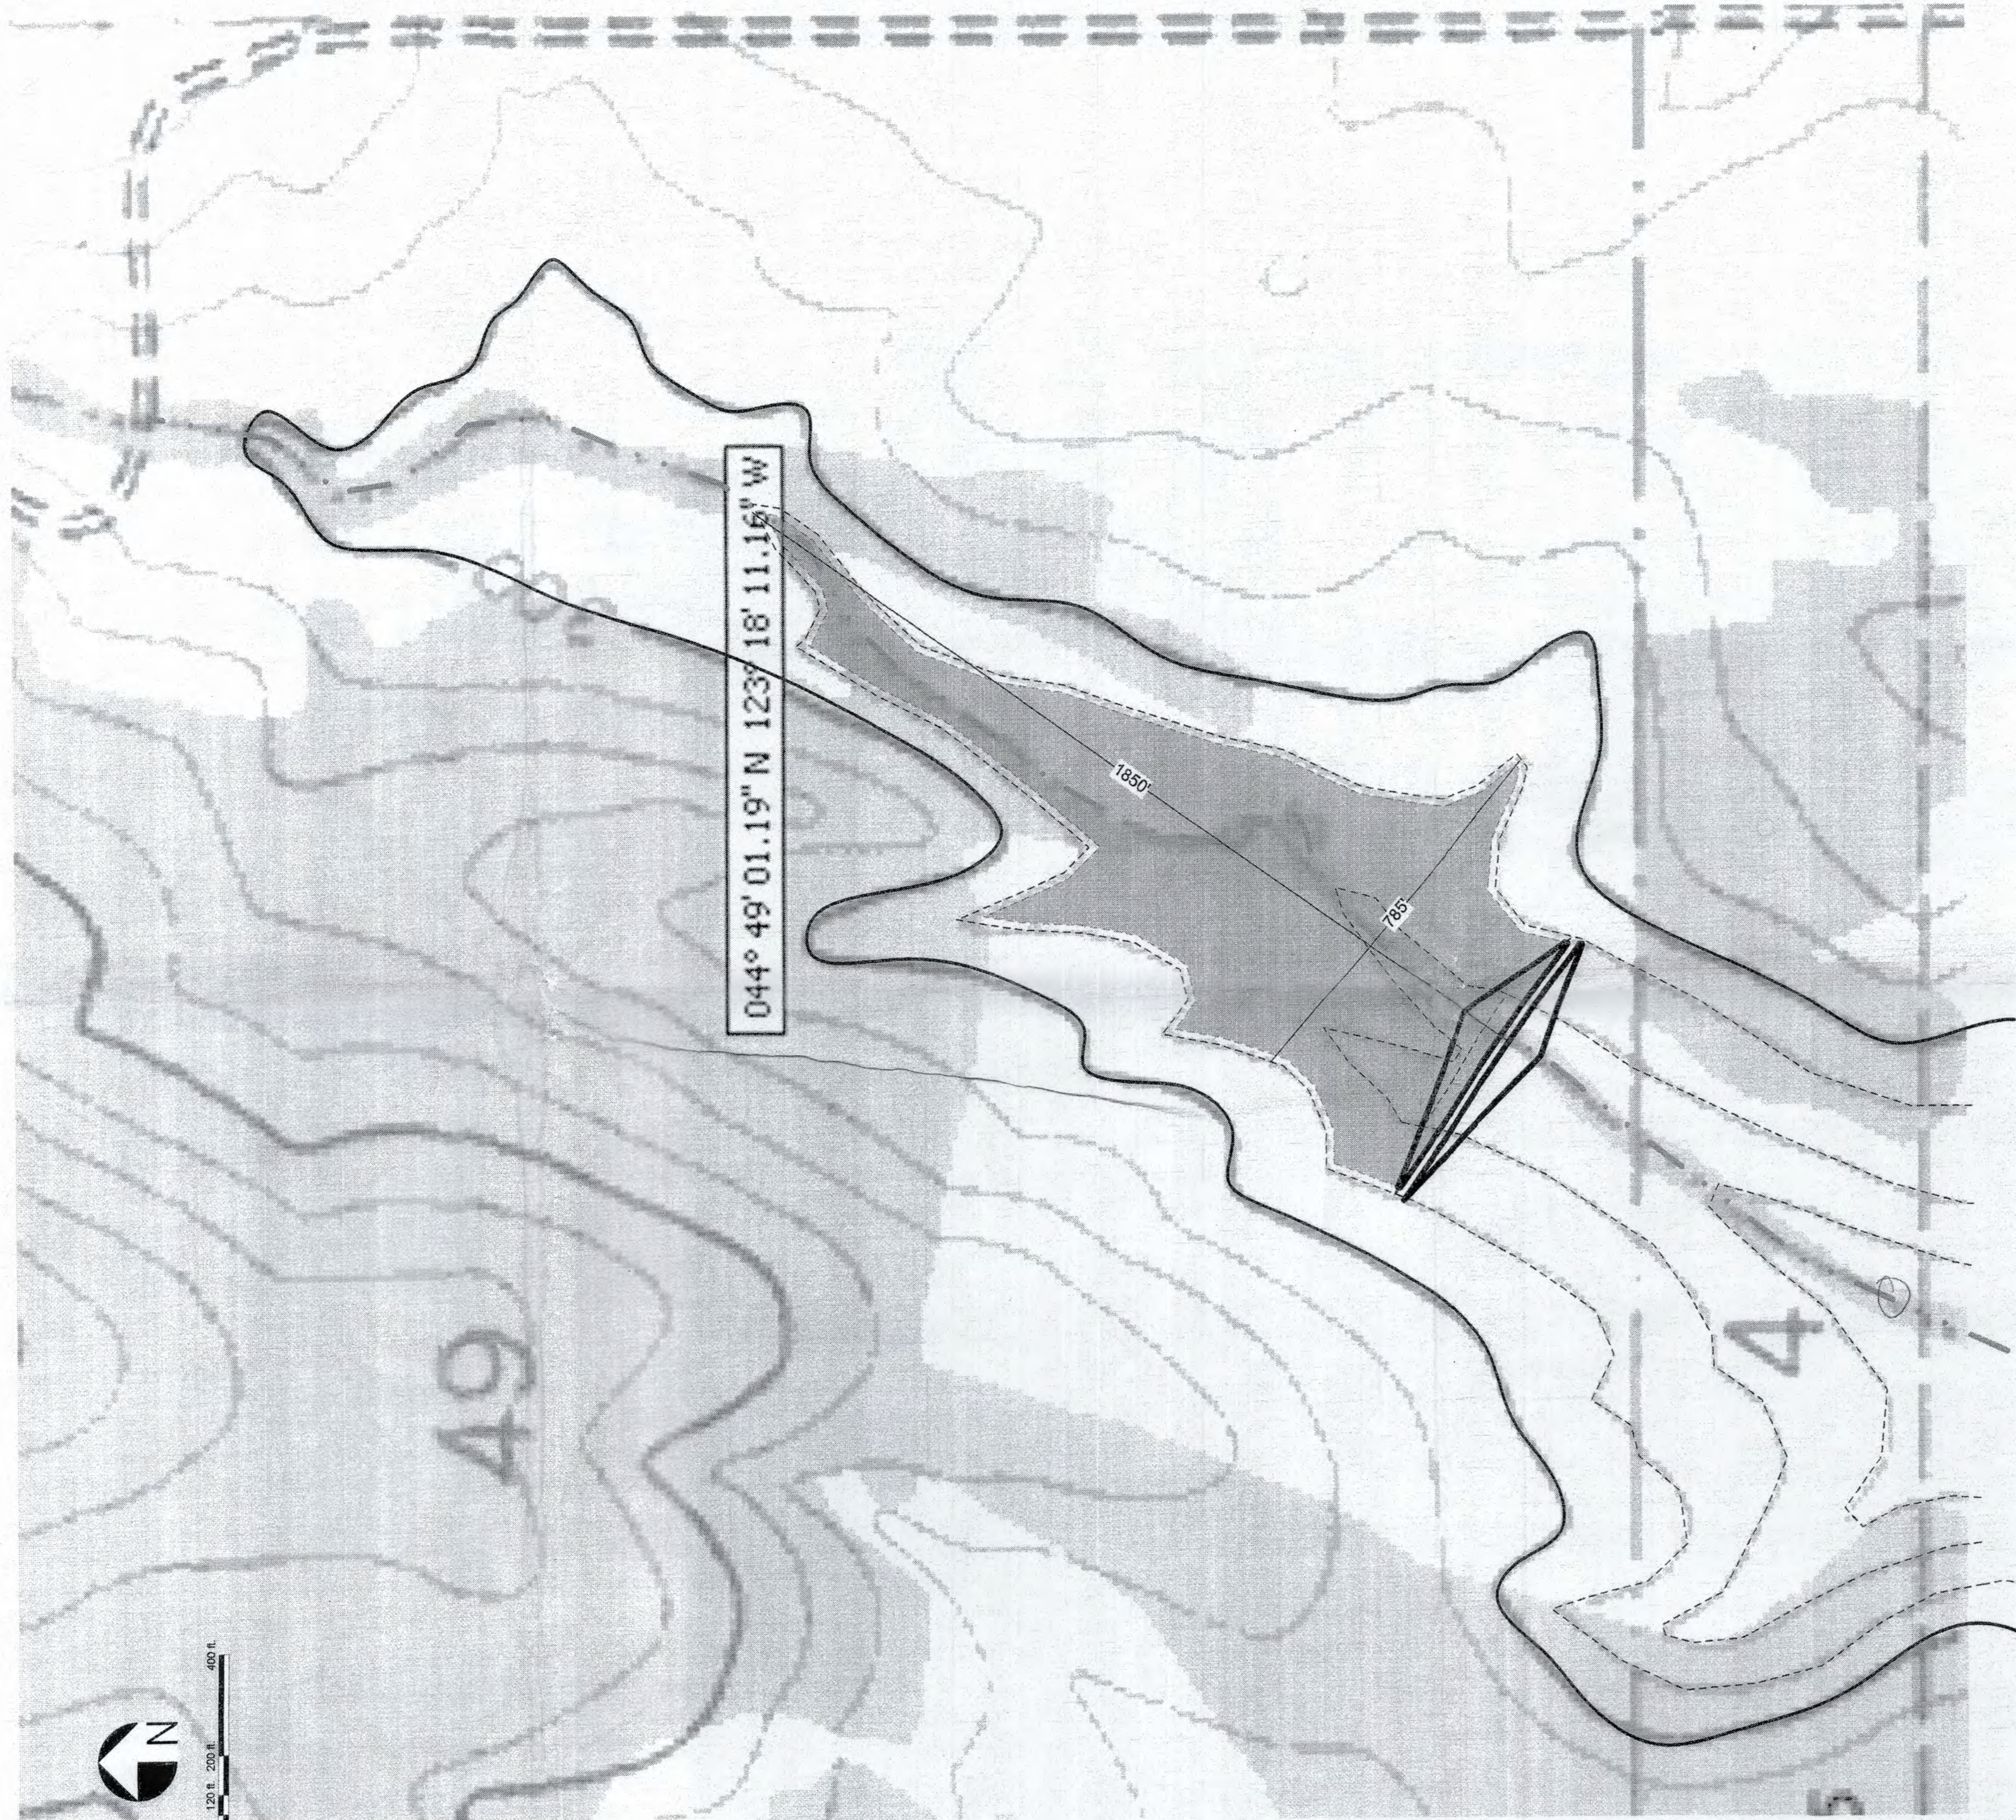

Preliminary Design Pool Characteristics:

Pool Area = 14.1 acres
 Pool Volume = 150 acre-feet = ~55 million gallons

Dam Height = ~23 feet
 Dam Length = ~680 feet
 Dam Volume = ~23,000 cubic yards

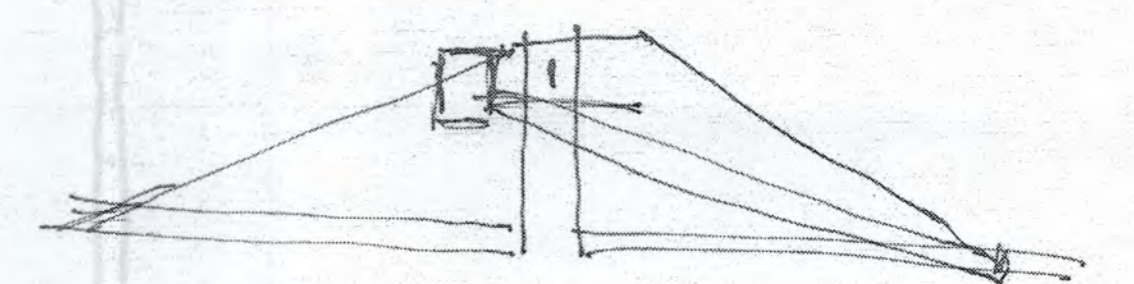

RECEIVED

DEC 09 2016

WATER RESOURCES DEPT
 SALEM, OREGON

Rev:	Date:

Project No.
05-RF-001

Date: October

Designed: R. S.

Engineer: R. S.

Checked:

Sheet Title
 Preliminary

Sheet No.

C1

Proposed Dam Location



Oregon Water Resources Department
Water Rights Mapping Tool

- Main
- Help
- OWRD Only
- Return
- Contact Us

725 Summer St NE, Salem

Search

Search: TRS

Public Land Survey System

Meridian: WM

Township: 9 N S

Range: 5 W E

Section: 4 (optional)

(Draw box on map.)

Description: WM9S5W4

Identify Non-Water Right Features

Tax Lots

Tools

Layers

Bookmarks



R-88338 3-29-17

R-88138

Monmouth



Google Earth
RECEIVED



Corvallis

DEC 09 2016

WATER RESOURCES DEPT
 SALEM, OREGON

2-2627

[Disclaimer](#) [Up](#)


Search Tools

Sketch Tools

Advanced Tools

Print Map

Simple Taxlot Search

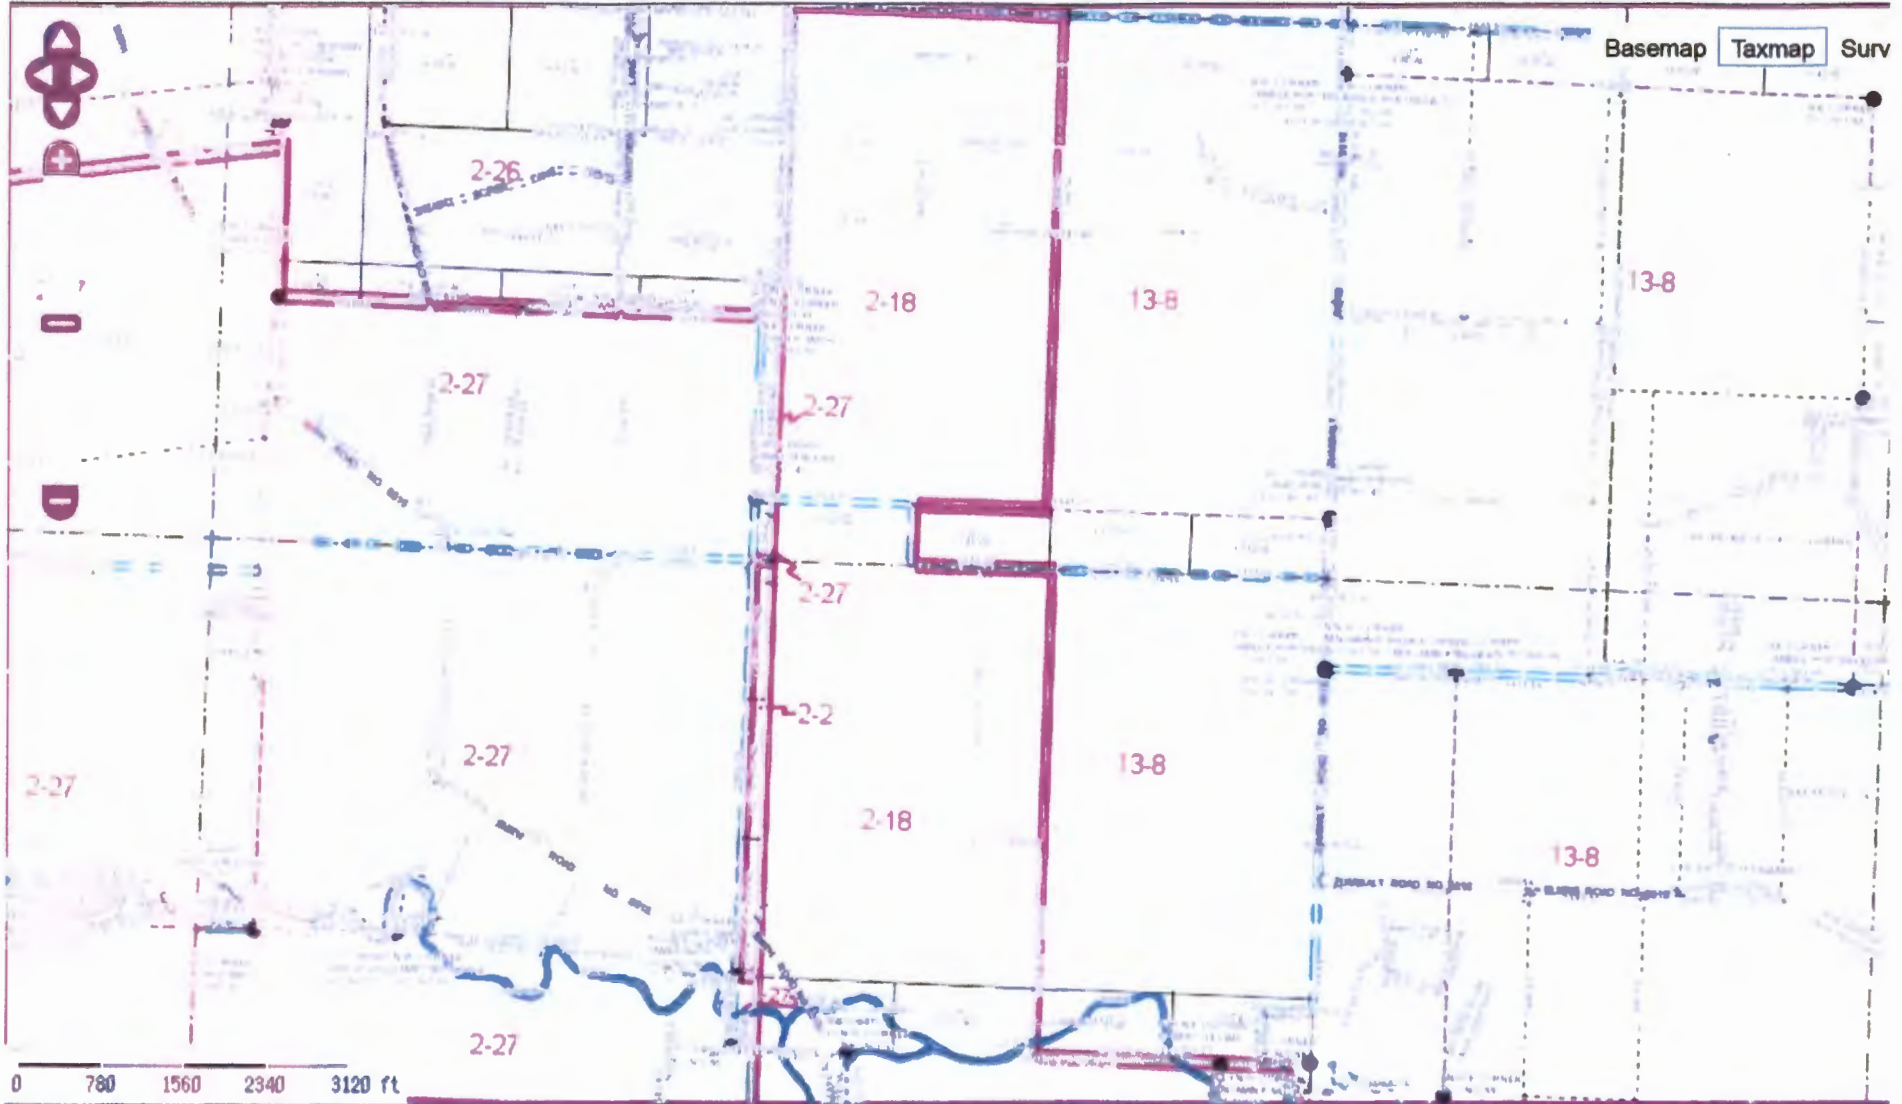

Basemap Taxmap Surv

GM-OR-2.6.1 1:16435

X,Y: 7477496, 431500 Lat, Lon: 44.816, -123.293 USNG: 10TDQ76836254

RECEIVED

DEC 09 2016

WATER RESOURCES DEPT
SALEM, OREGON

2-08228

[Disclaimer](#) [Up](#)

Search Tools

Sketch Tools

Advanced Tools

Print Map

Simple Taxlot Search

Basemap

Taxmap

Surv



102
24.65 AC

104
10.14 AC

110
1.17 AC

108
1.17 AC

200
2.00 AC

201
4.00 AC

100
1.17 AC

103
1.17 AC

sec. 4

13-8

project →

13-8

2-18

2-27

2-27

100
1.17 AC

0 390 780 1170 1560 ft

GM-OR-2.6.1

1:8218

X,Y: 7479308, 432989 Lat, Lon: 44.820, -123.286 USNG: 10TDQ7737163010

RECEIVED

DEC 09 2016

WATER RESOURCES DEPT
SALEM OREGON

Oregon Water Resources Department
Water Rights Mapping Tool

Search

Identify Non-Water Right Features

Tax Lots

Tools

Layers

- + Water Rights by Type
- + Water Rights by Use
- + Water Rights by Type-Use
- + Water Rights by Prim./Suppl
- + Water Rights - Municipal Only
- + Administrative Boundaries
- + Rules
- + Surface Water
 - Hydrography
 - River miles
- + Transportation
- + Stream Gages
- + PODs by Source Type
- PLSS
 - PLSS (1:30K)
 - Townships

Print

POD POU

RECEIVED

DEC 09 2016

WATER RESOURCES DEPT
SALEM, OREGON

R-88338