

RECEIVED


DEC 21 1994

WATER RESOURCES DEPT

SALEM, OREGON

Application No. R-80200
Permit No.
→ DOUGLAS CO. -78

5-8-78

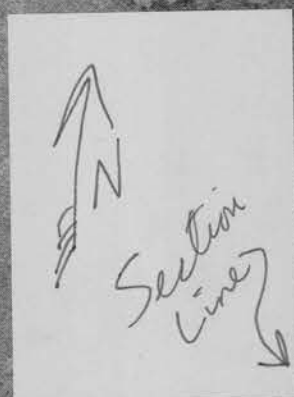

DOUGLAS COUNTY SURVEYOR

T 24 S - R 5 W Sec. 4

1" = 400'

(Section lines are approximate)