




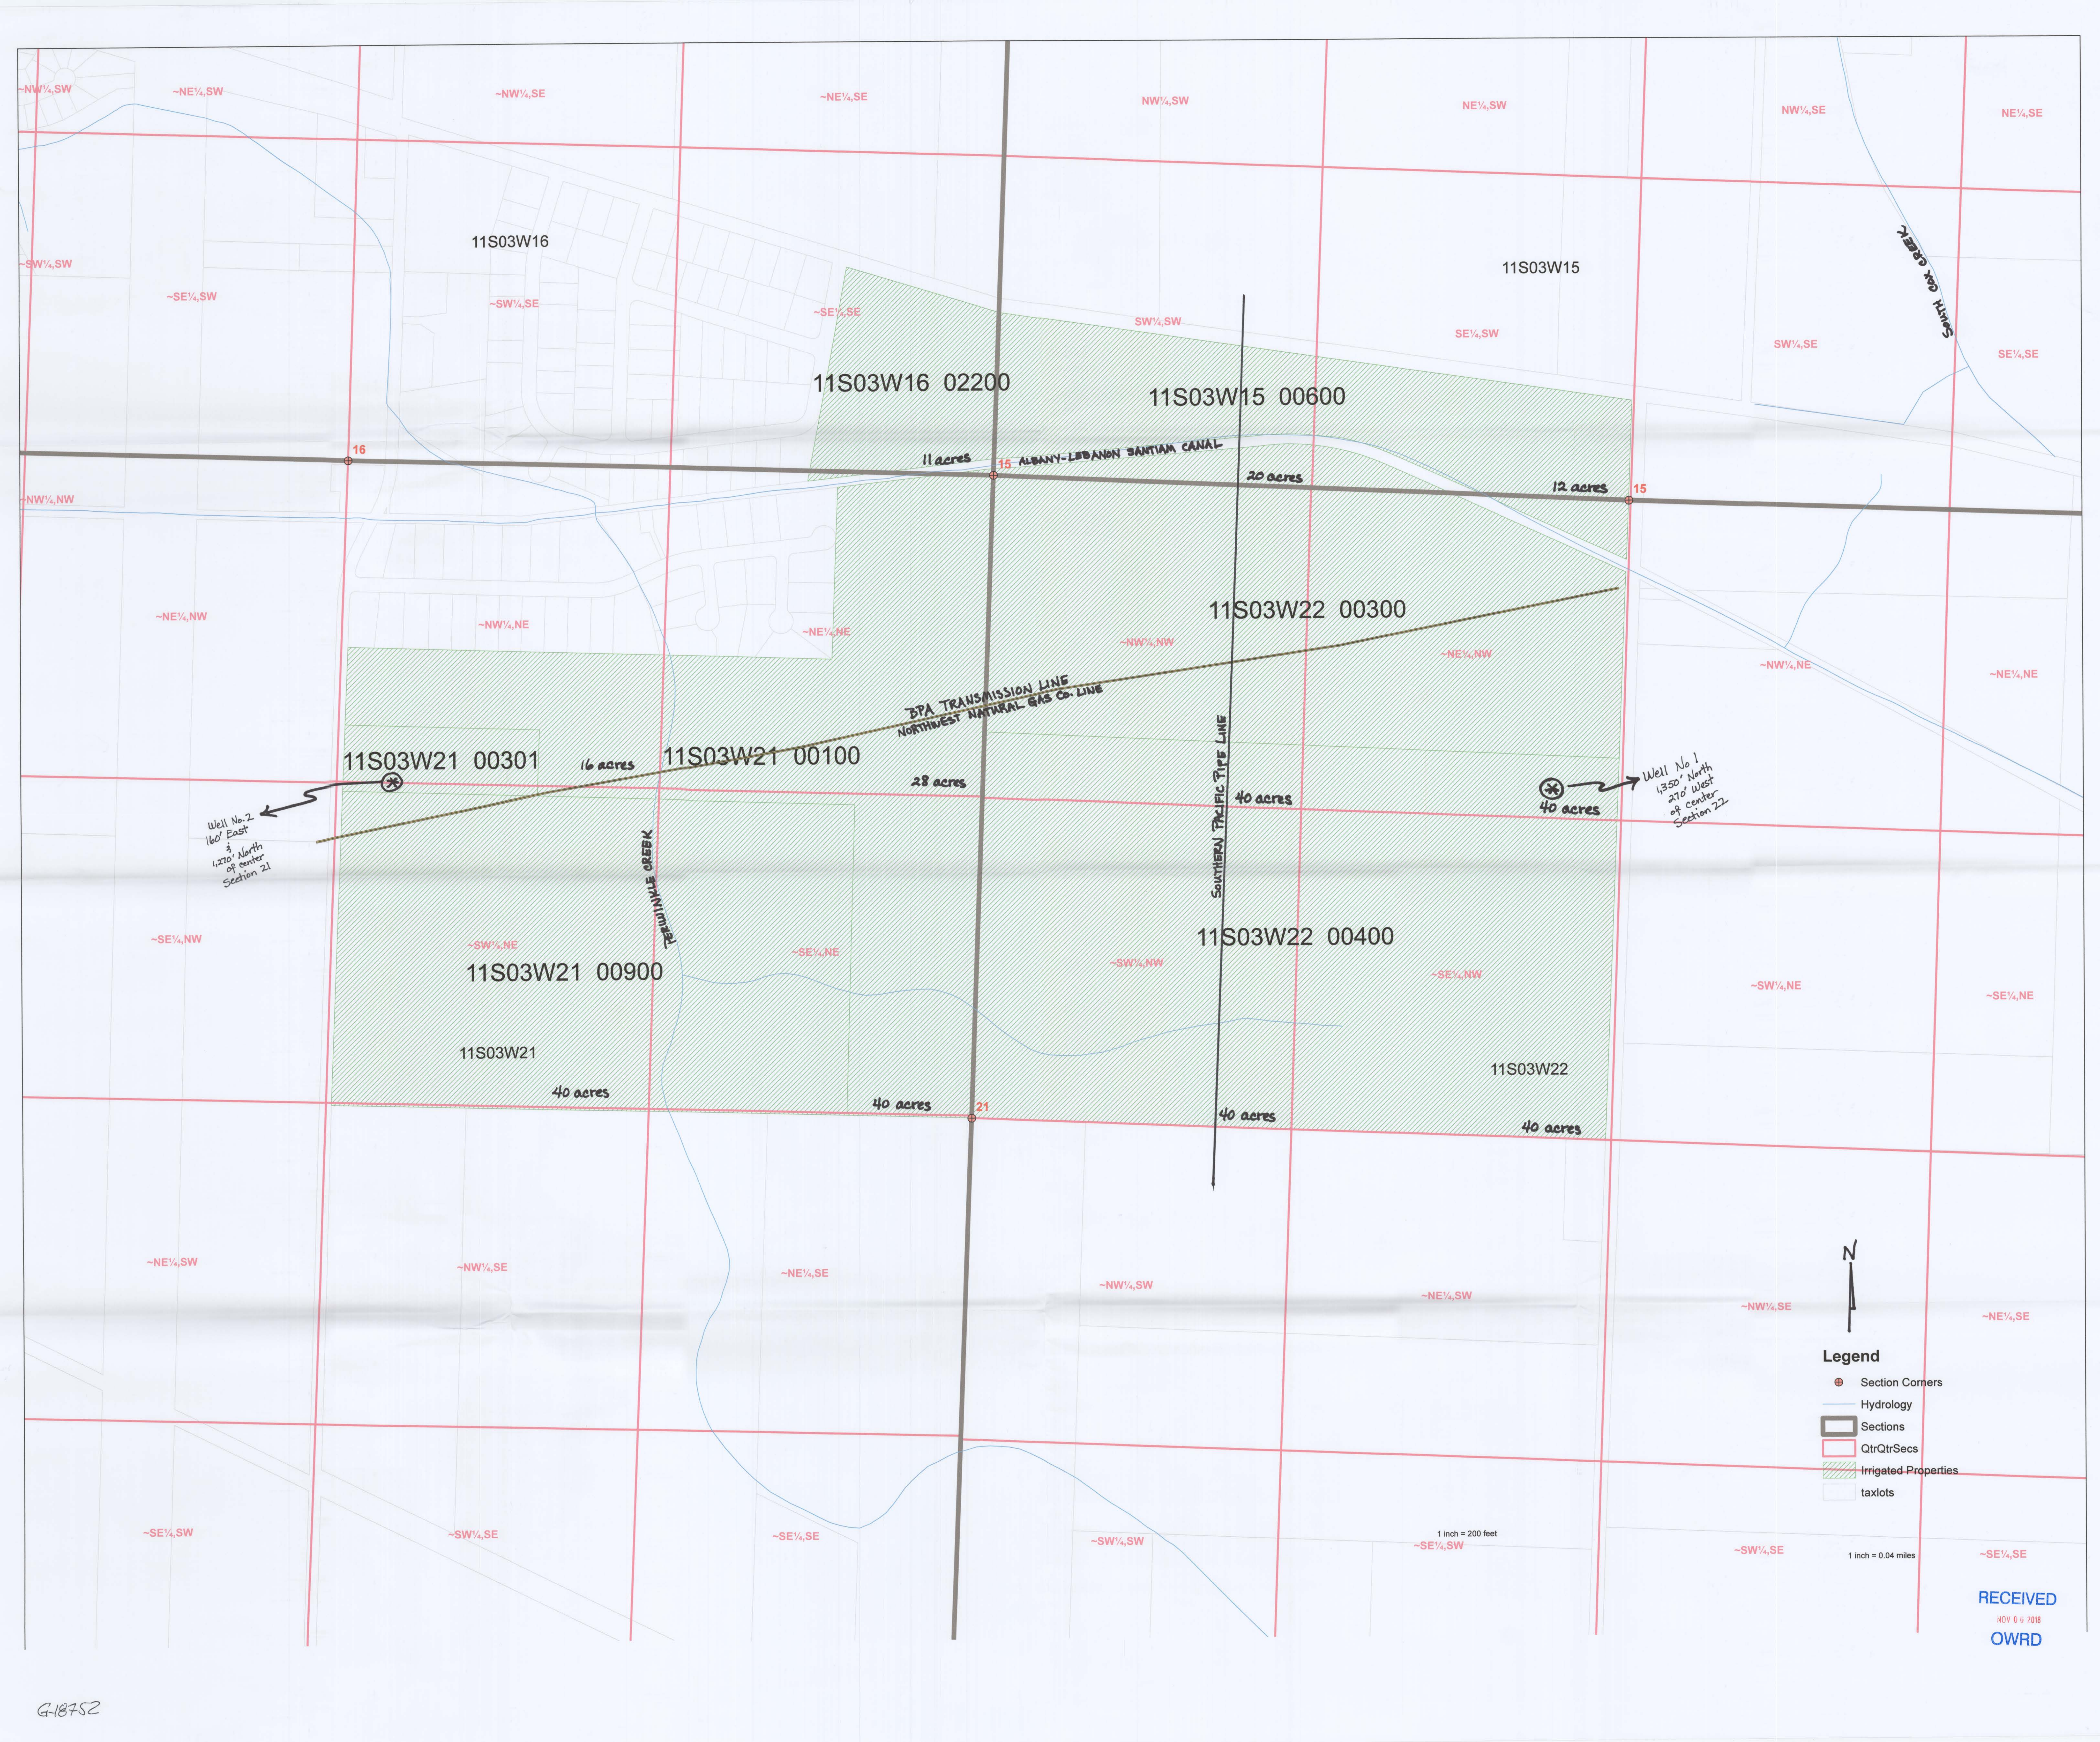

-NW¼,SW    -NE¼,SW    -NW¼,SE    -NE¼,SE    NW¼,SW    NE¼,SW    NW¼,SE    NE¼,SE  
 -SW¼,SW    -SE¼,SW    -SW¼,SE    -SE¼,SE    SW¼,SW    SE¼,SW    SW¼,SE    SE¼,SE  
 -NW¼,NW    -NE¼,NW    -NW¼,NE    -NE¼,NE    -NW¼,NW    -NE¼,NW    -NW¼,NE    -NE¼,NE  
 -SE¼,NW    -SW¼,NE    -SE¼,NE    -SW¼,NW    -SE¼,NW    -SW¼,NE    -SE¼,NE  
 -NE¼,SW    -NW¼,SE    -NE¼,SE    -NW¼,SW    -NE¼,SW    -NW¼,SE    -NE¼,SE  
 -SE¼,SW    -SW¼,SE    -SE¼,SE    -SW¼,SW    -SE¼,SW    -SW¼,SE    -SE¼,SE

11S03W16    11S03W15  
 11S03W16 02200    11S03W15 00600  
 11S03W21 00301    11S03W21 00100    11S03W22 00300  
 11S03W21 00900    11S03W22 00400  
 11S03W21    11S03W22

16 acres    11 acres    20 acres    12 acres  
 16 acres    28 acres    40 acres    40 acres  
 40 acres    40 acres    40 acres    40 acres

ALBANY-LEBANON SANTIAM CANAL  
 DPA TRANSMISSION LINE  
 NORTHWEST NATURAL GAS CO. LINE  
 SOUTHERN PACIFIC PIPE LINE  
 TERMINUS CREEK

Well No. 2  
 160' East  
 1/20' North  
 of center  
 Section 21

Well No. 1  
 1350' North  
 270' West  
 of center  
 Section 22

1 inch = 200 feet  
 1 inch = 0.04 miles

**Legend**

- ⊕ Section Corners
- Hydrology
- ▭ Sections
- ▭ QtrQtrSecs
- ▨ Irrigated Properties
- ▭ taxlots

RECEIVED  
 NOV 6 6 2018  
 OWRD

G-18752