


Bielenberg WR App

1" = 1320'

Tax Lot:



Township 5 South, Range 1 East, Section 25 & 36, Tax Lot 1600 & 300 + 100

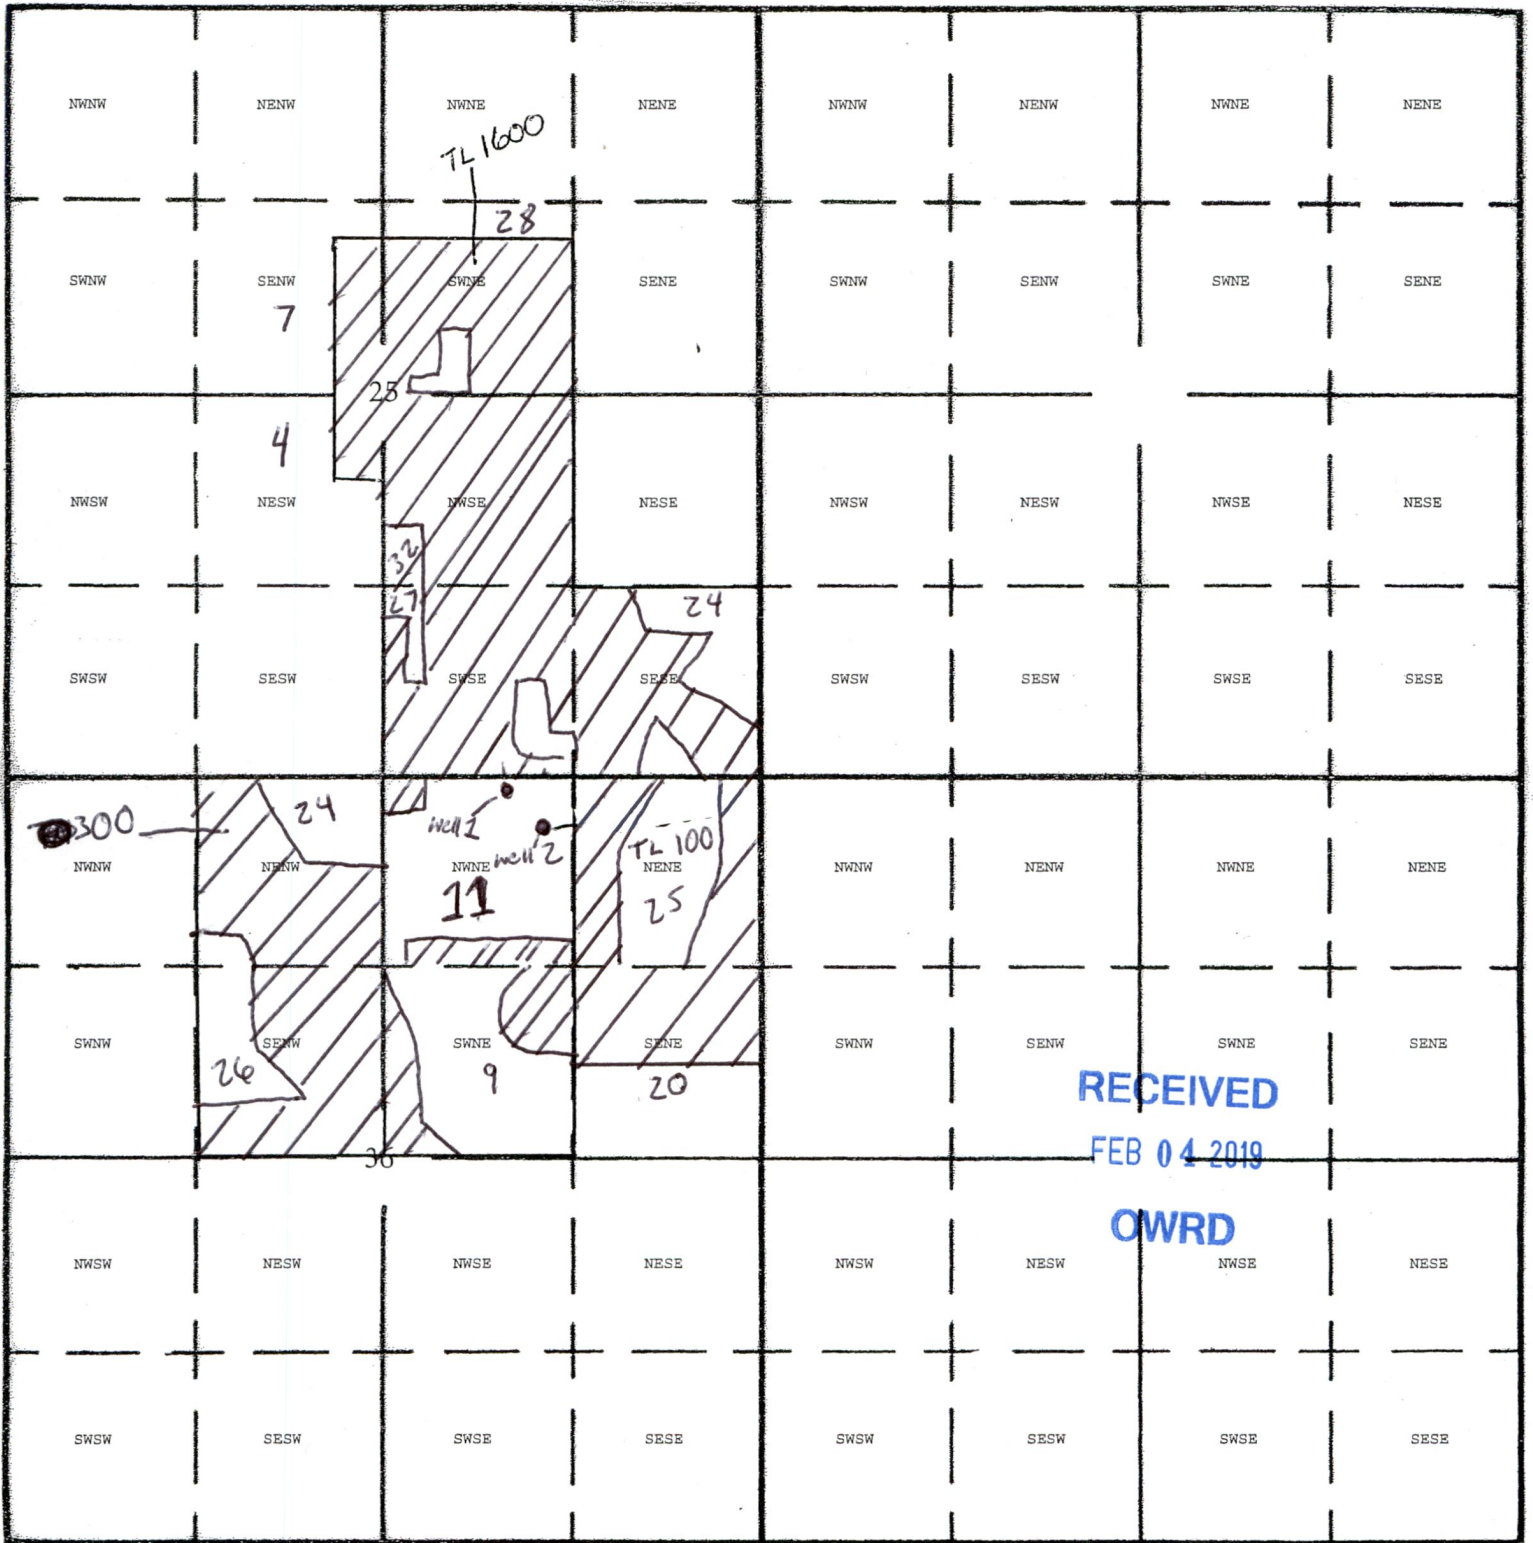

RECEIVED

FEB 04 2019

OWRD

South

Well 1: 70 south + 1800 West NE Corner sec 36
 Well 2: 340 south + 1500 West NE Corner sec 36

- 237 acres

G-18787

David Bit 1/31/2019


This map was prepared for assessment purpose only.

SECTION 25 T5S. R.I.E. W.M.
CLACKAMAS COUNTY

DLC
GEO. W. JACKSON NO. 38

5 IE 25

1" = 400'

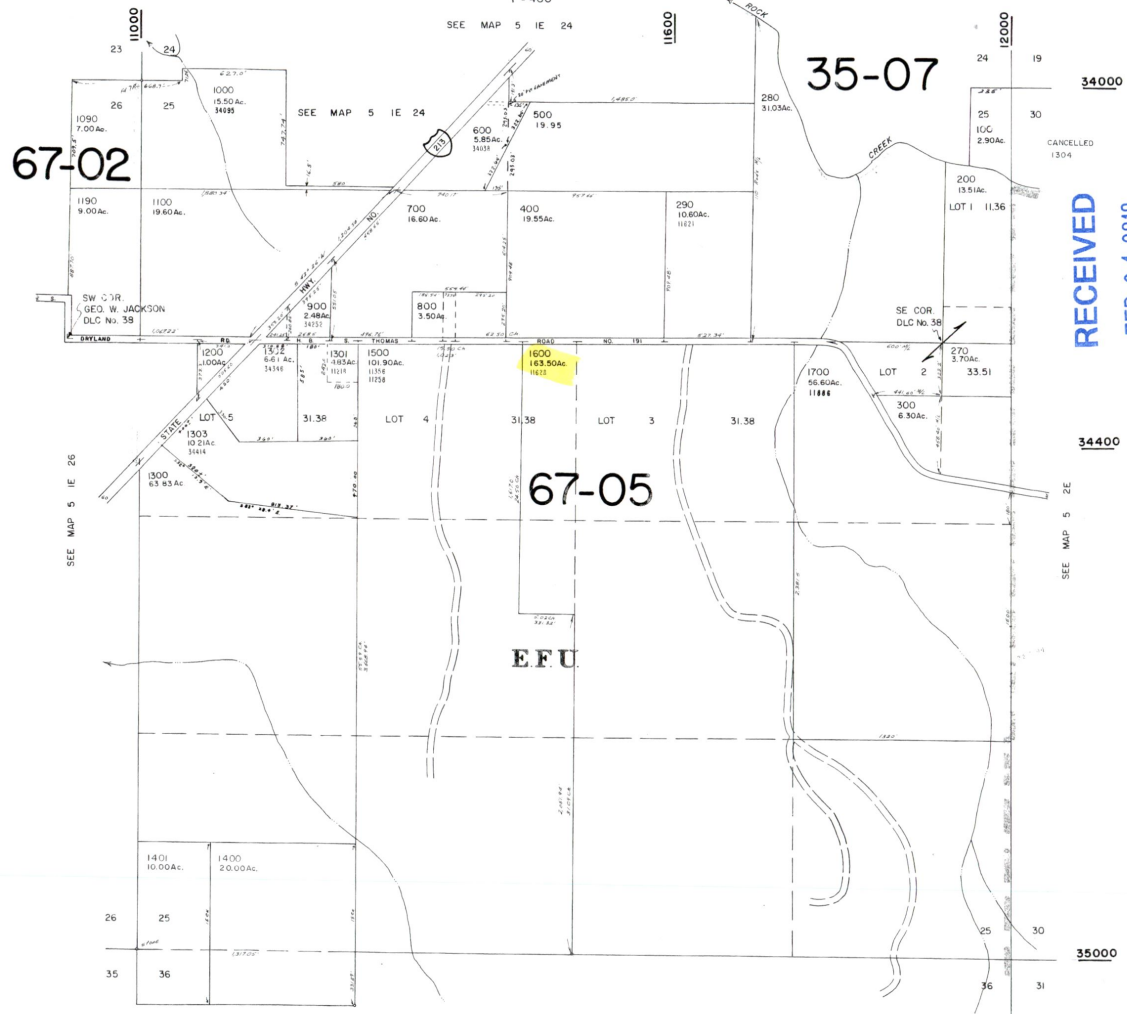

RECEIVED
FEB 04 2019
OWRD

G-18787

BOOK 39
5 IE 25




5 1 E 36

SECTION 36 T.5S. R.1E. W.M.
CLACKAMAS COUNTY
1" = 400'

Cancelled Taxlots
431 714 446
20081

RECEIVED
FEB 04 2019
OWNRD

- Parcel Boundary
- Private Road Right
- Historical Boundary
- Railroad Centerline
- Tax Code Lines
- Map Index
- Water Lines
- Land Use Zoning
- Plats
- Water
- Corner
- Section Corner
- 1/16th Line
- Govt Lot Line
- DLC Line
- Meander Line
- PLSS Section Line
- Historic Corridor 40'
- Historic Corridor 20'

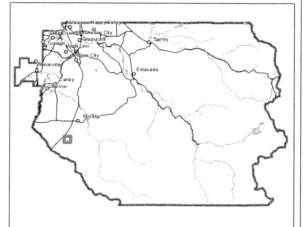


THIS MAP IS FOR ASSESSMENT
PURPOSES ONLY

5 1 E 36

7-18782

6-18782

Figure 1: Map of Division 33 Areas

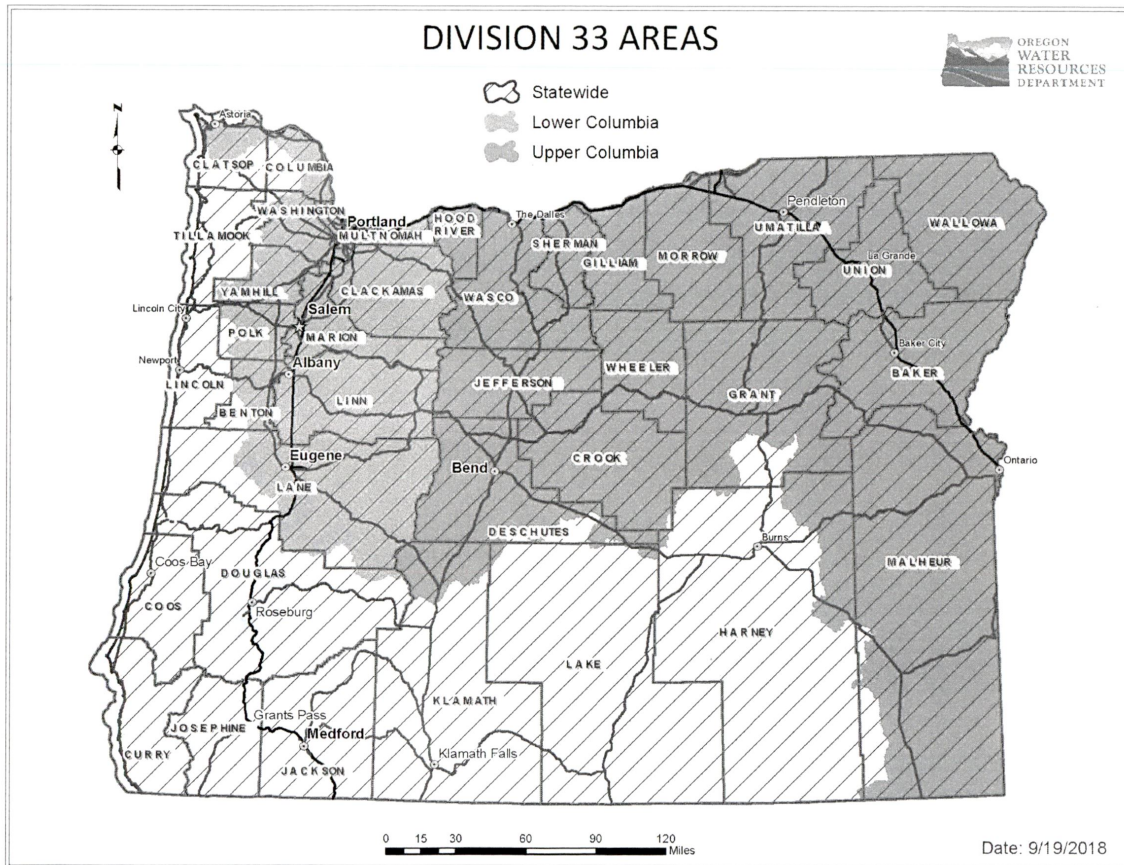

RECEIVED
FEB 04 2019
OWRD

For more detailed information, click on the following link and enter the TRSQQ or the Lat/Long of a POA and click on "Submit" to retrieve a report that will show which section, if any, of the Division 33 rules apply: https://apps.wrd.state.or.us/apps/misc/lkp_trsqq_features/