


Township 16 S., Range 5 W., Section 18, TL 500

Nina & Steve Wiersma

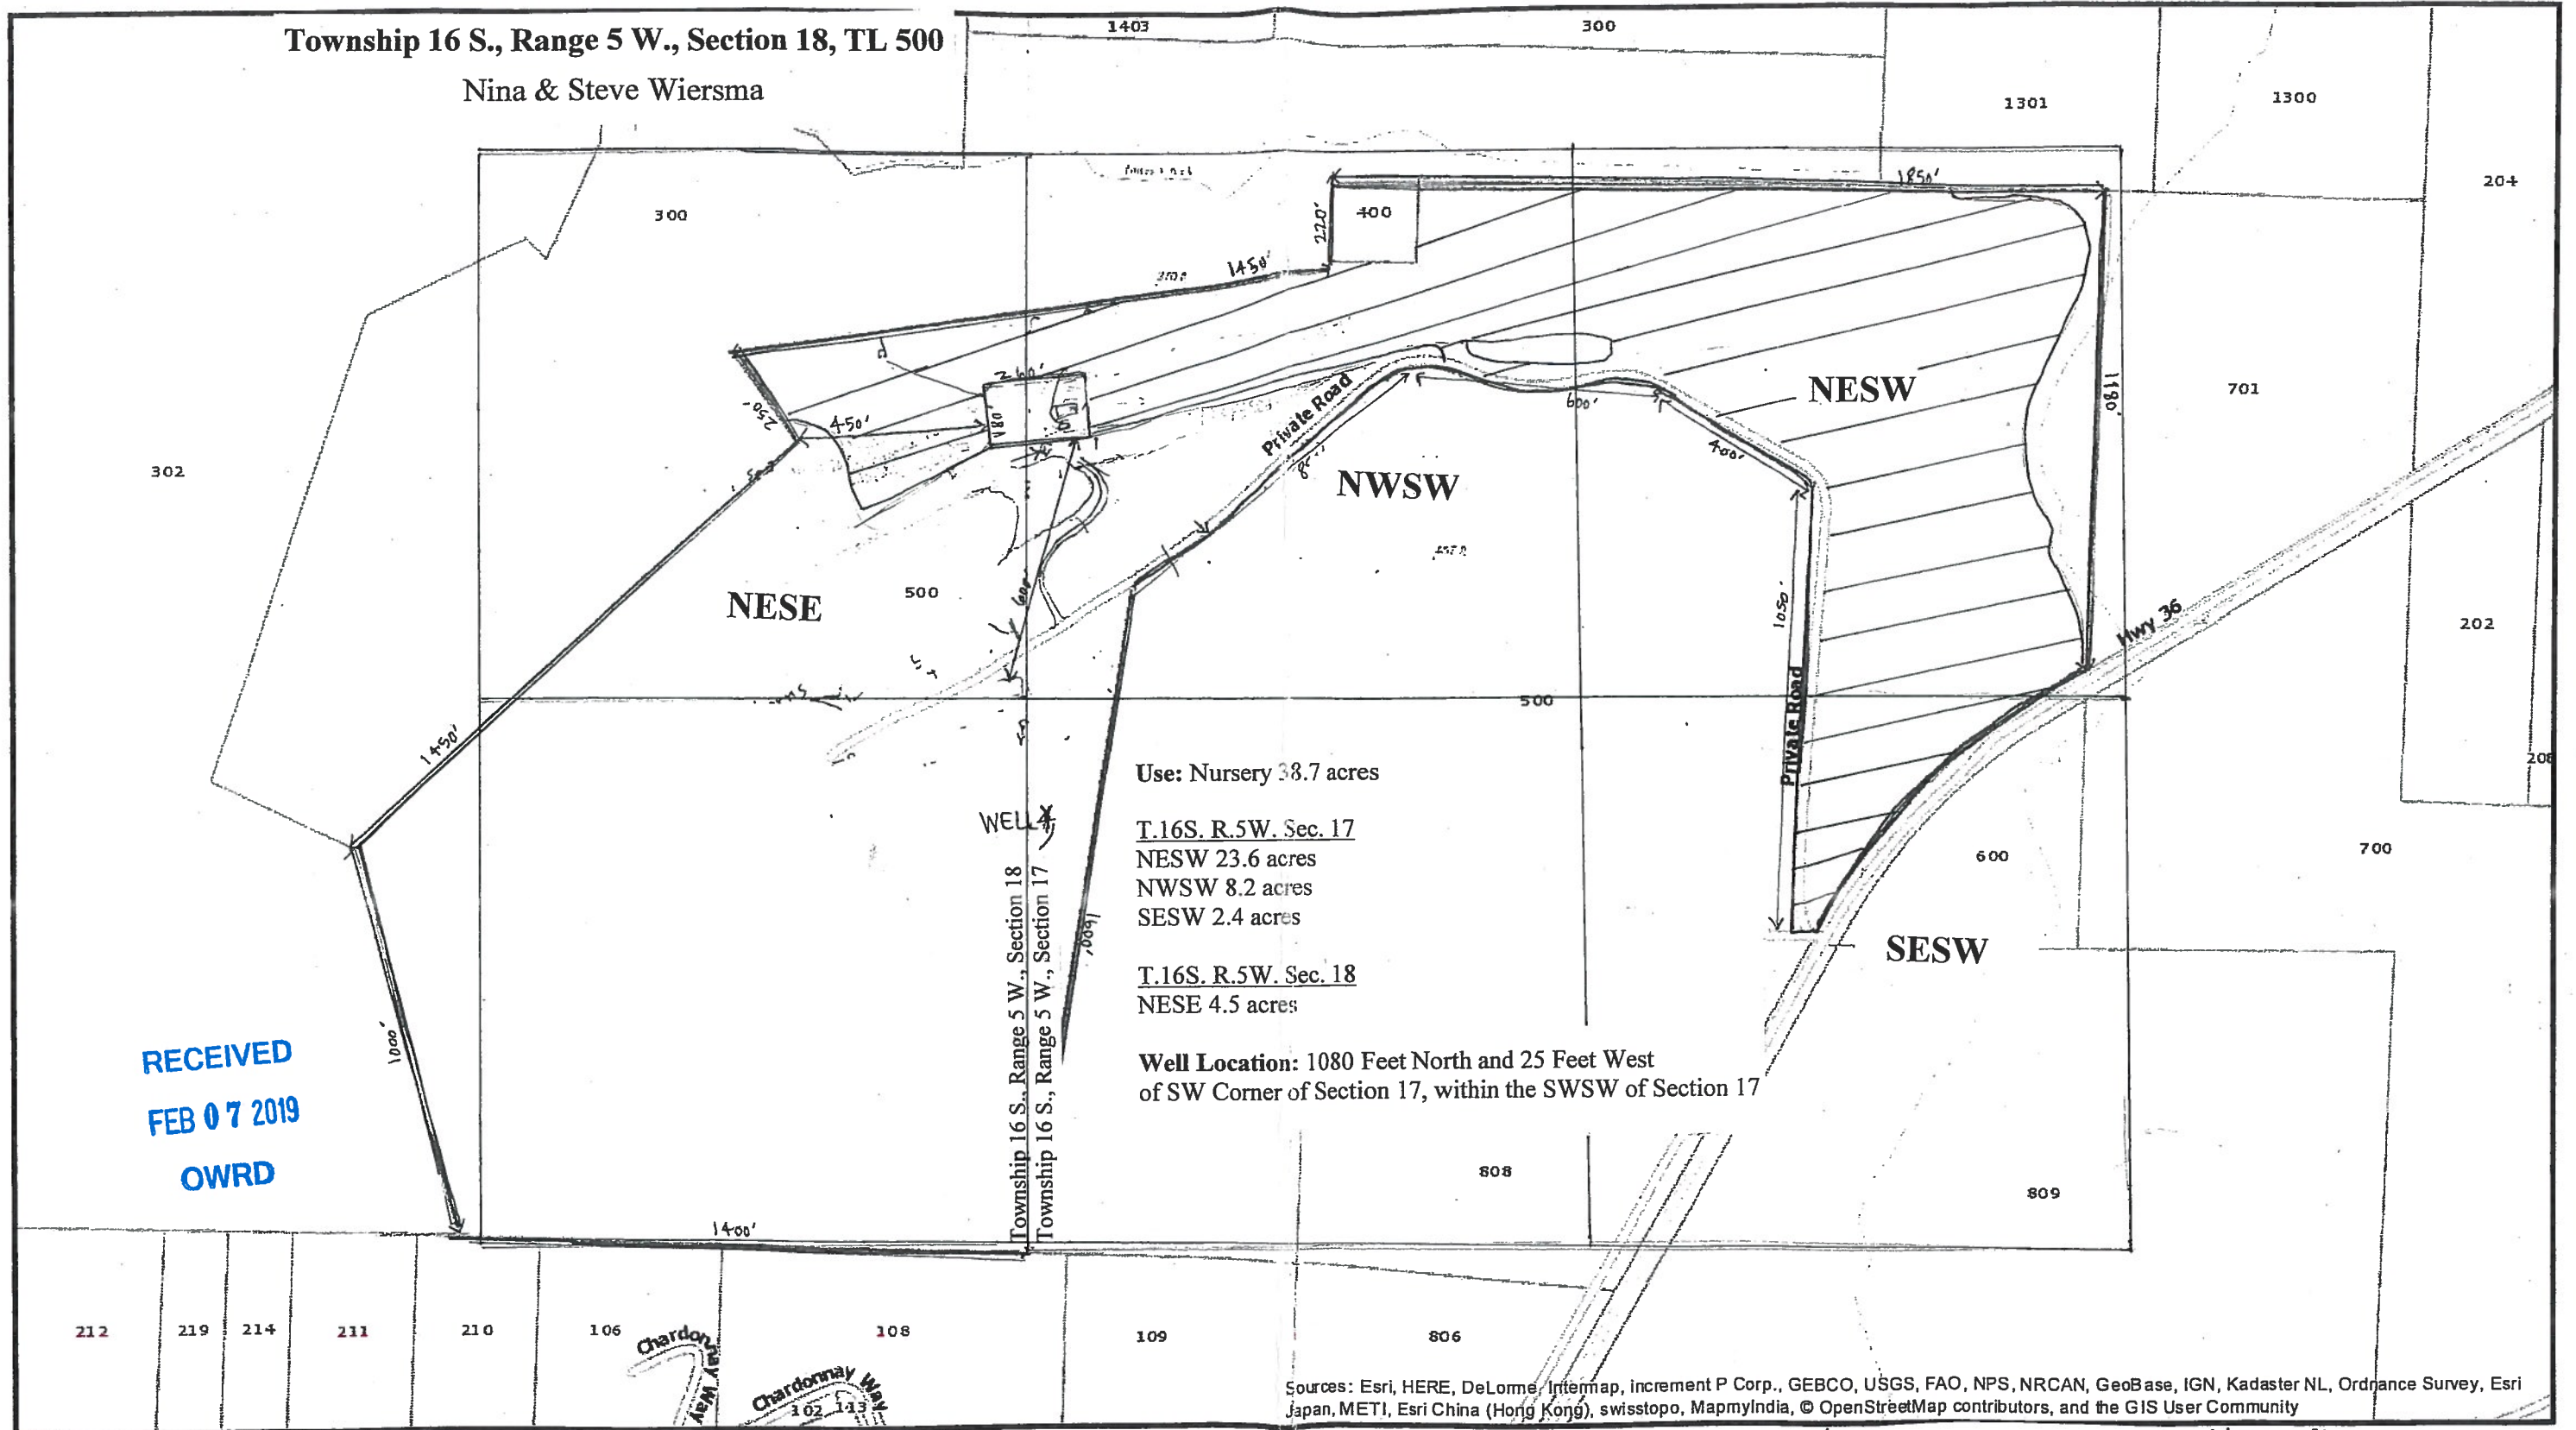

Use: Nursery 38.7 acres

T.16S. R.5W. Sec. 17

NESW 23.6 acres

NWSW 8.2 acres

SESW 2.4 acres


T.16S. R.5W. Sec. 18

NESE 4.5 acres

Well Location: 1080 Feet North and 25 Feet West
of SW Corner of Section 17, within the SWSW of Section 17

Sources: Esri, HERE, DeLorme, Intermap, increment P Corp., GEBCO, USGS, FAO, NPS, NRCAN, GeoBase, IGN, Kadaster NL, Ordnance Survey, Esri Japan, METI, Esri China (Hong Kong), swisstopo, MapmyIndia, © OpenStreetMap contributors, and the GIS User Community

The information on this map was derived from digital databases on the Lane County regional geographic information system. Care was taken in the creation of this map, but is provided "as is". Lane County cannot accept any responsibility for errors, omissions or positional accuracy in the digital data or the underlying records. Current plan designation, zoning, etc., for specific parcels should be confirmed with the appropriate agency. There are no warranties, expressed or implied, accompanying this product. However, notification of any errors will be appreciated.

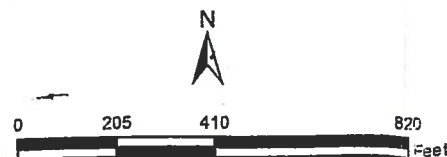

Lane County, Oregon

Nina Wiersma
25961 Hwy 36
Cheshire OR 97419
541-554-9921
Township 16 Range 05
Section 18 Taxlot 00500