

RECEIVED

RECEIVED BY OWRD

RECEIVED BY OWR

Wayne and Amanda Staehely
1" = 1320'

FEB 08 2019

Tax Lot:


OWRD

SALEM, OR



Township 4 South, Range 1 East, Section 34, Tax Lot 1100, 1101

SALEM, OR

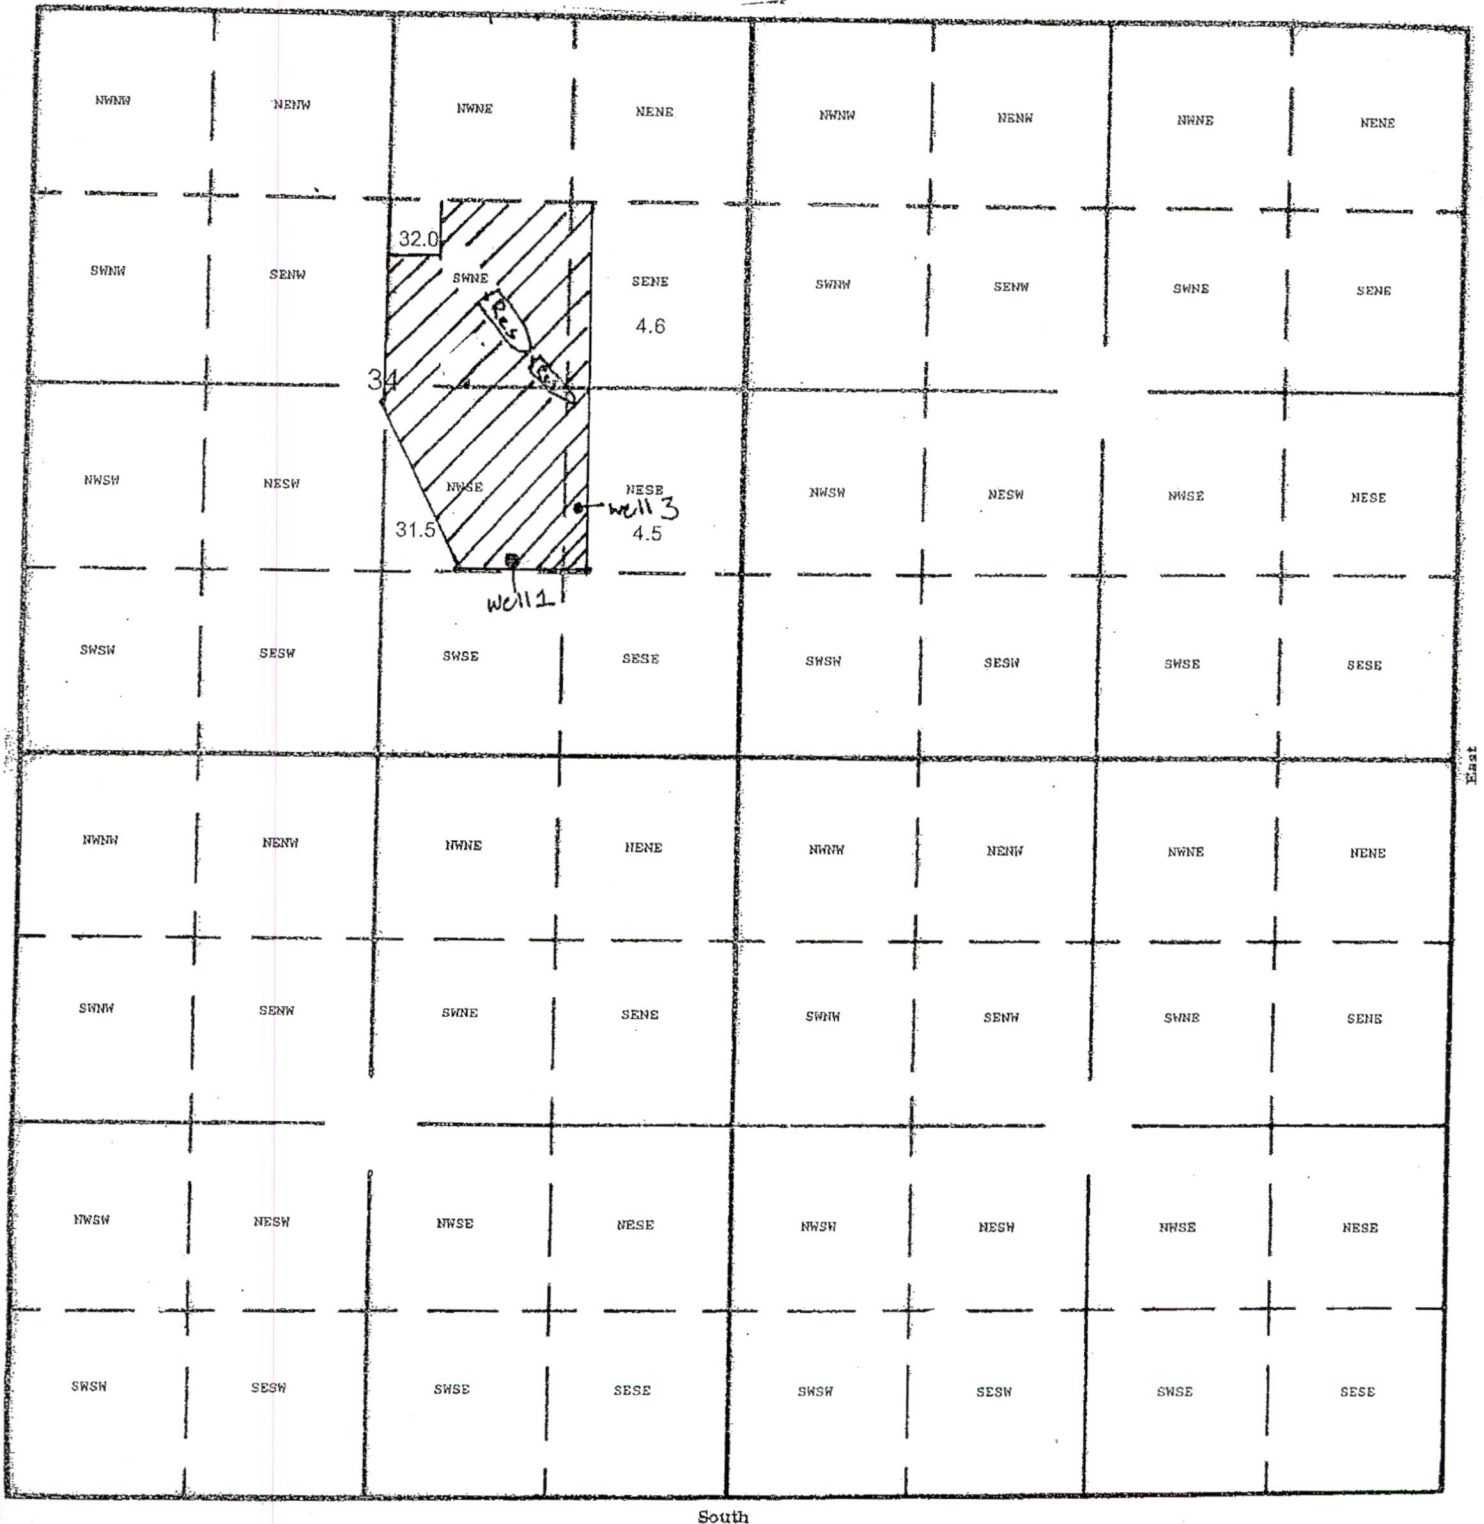

Well #1: (CLAC 12773) 3950 Feet South and 1665 Feet West from the NE Corner Section 34 Lat 45.17617 Long -12266757

Well #3 Proposed Well: 3545 Feet South and 1200 Feet West from the NE Corner Section 34

A-18789

Amanda Staehely
1/31/19

Amanda Staehely
7-6-16