


NE SE, Section 22
NW SW, Section 23
T.5S. R.2W. W.M.
Marion County, Oregon
1" = 400'

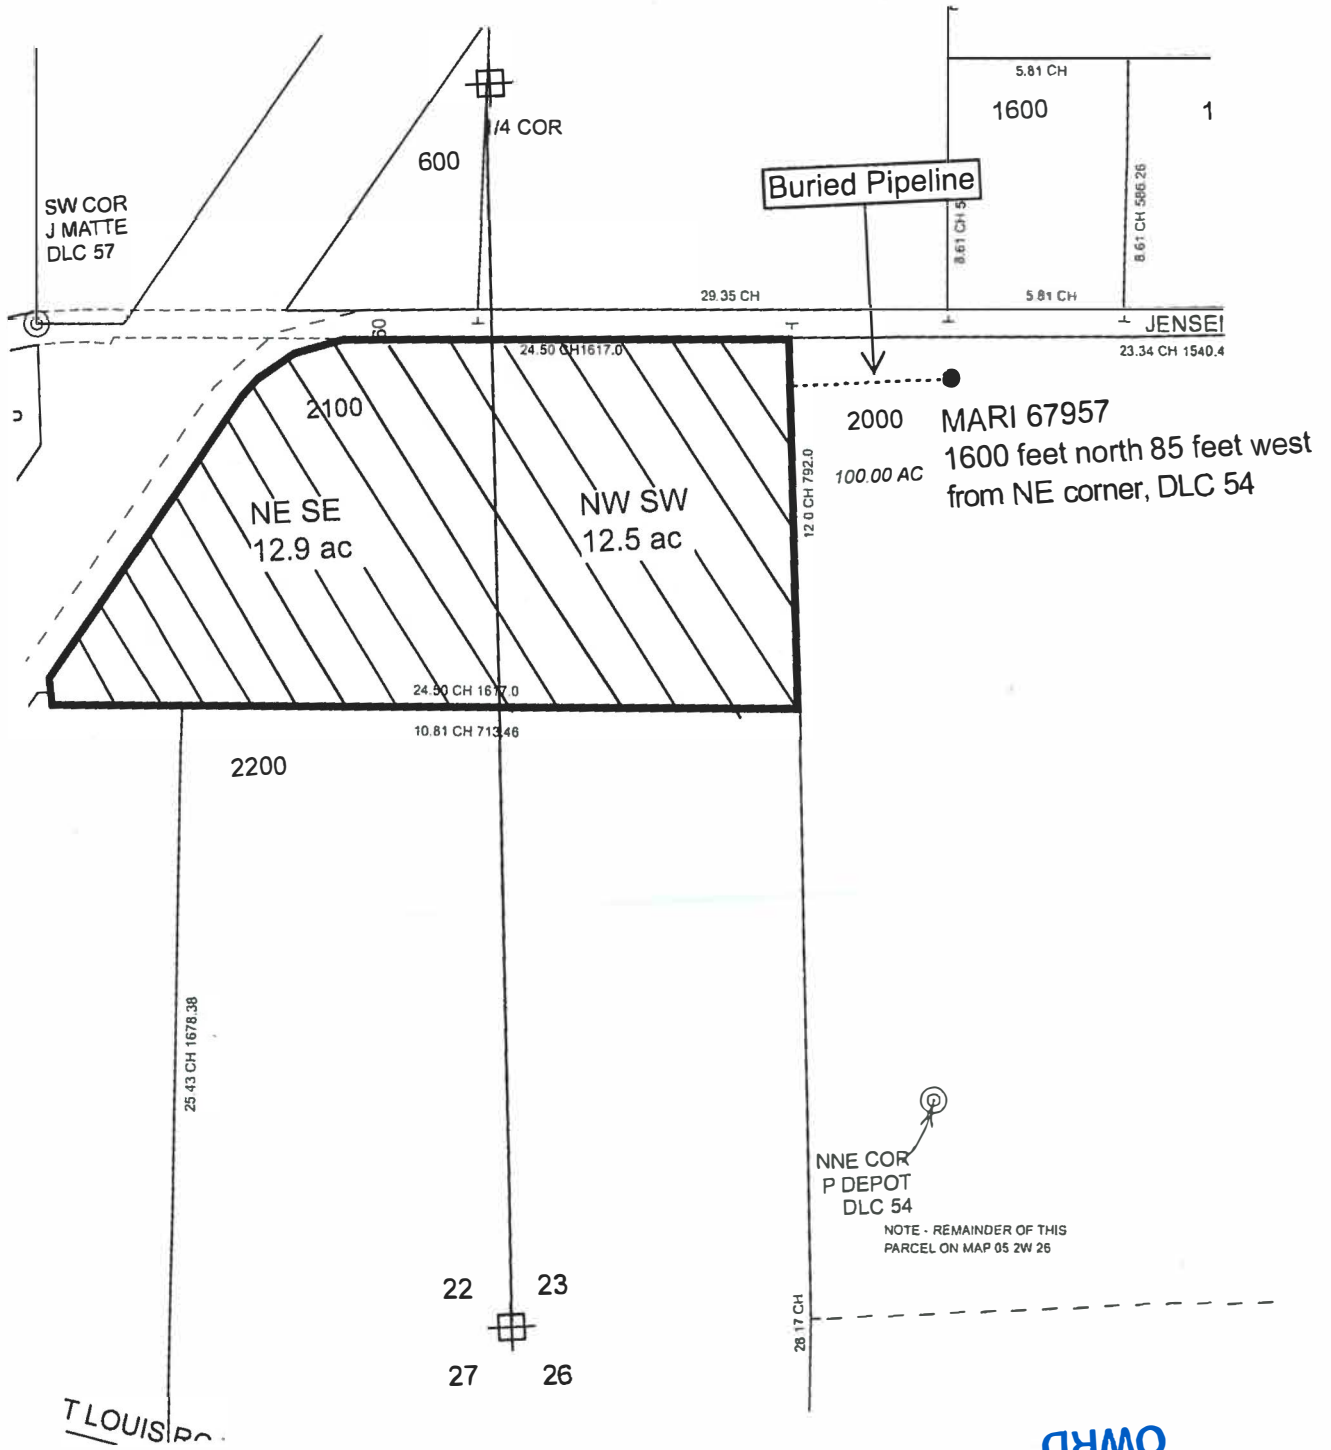

RECEIVED
AUG 28 2019
OWRD