

MAR 14 2019


SECTION

1" = 1320'
TAX lots
200, 100
800

TOWNSHIP T7S, RANGE R1W OWRD W. M.

↑ North

North

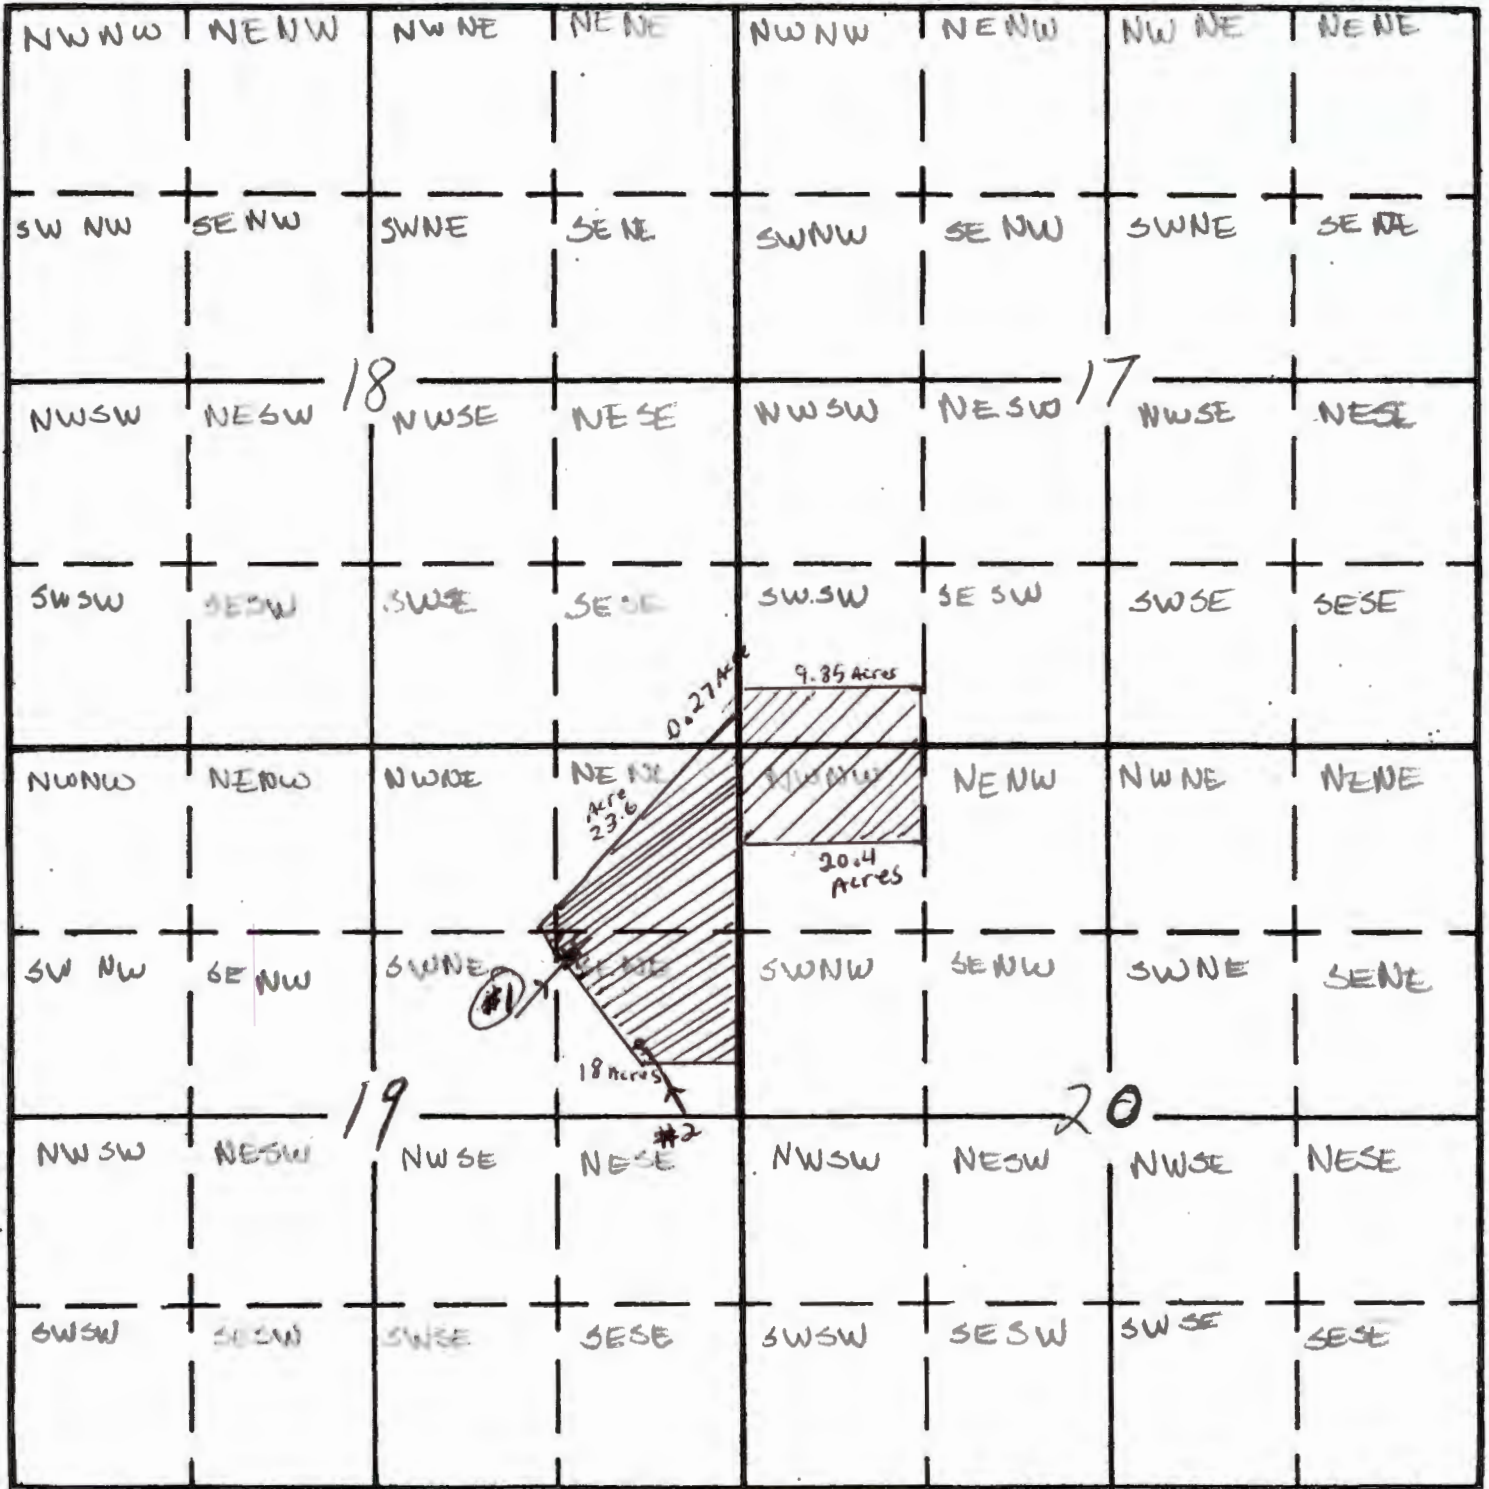

Well #1 From the South 150' south of center of the NE corner of S 19

Well #2 581' south + 420ft east from the center of the NE corner of S 19