


T 6 S, R 1 W, W.M.

MARION COUNTY

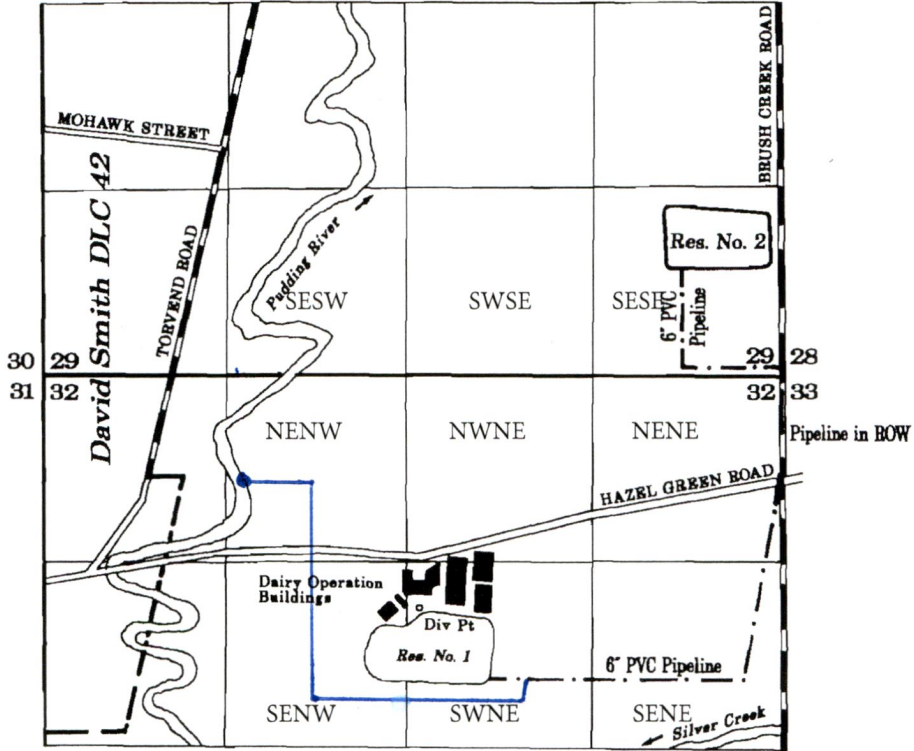

POD 726 feet South and 3750 feet West of the NE Corner Section 32

FINAL PROOF SURVEY
UNDER

Application _____ Permit _____

RECEIVED

MAR 22 2019

OWRD

IN THE NAME OF

Scale: 1" = 1320'


[Handwritten signature]



NOTE: This map is for the purpose of identifying the location of water rights and has no intent to locate or dimension property ownership lines.

R-88765

06 1W 32

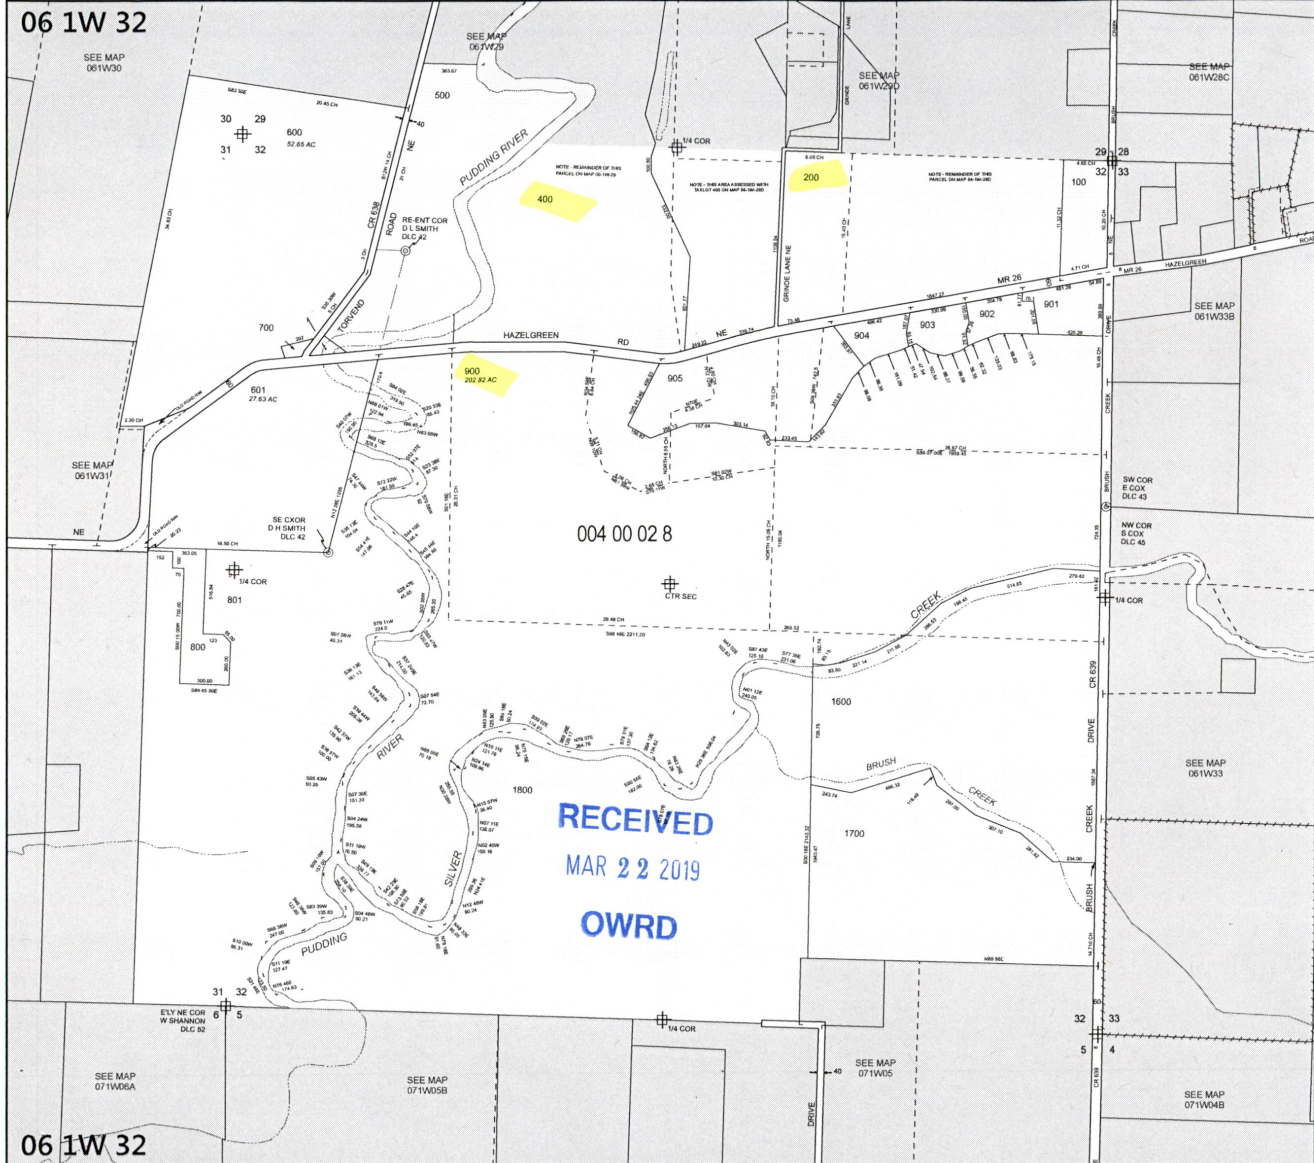

06 1W 32



MARION COUNTY, OREGON
 SEC. 32 T6S R1W W.M.
 SCALE 1" = 400'

LEGEND

- LINE TYPES**
- Taxlot Boundary
 - Road Right-of-Way
 - Railroad Right-of-Way
 - Private Road RCW
 - Subdivision/Plat Bndry
 - Waterline - Taxlot Bndry
 - Historical Boundary
 - Easement
 - Railroad Centerline
 - Taxcode Line
 - Map Boundary
 - Waterline - Non Bndry

- CORNER TYPES**
- + 1/16TH Section Cor.
 - ⊕ D/LC Corner
 - ⊕ 1/4 Section Cor.
 - ⊕ 15
 - ⊕ Section Corner
 - 21 22

NUMBERS
 Tax Code Number
000 00 00 0
 Acreage 0.25 AC All acres listed are Net Acres, excluding any portions of the taxlot within public ROWs

NOTES
 Tick Marks: A tick mark in the road indicates that the labeled dimension extends into the public ROW

CANCELLED NUMBERS	
800	
1000	
1100	
1100A1	
1200	
1300	
1400	
1500	

DISCLAIMER: THIS MAP WAS PREPARED FOR ASSESSMENT PURPOSES ONLY




FOR ADDITIONAL MAPS VISIT OUR WEBSITE AT www.co.marion.or.us

PLOT DATE: 1/23/2018

06 1W 32

RECEIVED
MAR 22 2019
OWRD

R-88765

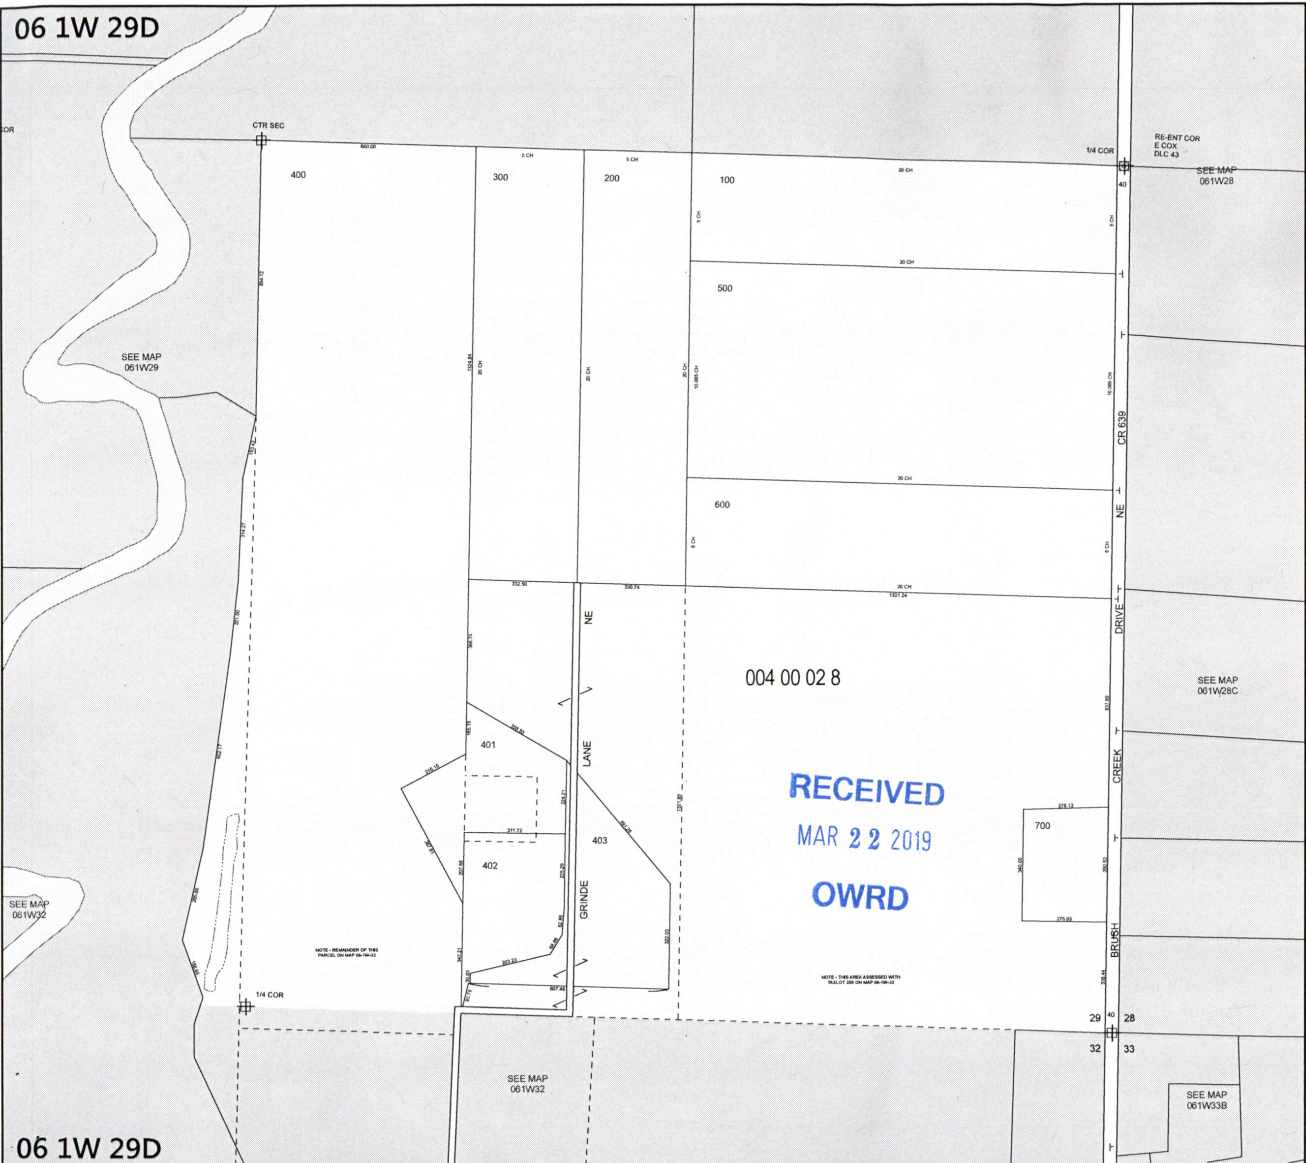

06 1W 29D

MARION COUNTY, OREGON
SE1/4 SEC29 T6S R1W W.M.
SCALE 1" = 200'

LEGEND

LINE TYPES

Taxlot Boundary	Historical Boundary
Road Right-of-Way	Easement
Railroad Right-of-Way	Railroad Center-Line
Private Road RCW	Taxcode Line
Subdivision/Plat Bndry	Map Boundary
Waterline - Taxlot Bndry	Waterline - Non Bndry

CORNER TYPES

+ 1/16TH Section Cor.	⊕ 1/4 Section Cor.
⊙ DLC Corner	⊕ 16, 15 Section Corner
	⊕ 21, 22

NUMBERS
Tax Code Number
000 00 00 0

Acreage All acres listed are Net Acres, excluding any portions of the taxlot within public ROWs
@ 25 AC

NOTES
Tick Marks: A tick mark in the road indicates that the labeled dimension extends into the public ROW

CANCELLED NUMBERS

404			
800			
900			
1000			


DISCLAIMER: THIS MAP WAS PREPARED FOR ASSESSMENT PURPOSES ONLY

FOR ADDITIONAL MAPS VISIT OUR WEBSITE AT www.co.marion.or.us



PLOT DATE: 1/23/2018

06 1W 29D


D-2015

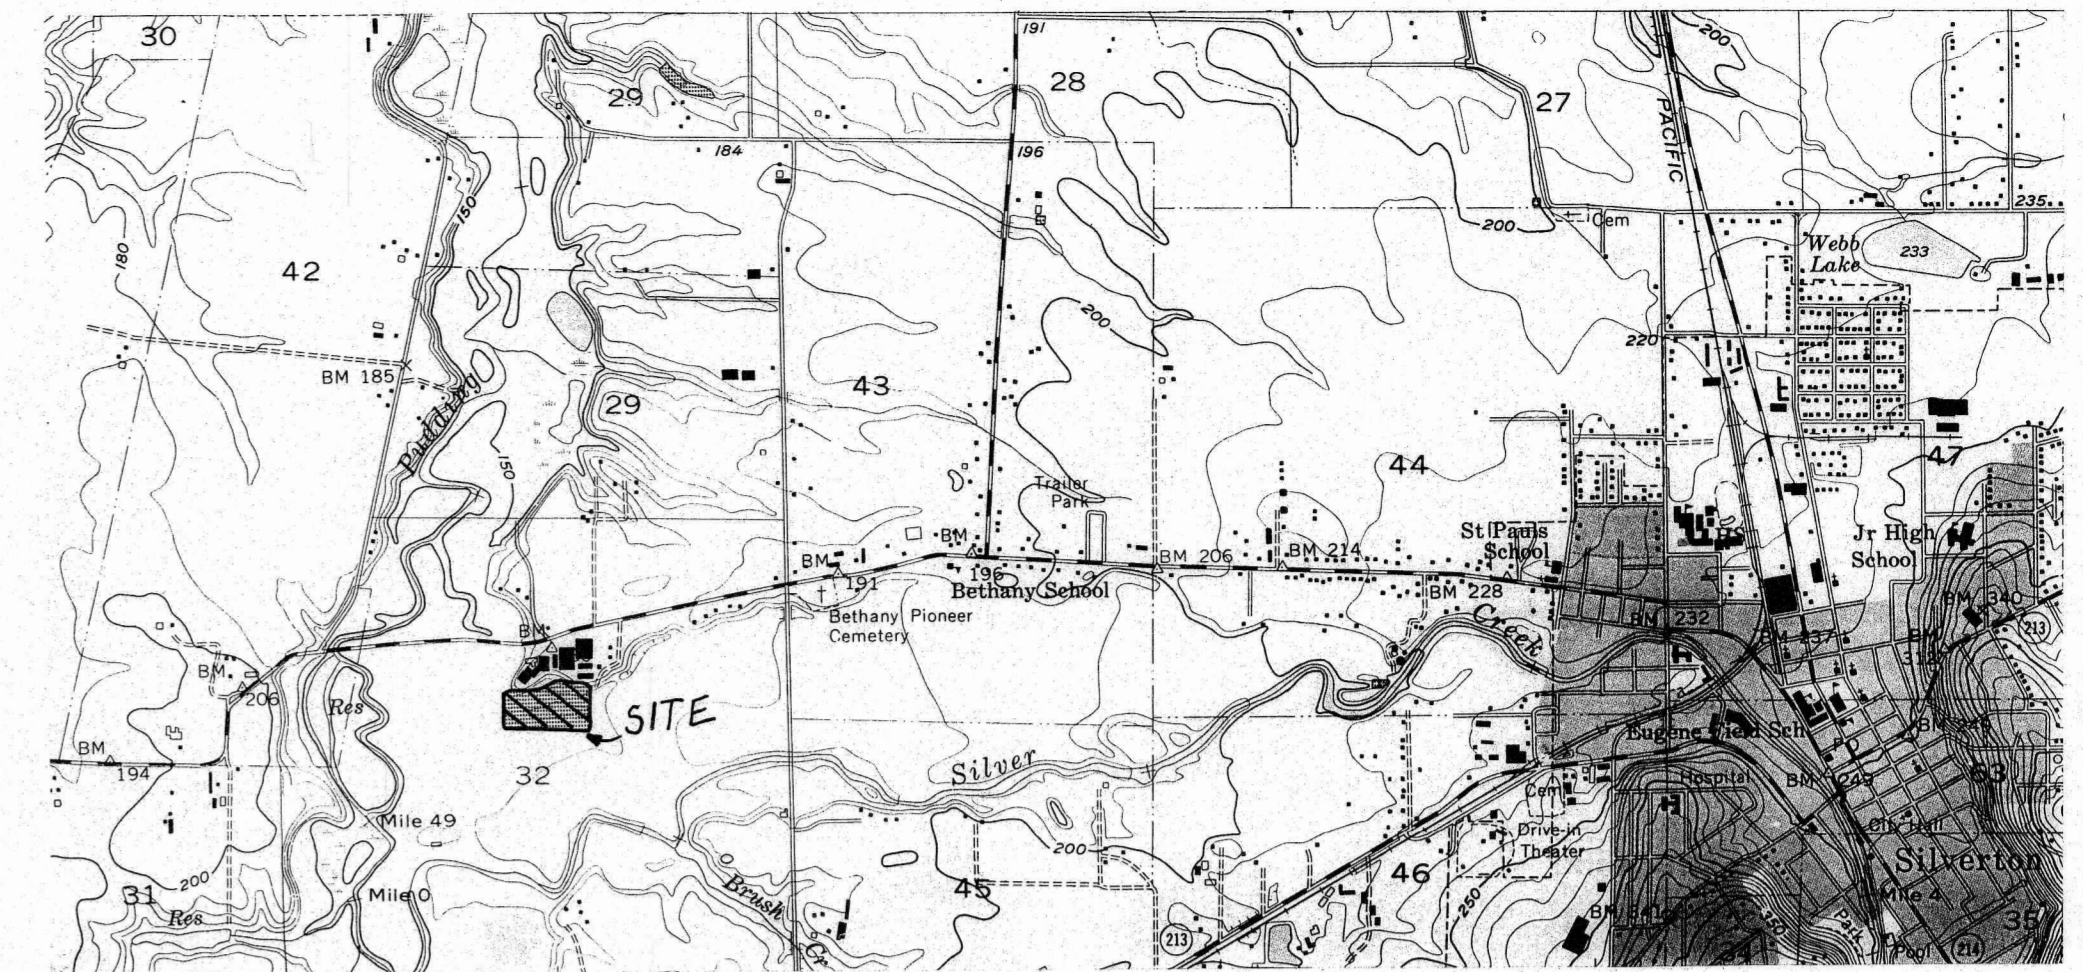

VICINITY MAP
SCALE 1"=2000'

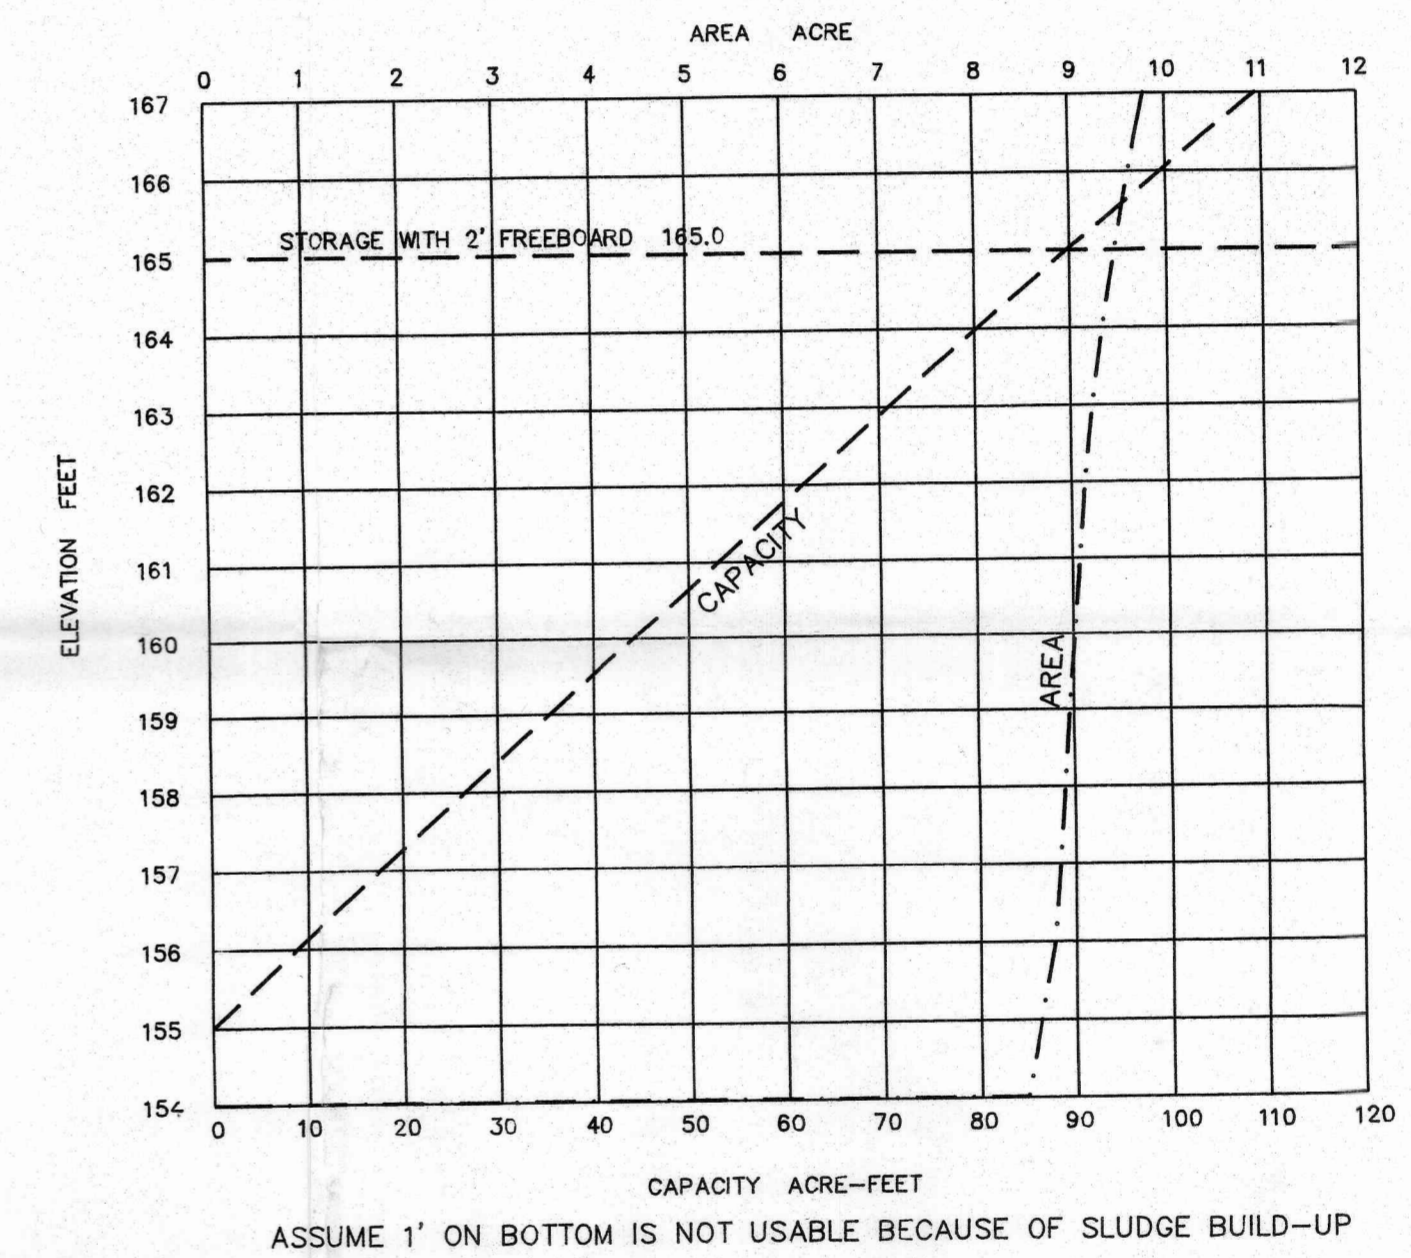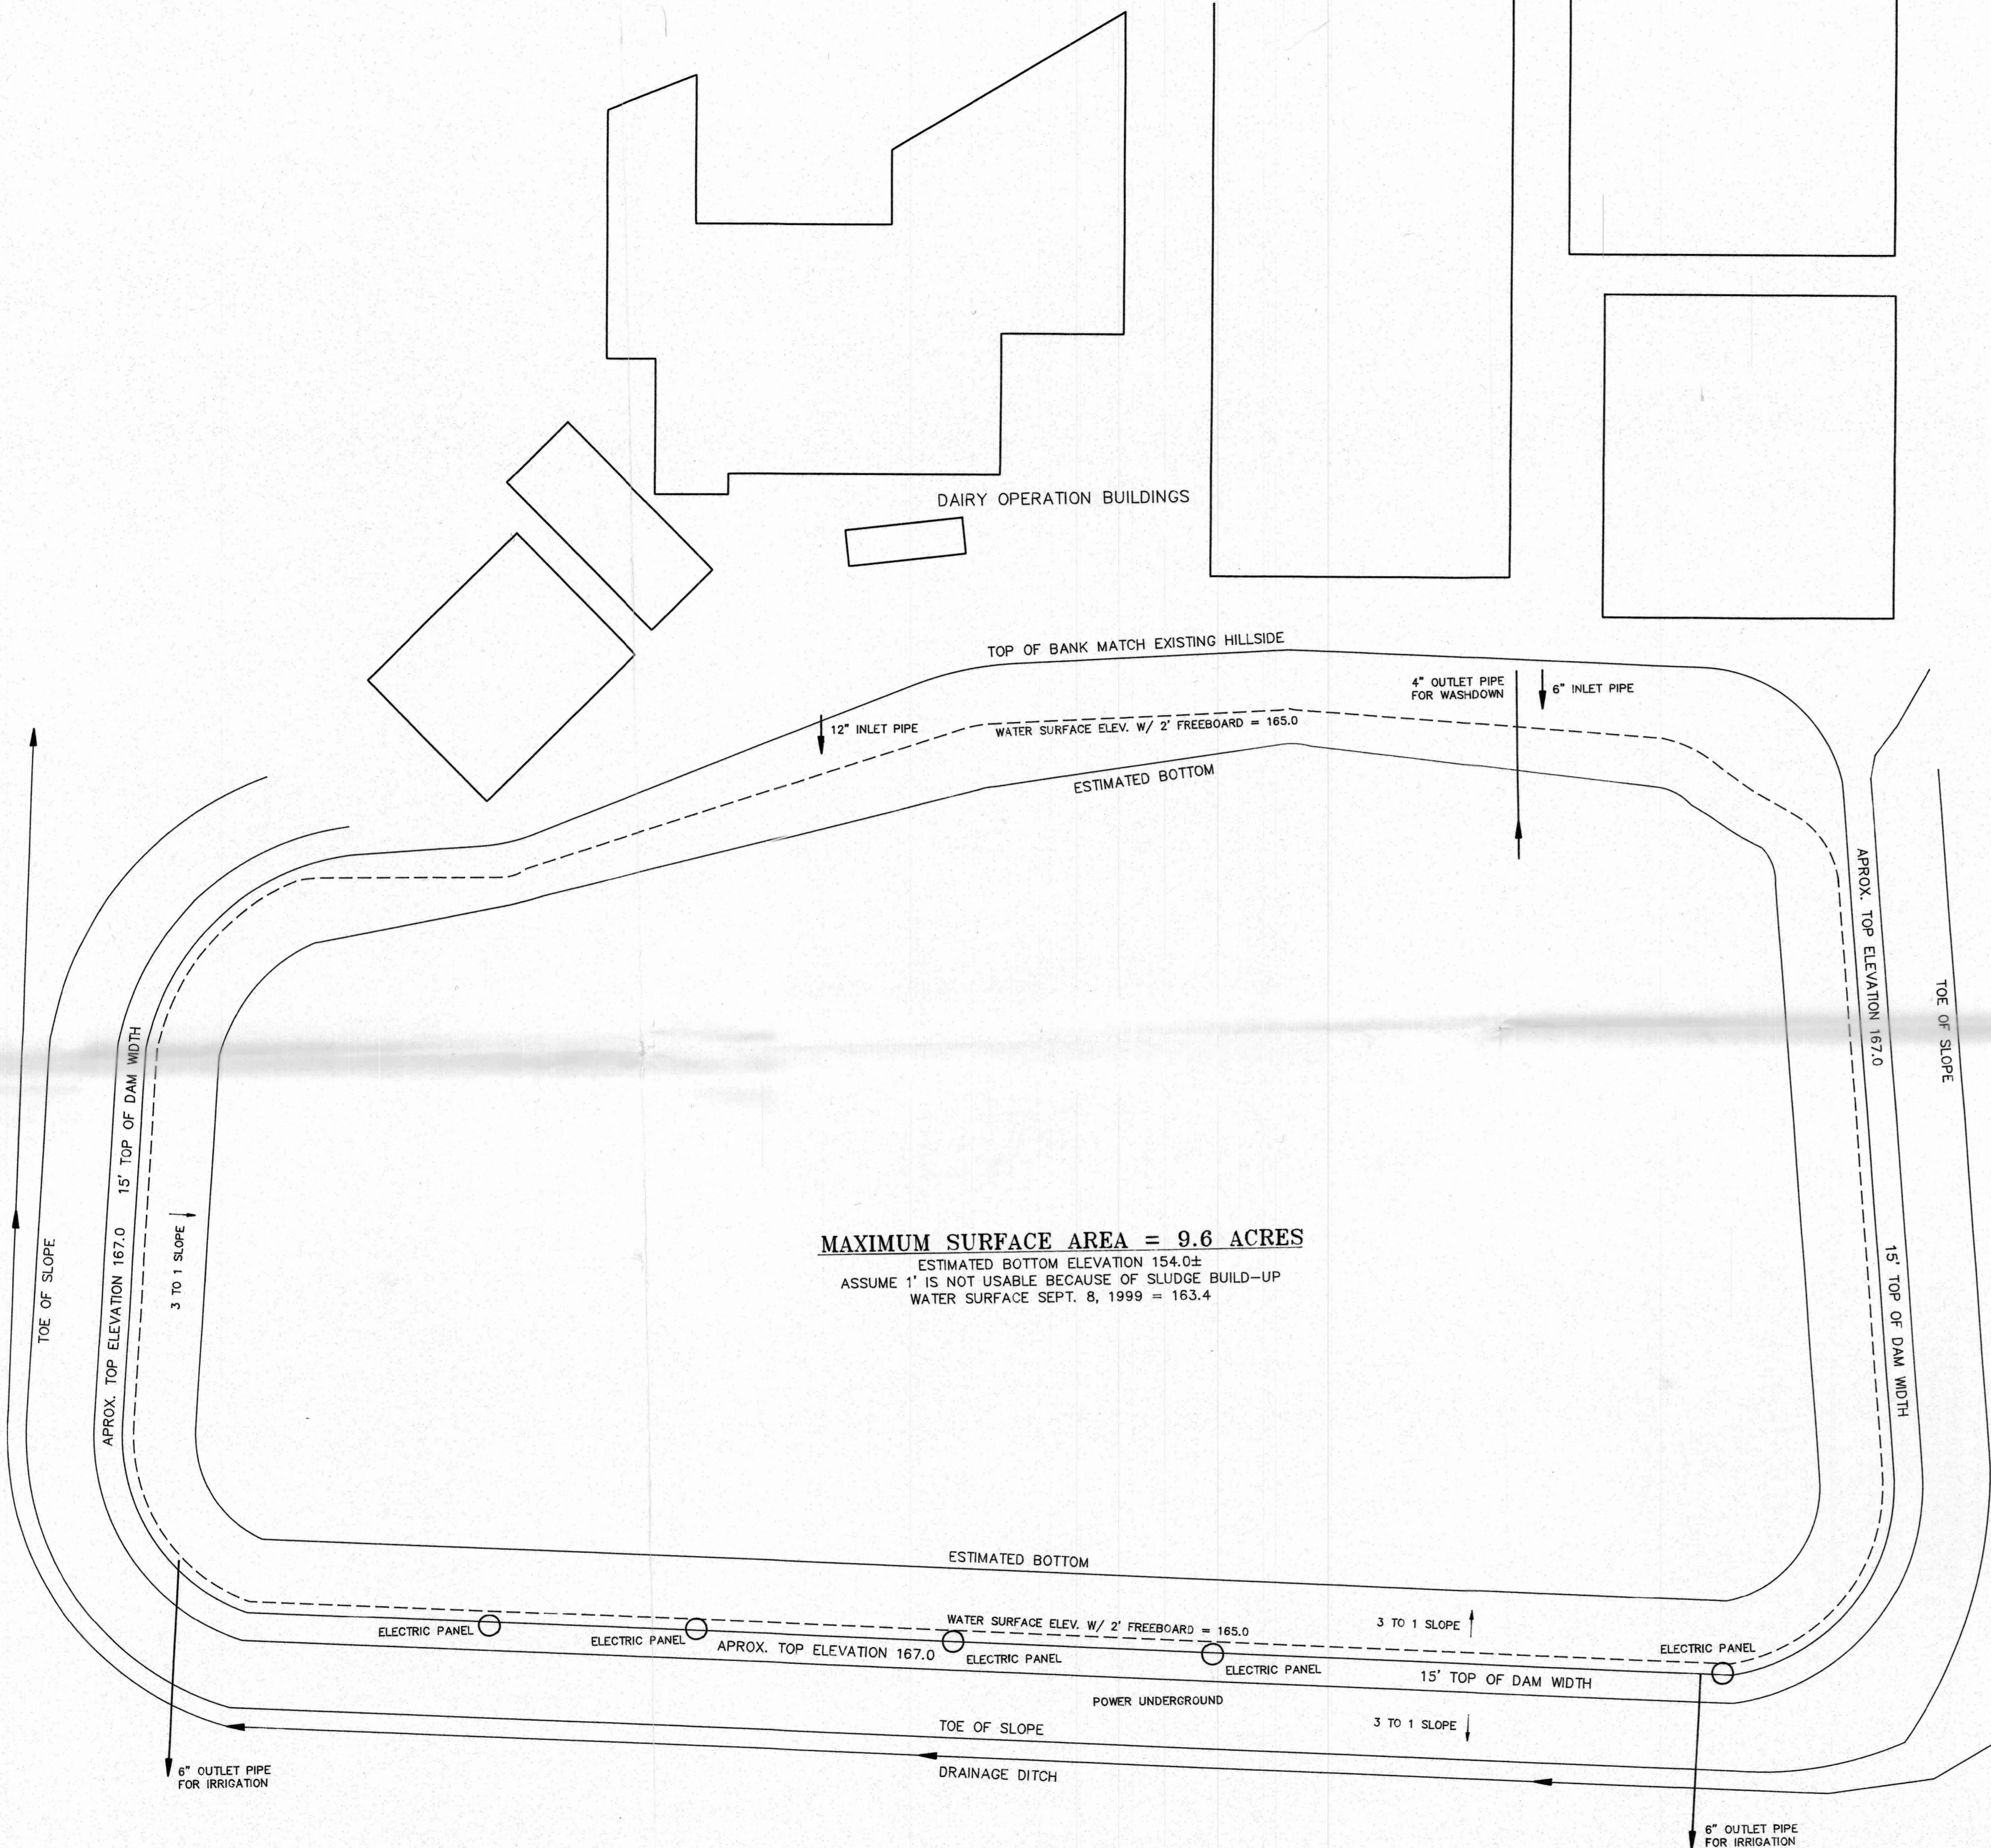

AREA-CAPACITY CURVE

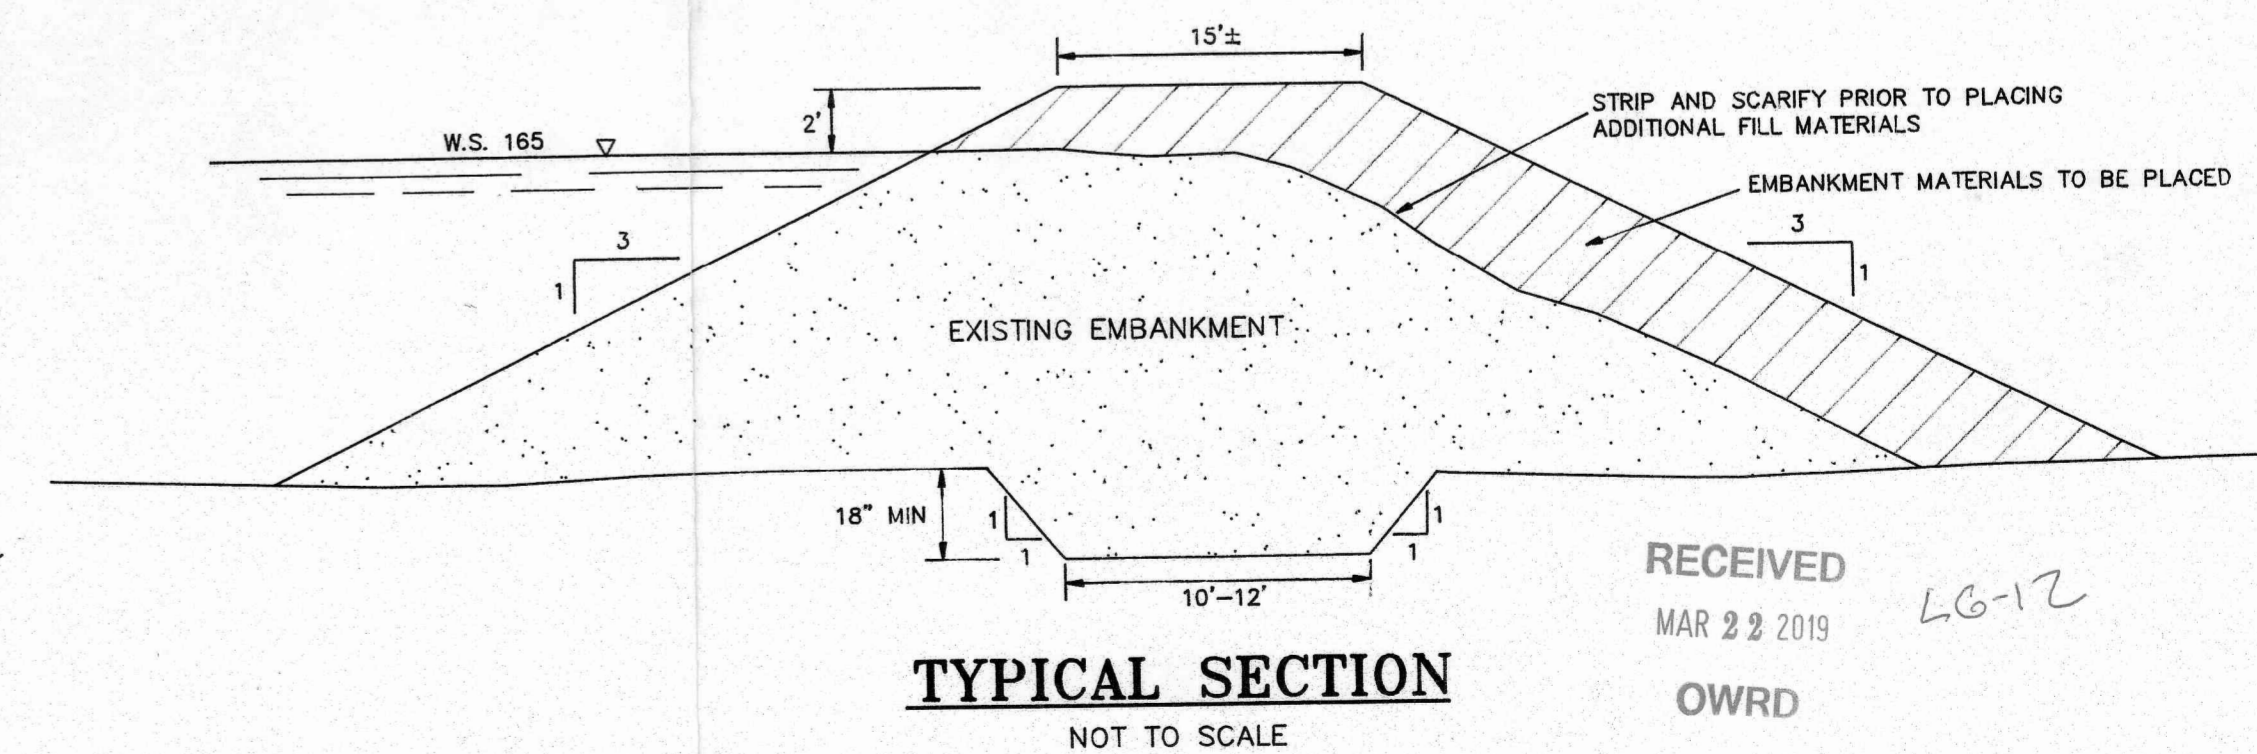

TYPICAL SECTION

RECEIVED
MAR 22 2019
OWRD
LG-12

	DESIGN	ACTUAL
STORAGE WITH 2' FREEBOARD	92.1 Ac-Ft	90.0 Ac-Ft
MAXIMUM STORAGE CAPACITY	110.2 Ac-Ft	109.4 Ac-Ft
SURFACE AREA WITH 2' FREEBOARD	8.9 Ac	9.46 Ac
MAXIMUM SURFACE AREA	9.2 Ac	9.78 Ac

DRAWING OF RECORD
ACS SEPT. 27, 1999

MALLORIE'S DAIRY
SEWAGE IRRIGATION/WASHDOWN
RESERVOIR #1

Scale: Horiz. 1" = 50'
Vert. 1" = 2'

Date: AUG. 2, 1976

Design: MGB
Drawn: ACS
Chkd: MGB


<p>2813 12th Street SE, SALEM, OREGON 97302 TEL: (503) 363-9025 FAX: (503) 363-1651</p>	<p>Job No. _____ Sheet _____</p>
---	--------------------------------------

1 of 1

WATER RIGHTS, MALLORIE.DWG


765
R-88

Mallorie's Dairy, Inc.
Vol. 770, Pg. 804

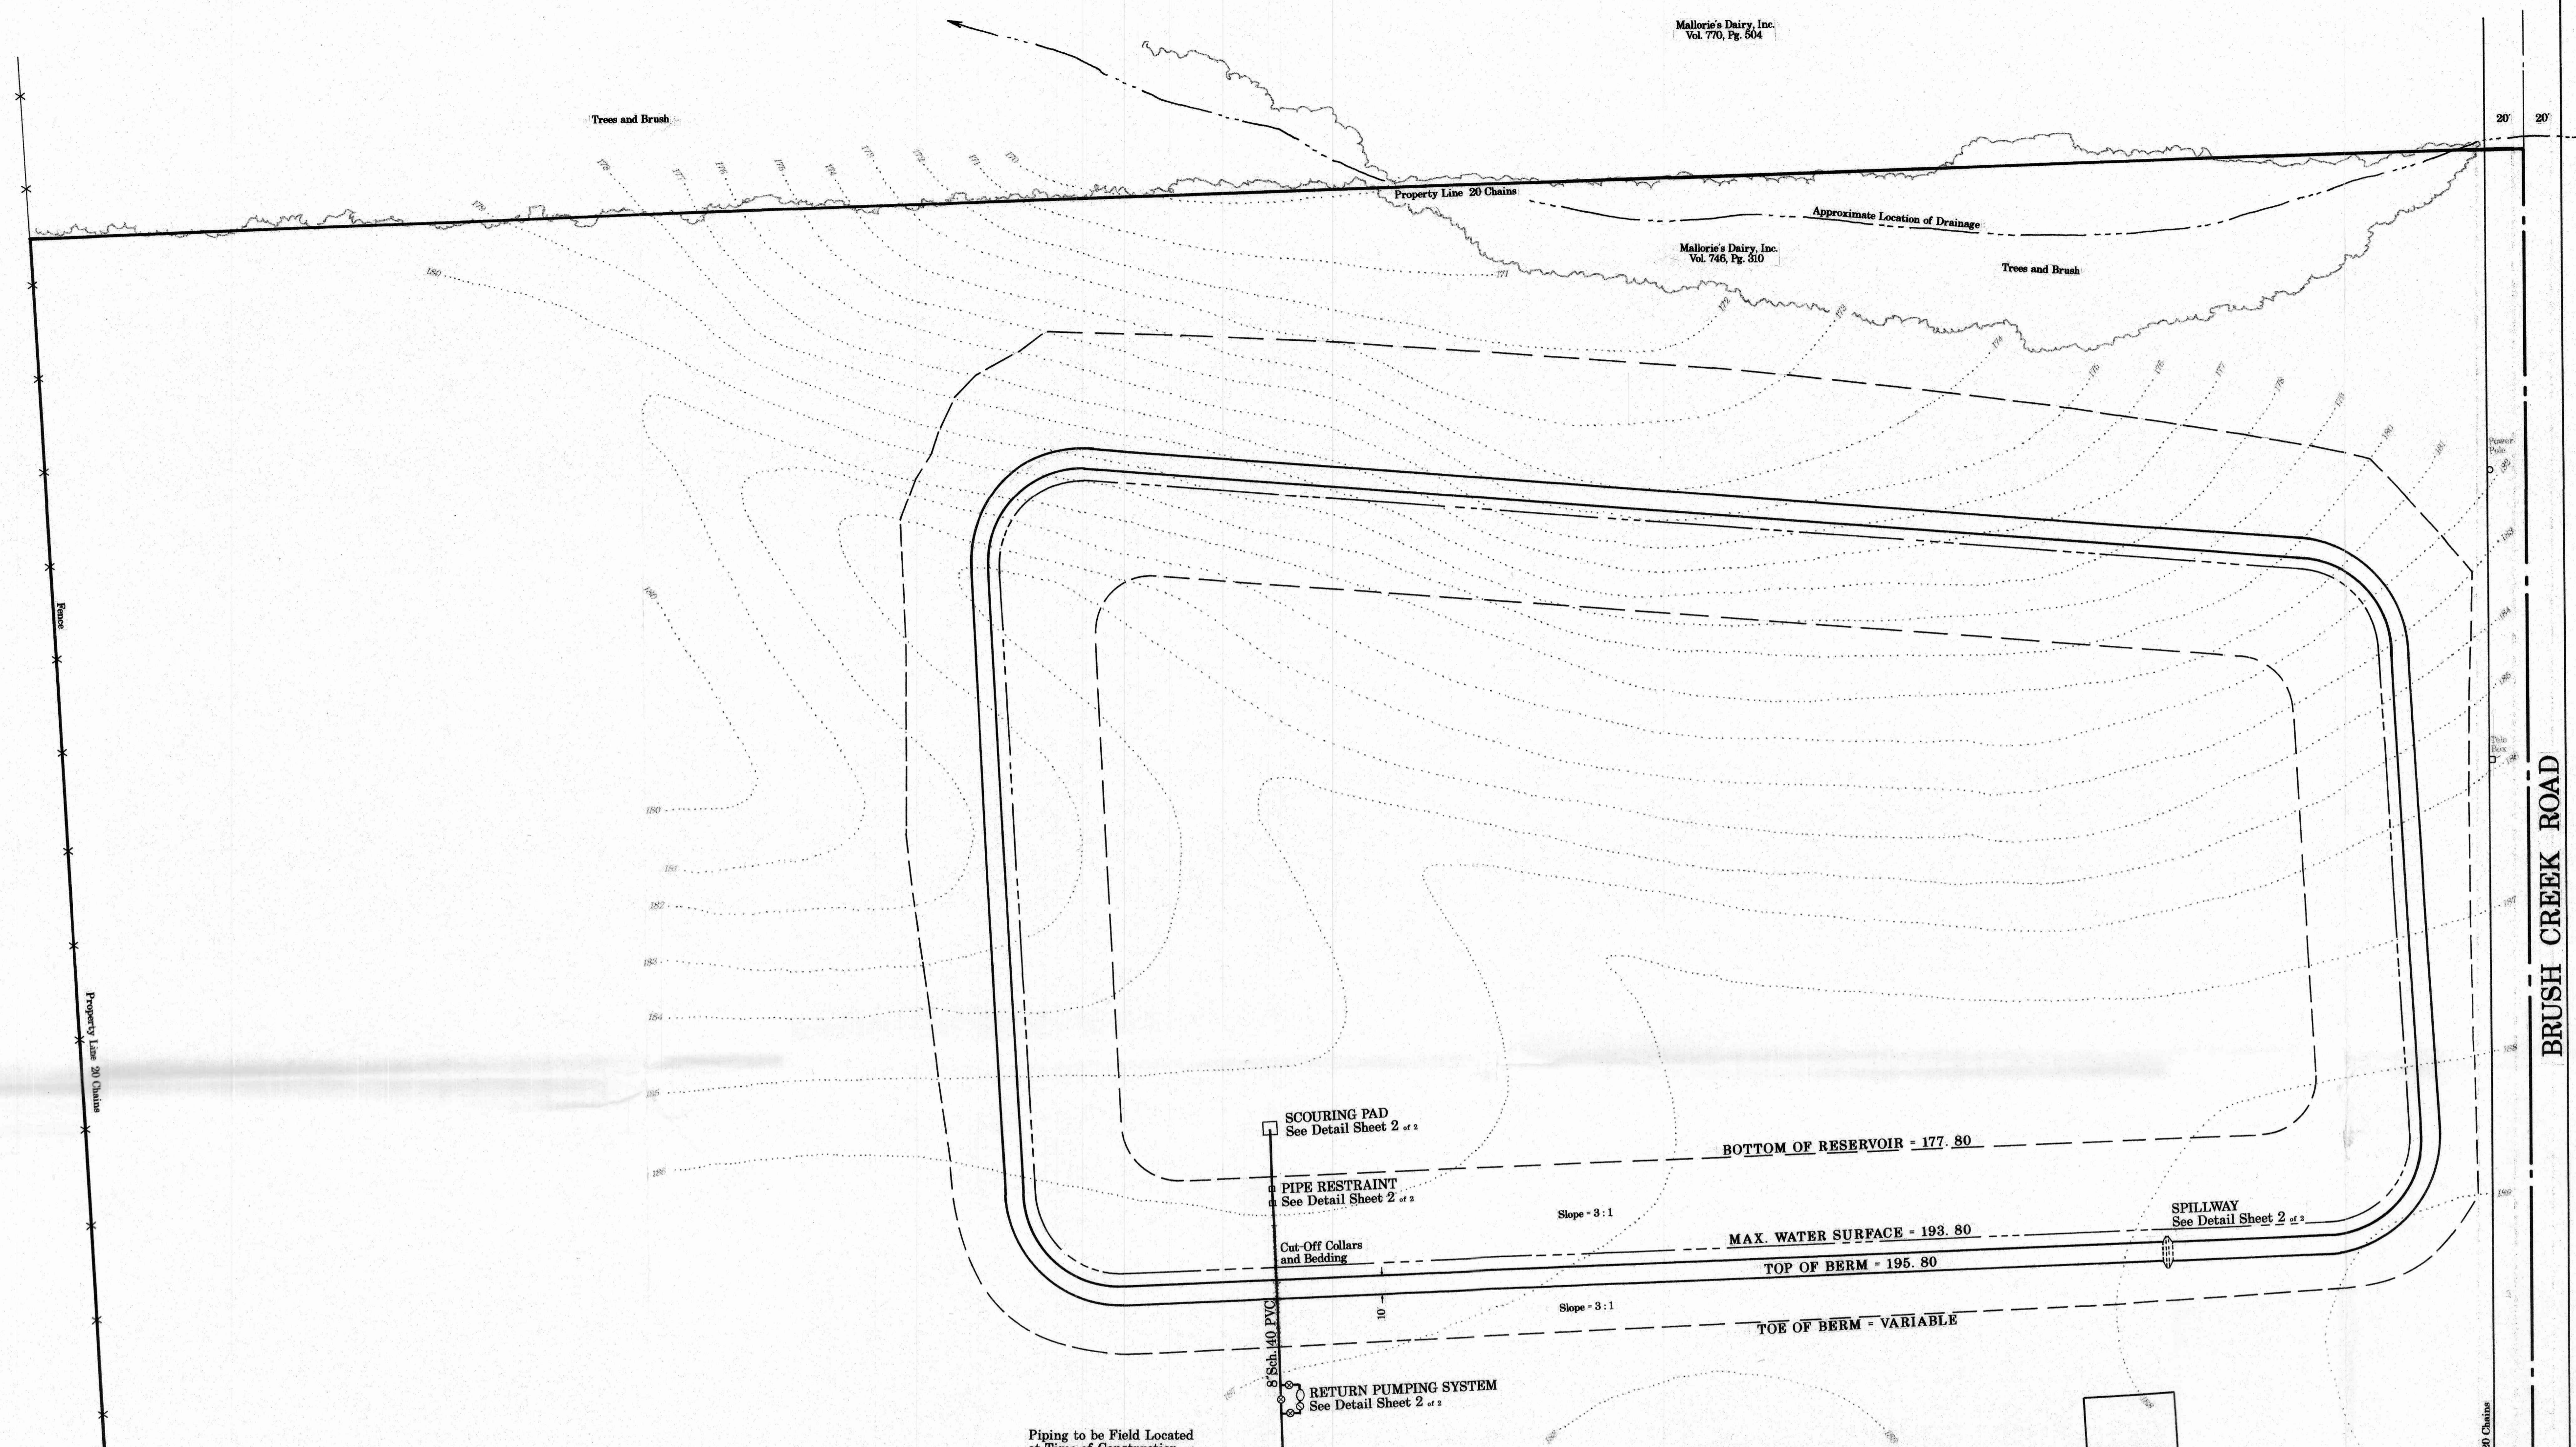


BRUSH CREEK ROAD

PLOT PLAN

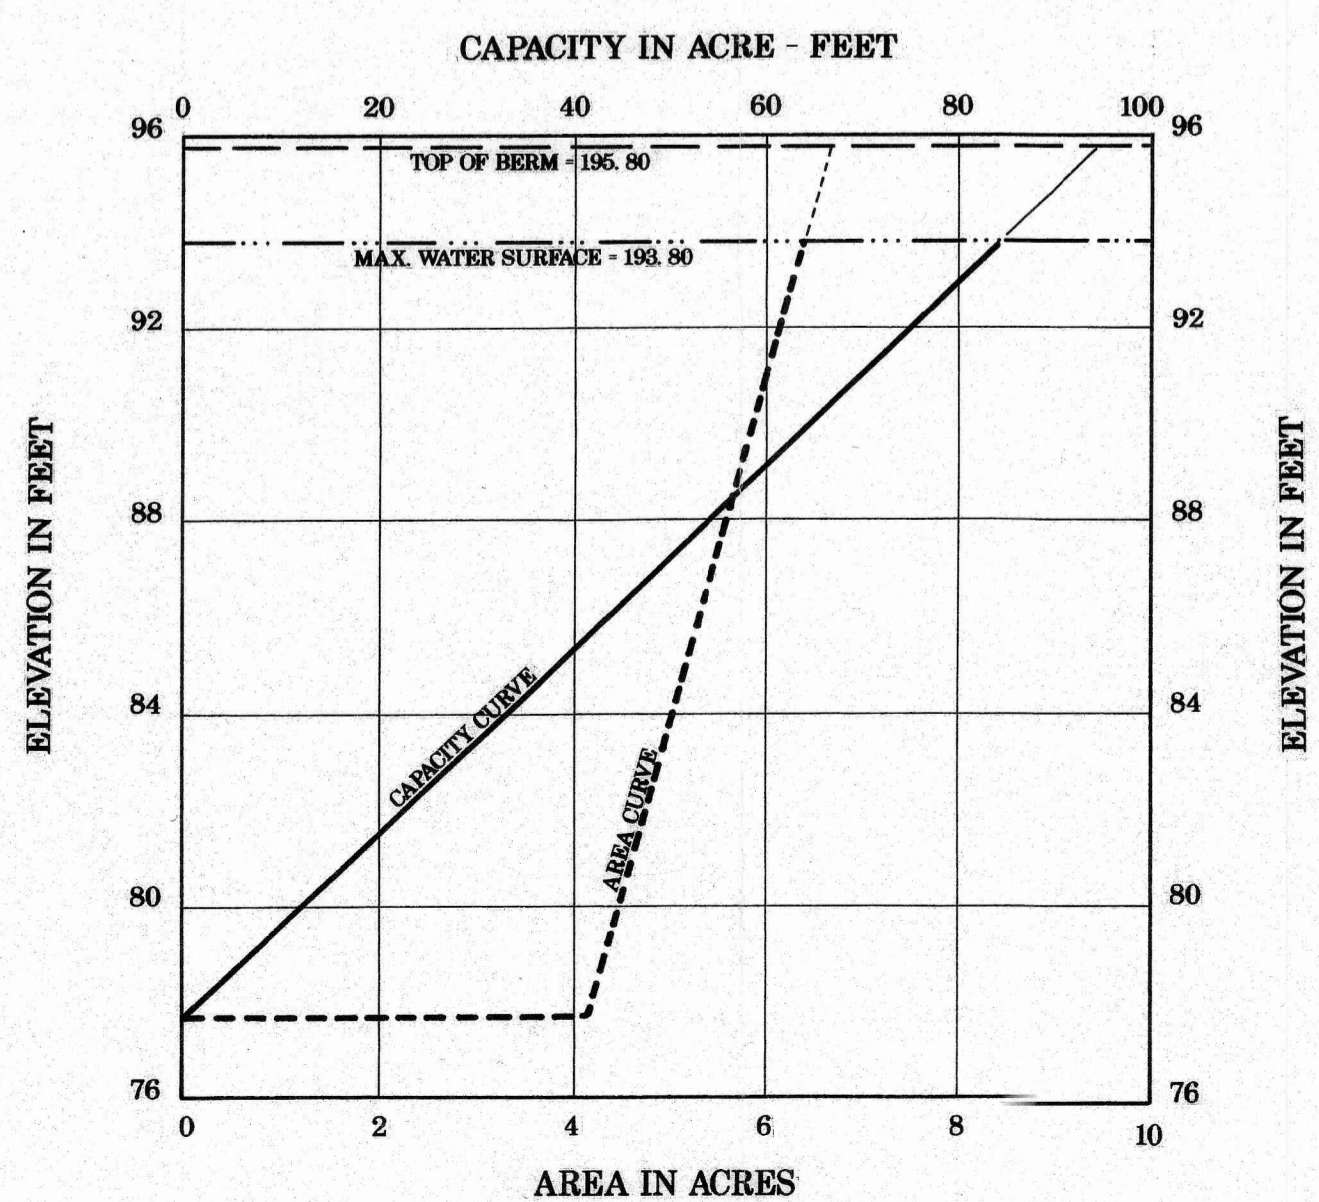

AREA - CAPACITY CURVE

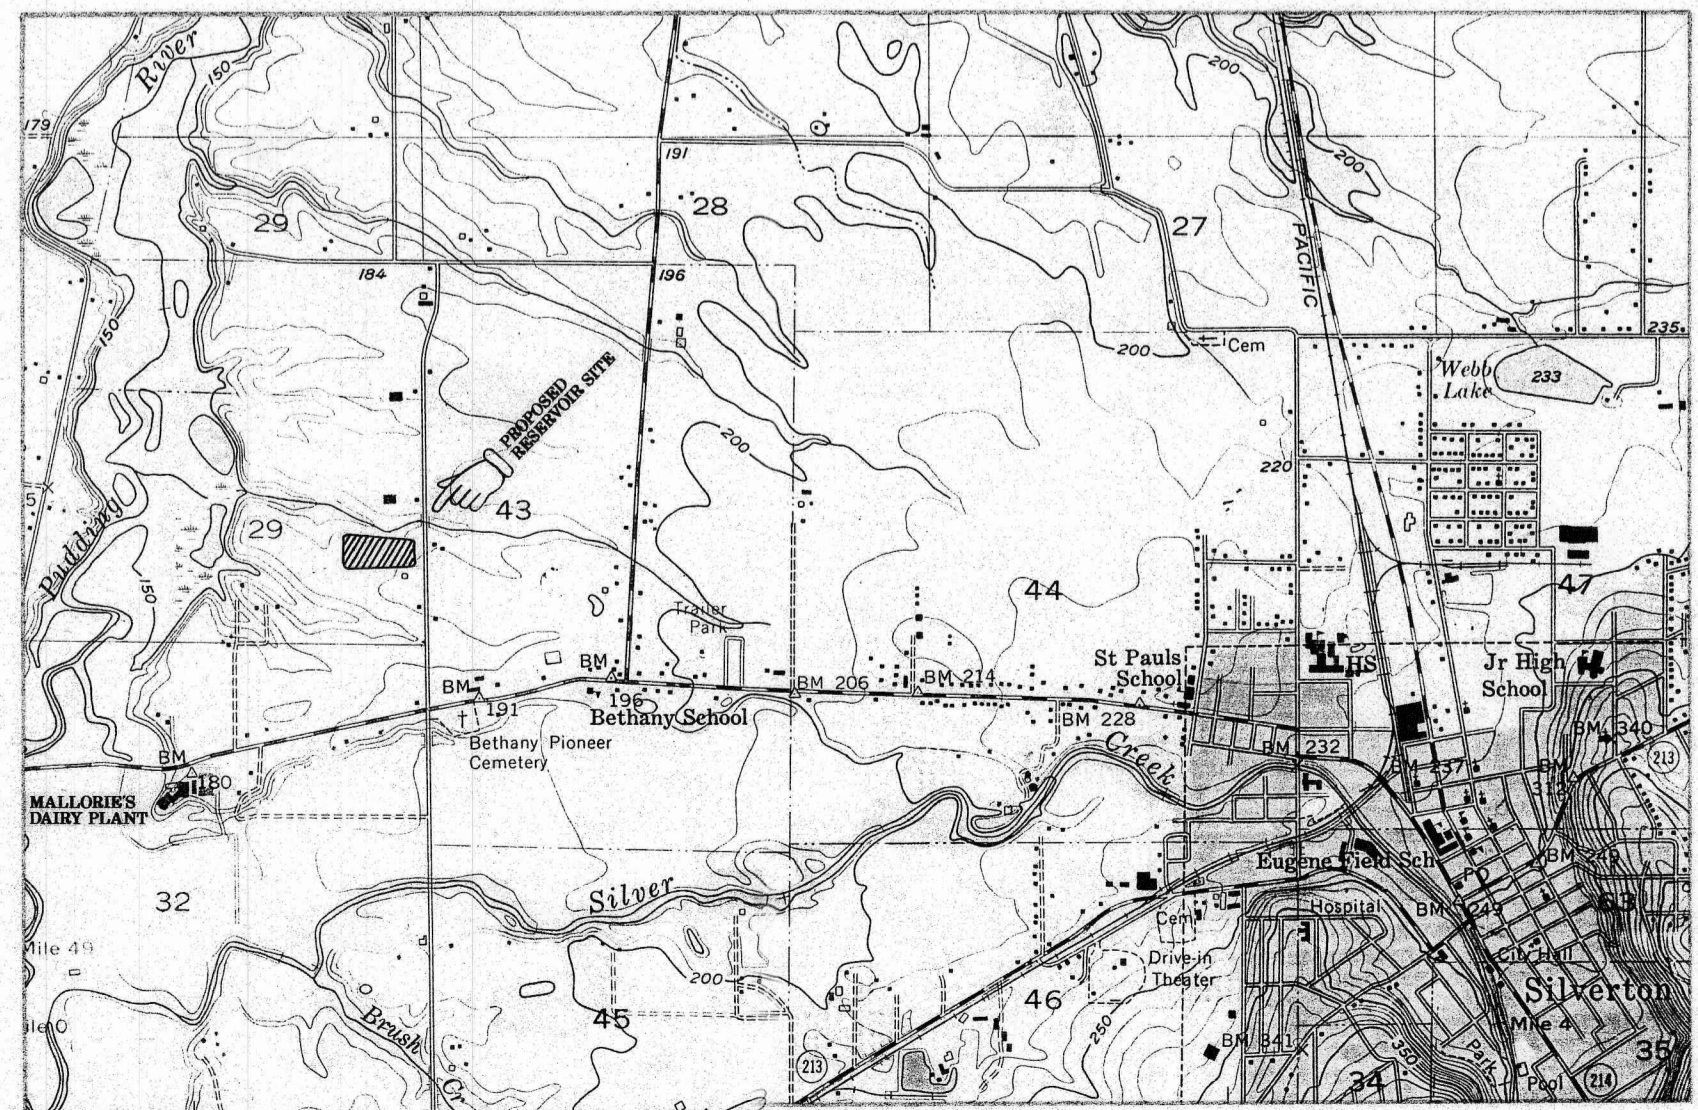

VICINITY MAP

CONTRACTOR SHALL FIELD VERIFY ALL DIMENSIONS AND LOCATE ALL UTILITIES PRIOR TO CONSTRUCTION
CONTRACTOR SHALL VERIFY ALL DIMENSIONS AND MANUFACTURERS' REQUIREMENTS PRIOR TO INSTALLATION


RECEIVED
MAR 22 2019
OWRD

AS - BUILT


ELEVATION DATUM USGS

	MALLORIE'S DAIRY, INC.		
	DAIRY WASTEWATER HOLDING POND		
	P L A N		
	<small>Sec. 29, T. 6 S., R. 1 W., W.M. Marion County, Oregon</small>		
Scale: 1" = 50'	Date: Sept. 23, 1991	Revised: October 4, 1991	
Design: CFB	Boatwright Engineering Inc.		Job No. 282
Drawn: JMPB			2613 12th St. SE. SALEM, OREGON 97302
Checked: CFB	<small>2013 12th St. SE. SALEM, OREGON 97302 (503) 363-9225</small>		1 of 2


R-88765

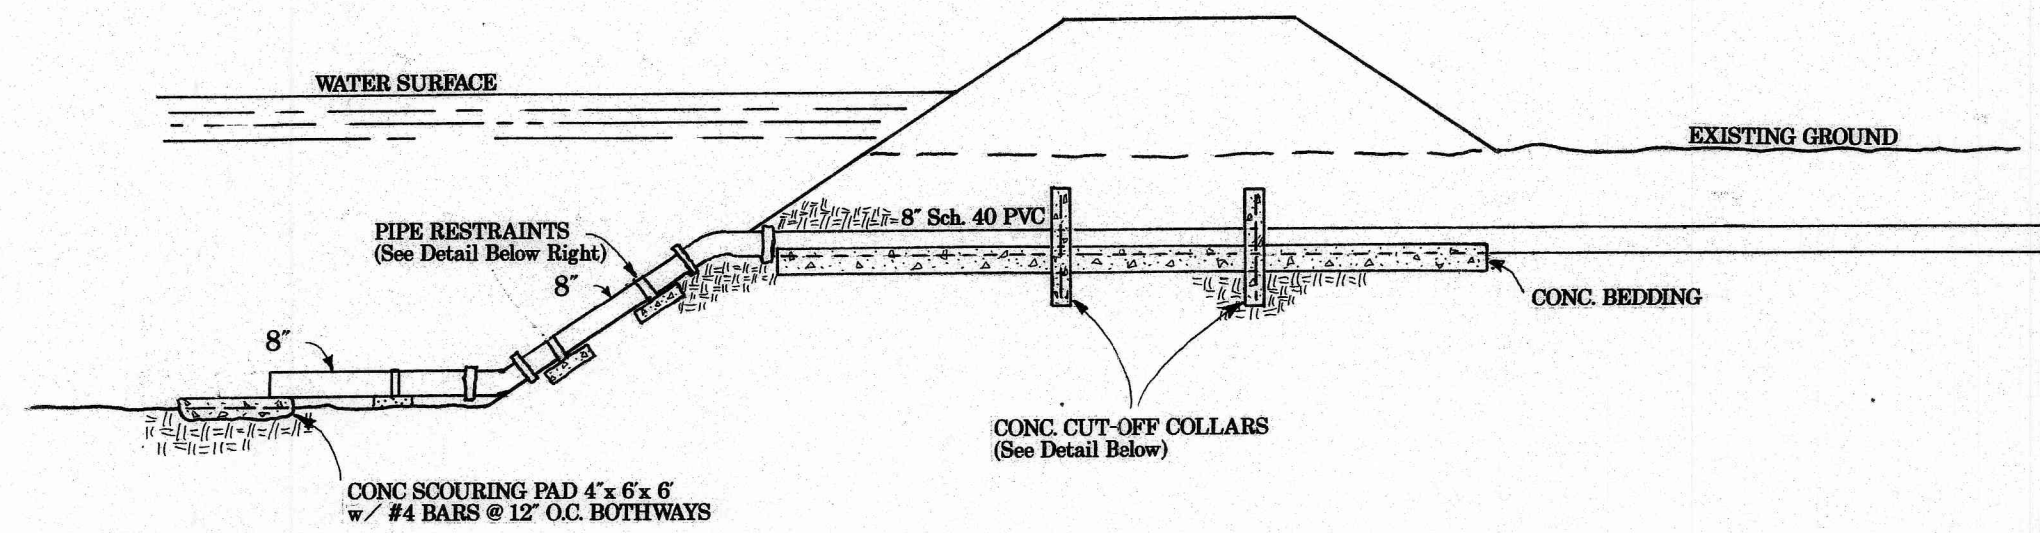


INFLUENT PIPING
NOT TO SCALE

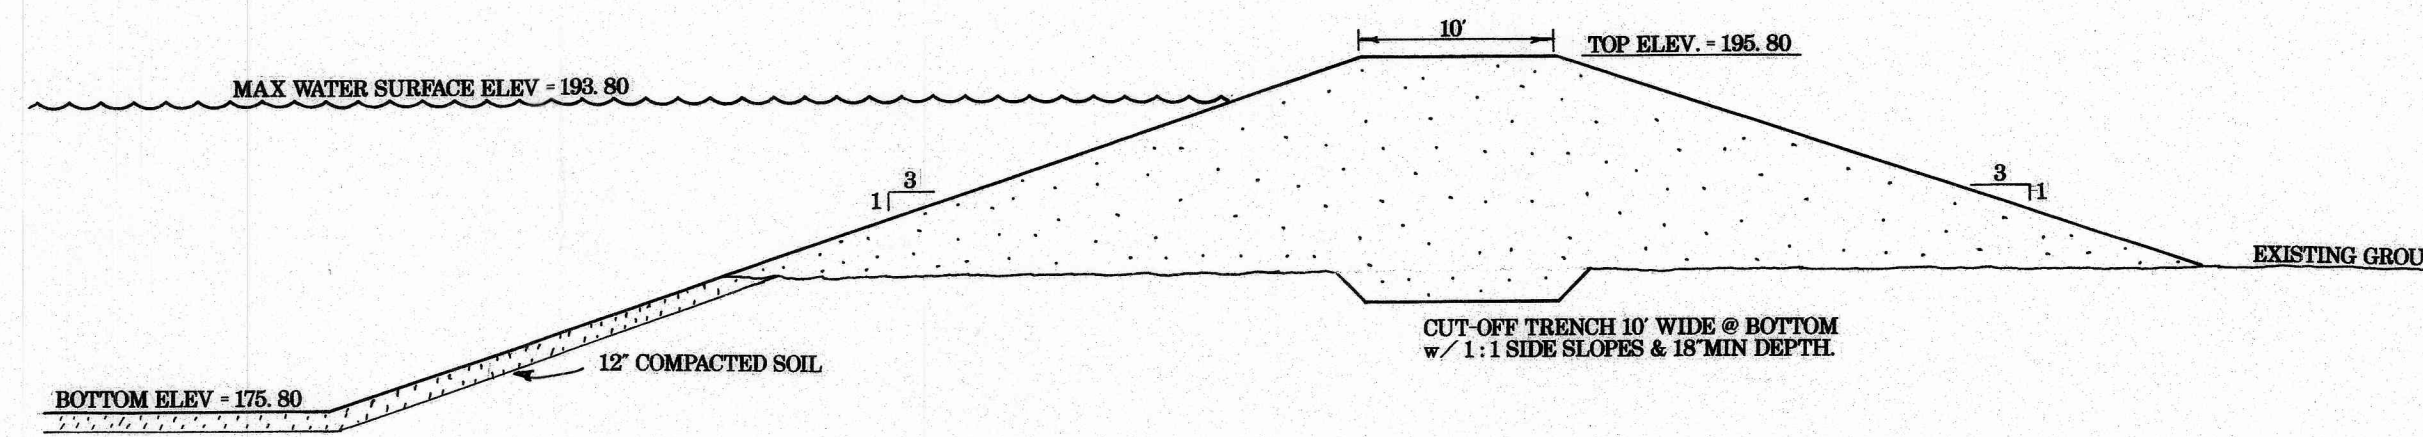


TYPICAL BERM CROSS SECTION
NO SCALE

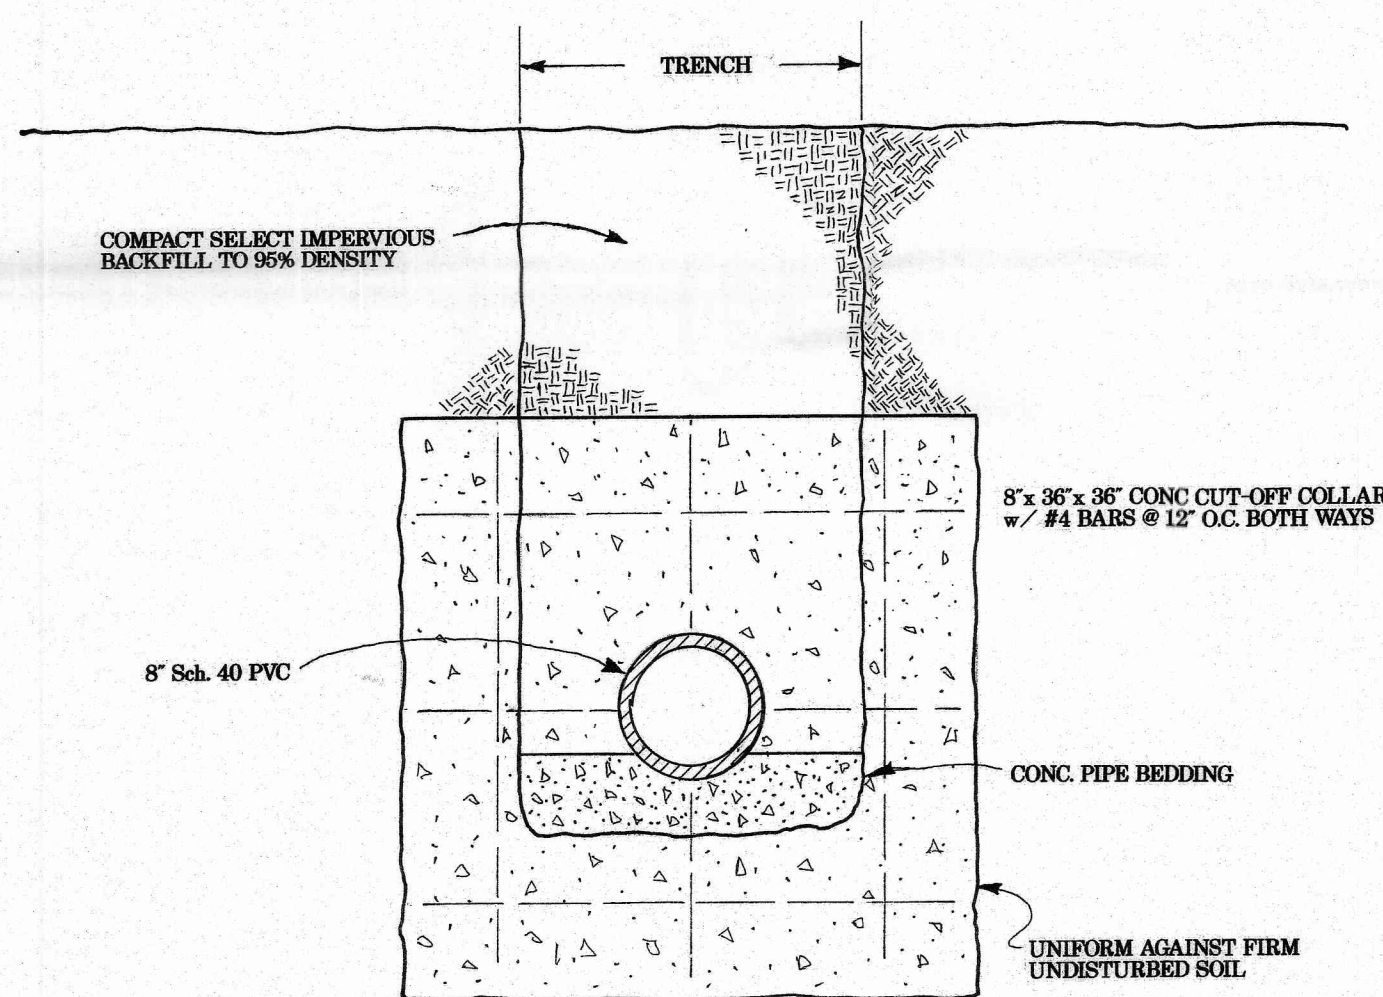


CUT-OFF COLLAR - BEDDING DETAIL
NOT TO SCALE

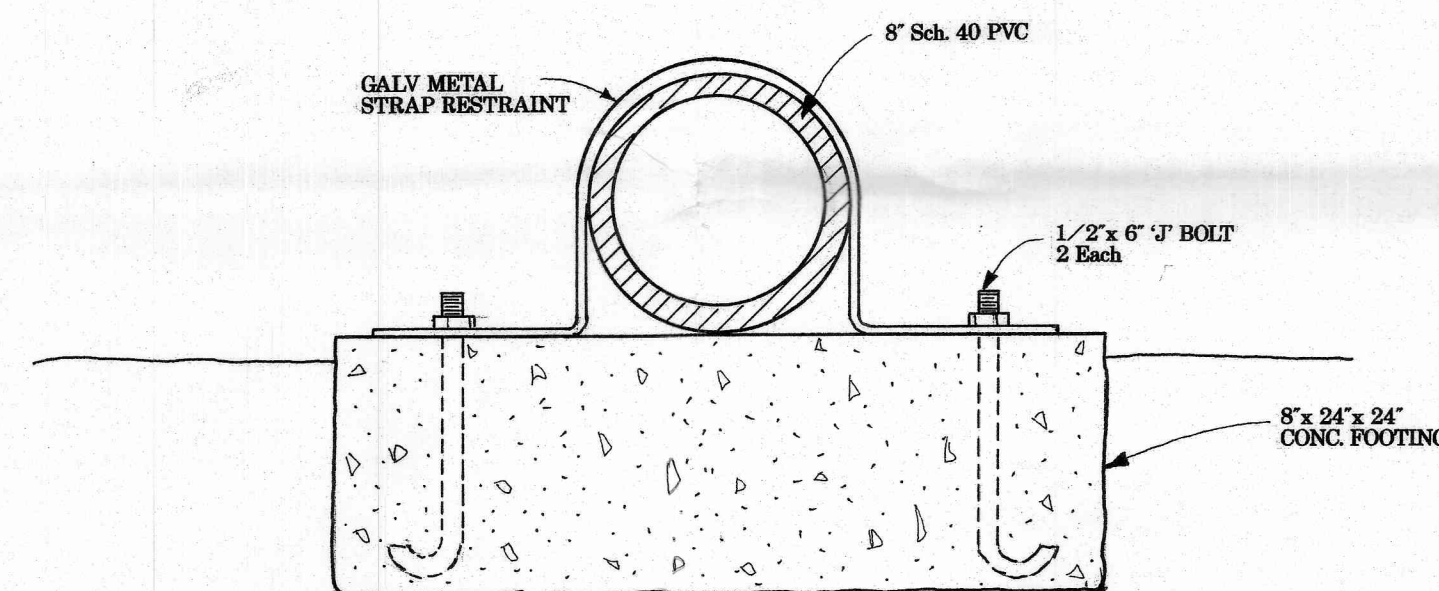

PIPE RESTRAINT DETAIL
NOT TO SCALE

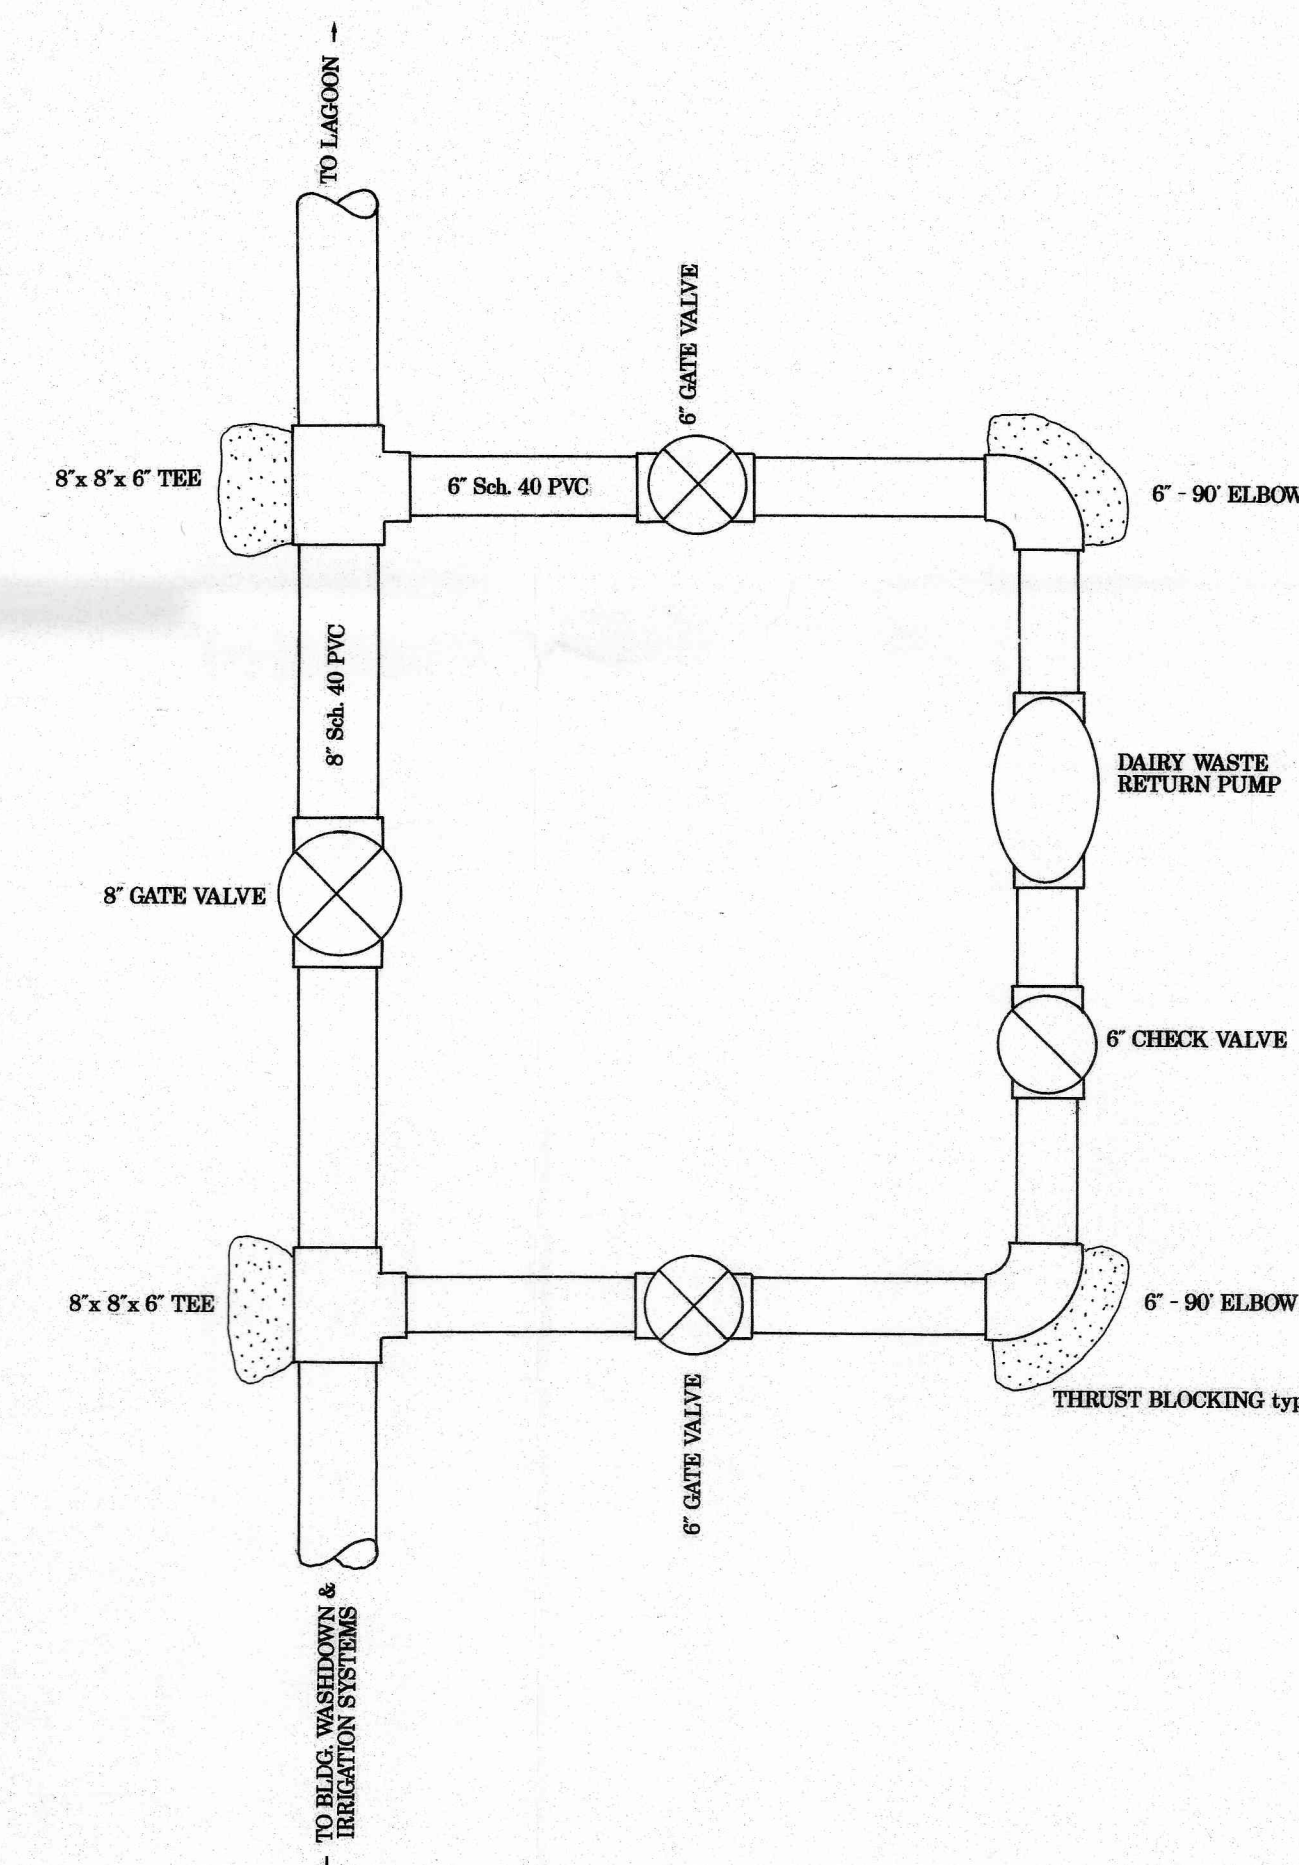

RETURN PUMPING SYSTEM DETAIL
NO SCALE

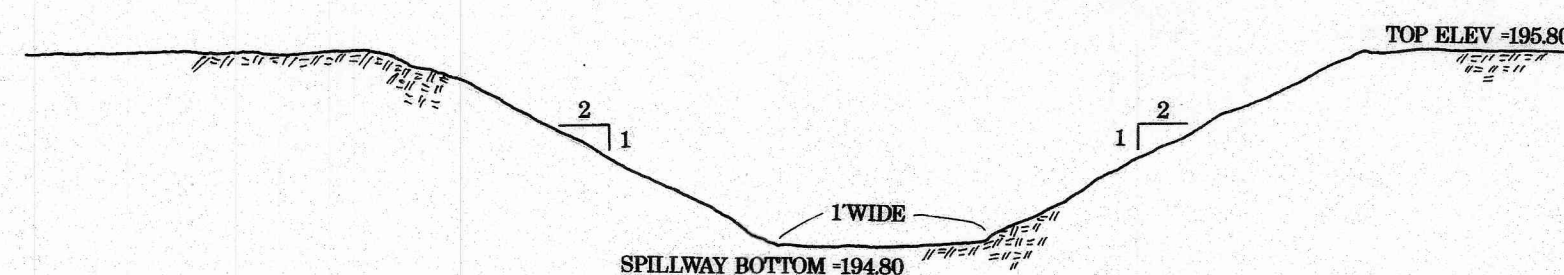

SPILLWAY CROSS SECTION
NO SCALE

RECEIVED
MAR 22 2019
OWRD

AS - BUILT

	MALLORIE'S DAIRY, INC.			
	DAIRY WASTEWATER HOLDING POND			
	MISCELLANEOUS DETAILS			
	Scale: NONE	Date: Sept. 23, 1991	Revised: October 4, 1991	
Design: MGB	Boatwright Engineering Inc.		Job No. 282	
Drawn: WES	2613 12th ST. SE. SALEM, OREGON 97302 (503) 363-9225		Sheet	
Checked: MGB			2 of 2	

R-88765