


ON OF THE SE 1/4 SECTION 17, T. 23S., R 12W.W.M.
COOS COUNTY, OREGON
JUNE 1969

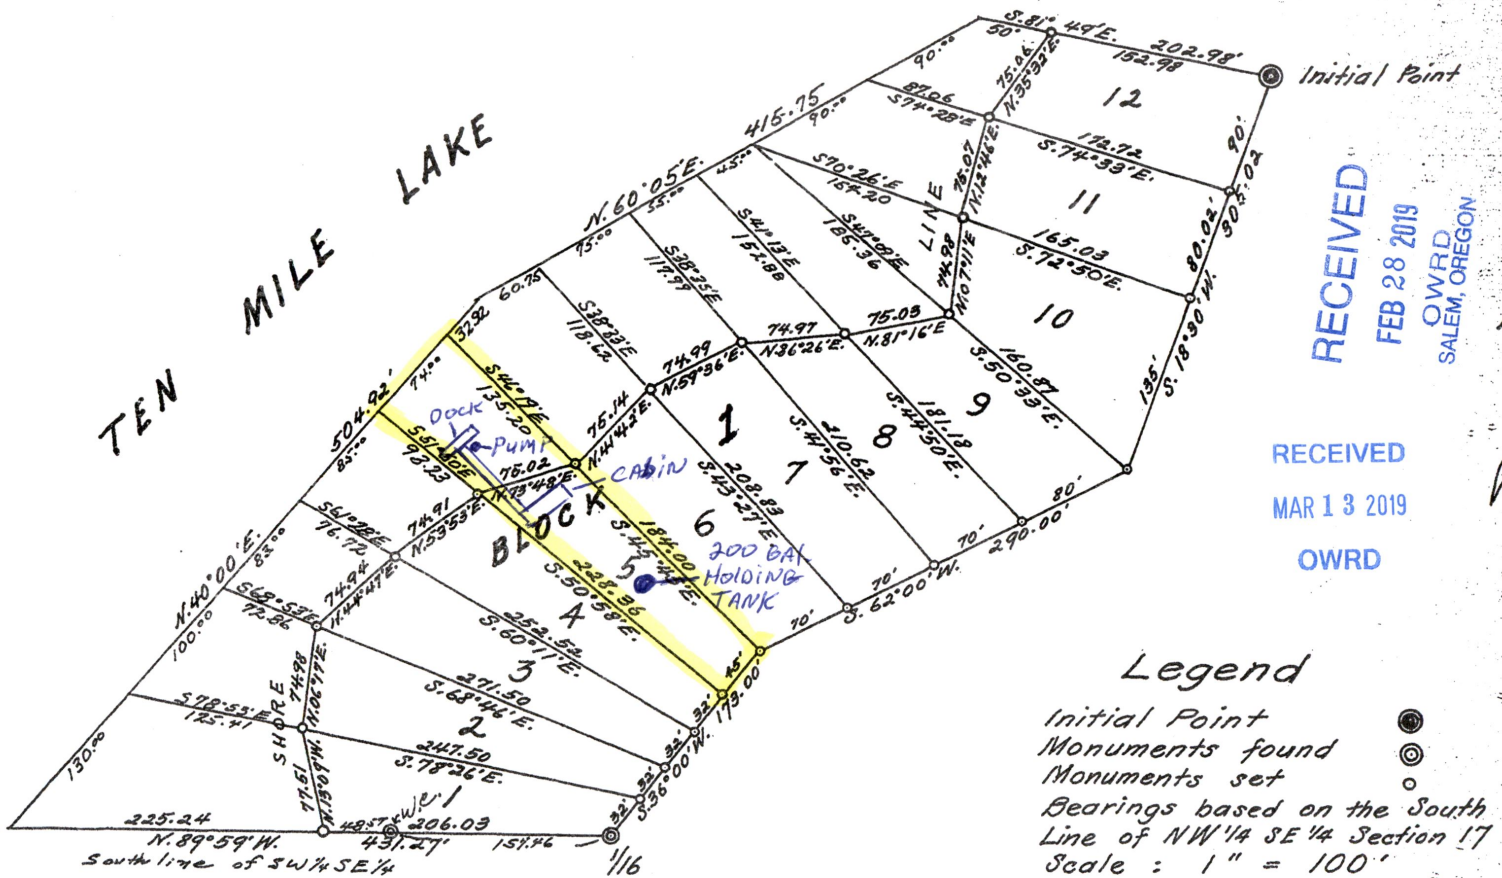

RECEIVED

FEB 28 2019

OWRD
SALEM, OREGON

RECEIVED

MAR 13 2019

OWRD

- 88757

This was the existing system
when we purchased the Cabin
in July 1992.

We use very little water.
its for Dishwashing & showers.
We do not water anything
outside in the yard.



Holding Tank. →



Pump on the Dock.

5-88757

RECEIVED
MAR 13 2019
OWRD


RECEIVED
FEB 28 2019
OWRD
SALEM, OREGON

RECEIVED

MAR 13 2019

OWRD

APPLICATION MAP FOR DAN SCHAFER
LOCATED IN THE NW1/4 OF THE SE1/4 OF SECTION 17
TOWNSHIP 23 SOUTH, RANGE 12 WEST, W.M.,
COOS COUNTY, OREGON

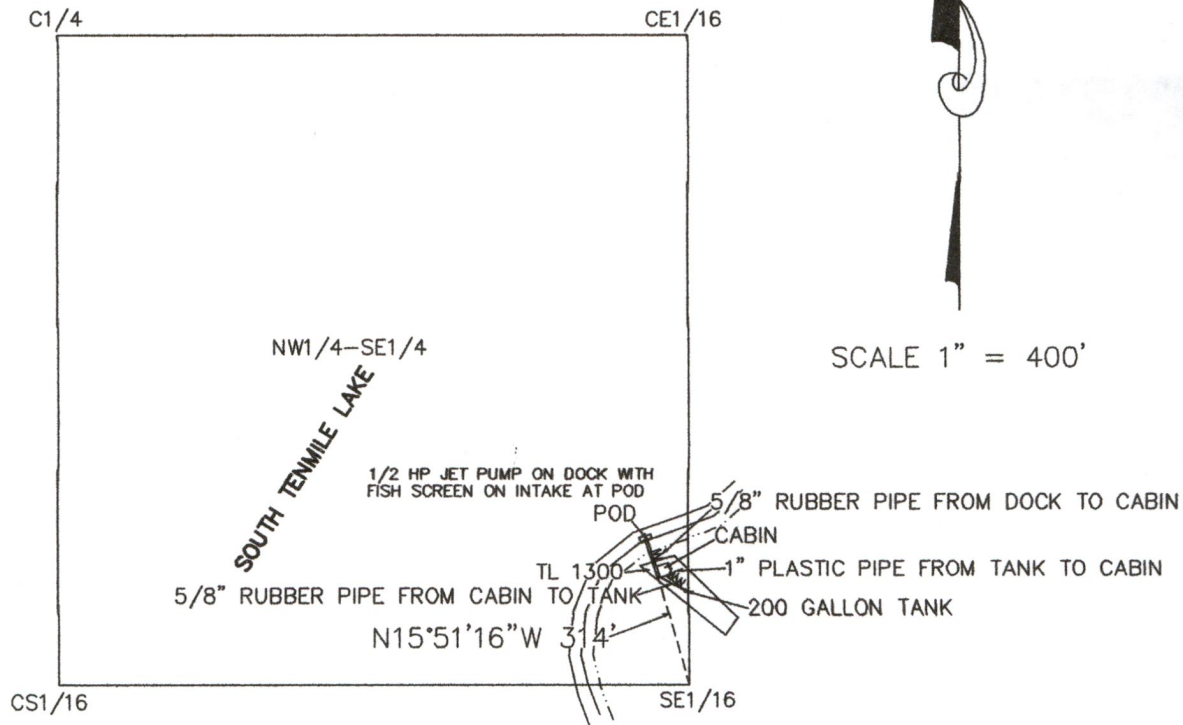


LEGEND:

POD POINT OF DIVERSION

TL TAX LOT

—W— WATER PIPE LINE

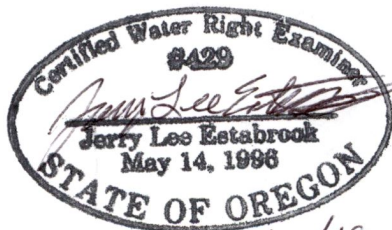

EXPIRES 12/31/19

EXAMINERS DISCLAIMER STATEMENT:

THE PREPARATION OF THIS MAP WAS FOR THE PURPOSE OF
IDENTIFYING THE LOCATION OF WATER RIGHT ONLY AND HAS
NO INTENT TO PROVIDE DIMENSIONS OR LOCATION OF
PROPERTY OWNERSHIP LINES.

5-88757

RECEIVED

FEB 28 2019

OWRD
SALEM, OREGON