


# Human Consumption Place of Use Map 33S-2E-16-NW/NE Tax Lot 204

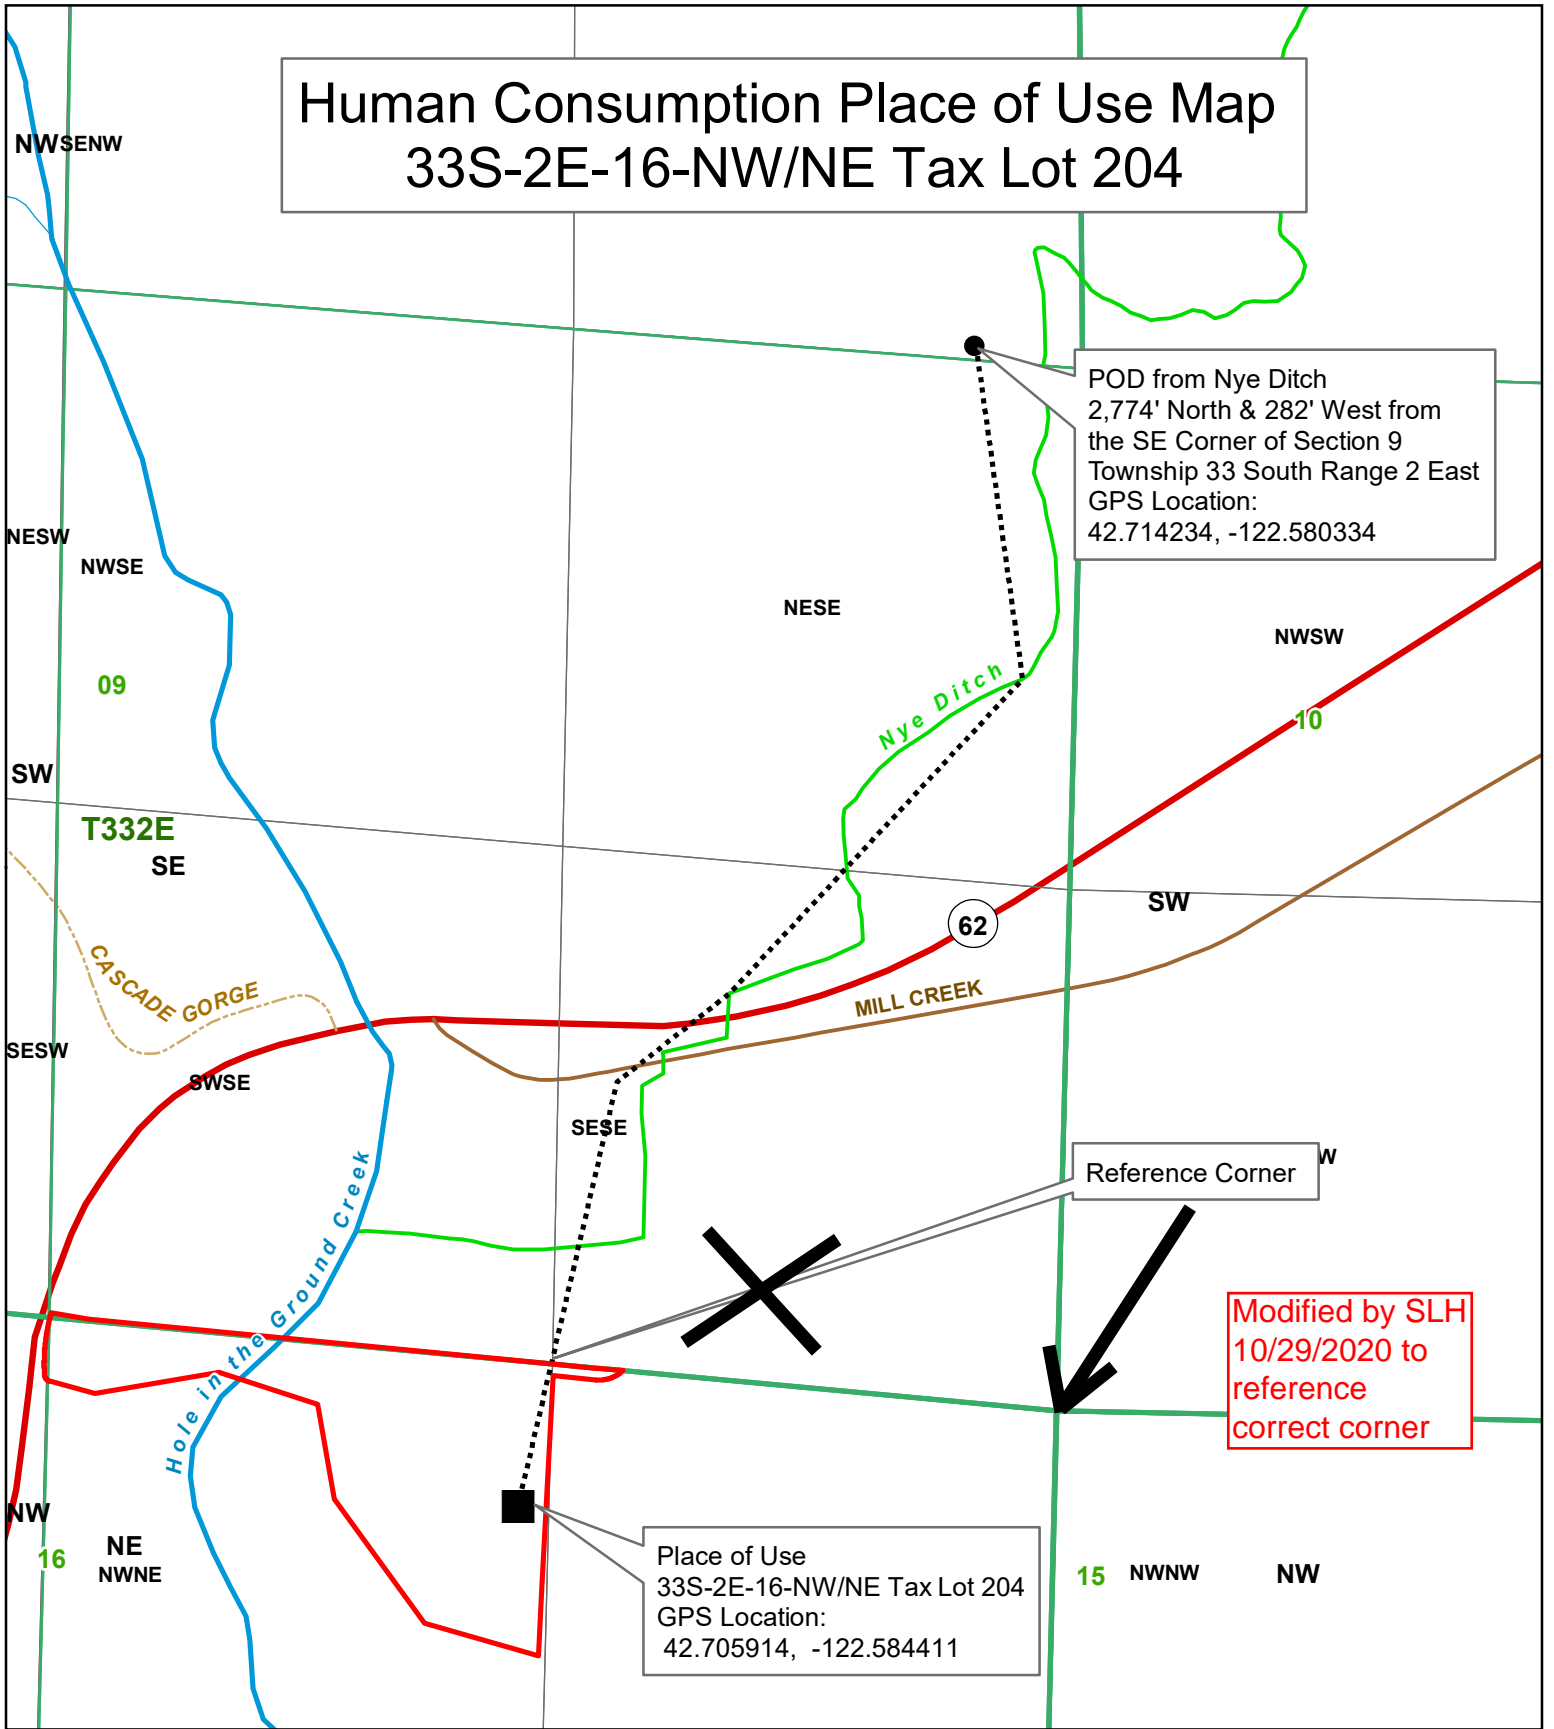

**Legend**

- TL 204 (Red outline)
- Home Site (Black square)
- Townships (Green outline)
- Sections (Green outline)
- Quarter Sections (Light green outline)
- Quarter Quarter Sections (White outline)
- POD from Nye Ditch (Black dot)
- 6" PVC Transport Pipe (Dotted black line)

1 inch = 500 feet

JACKSON COUNTY  
**WATERMASTER**  
Staff

This map is based on a digital database compiled by Jackson County from a variety of sources. Jackson County cannot accept responsibility for errors, omissions, or positional accuracy. There are no warranties, expressed or implied.

Date: 02/12/2019; 33-2E-16-NE-NE TL 204 Bill Hoag.mxd; hayness1