


The sketch below is made solely for the purpose of assisting in locating said premises and the Company assumes no liability for variations, if any, in dimensions and location ascertained by actual survey.

Pioneer National Title Insurance Company
Title and Trust Division

RECEIVED
JUN 6 1973
STATE ENGINEER
SALEM, OREGON

699-0426

INDEX	
COLUMN 2	
NO.	OUT OF INST.
88	
89	
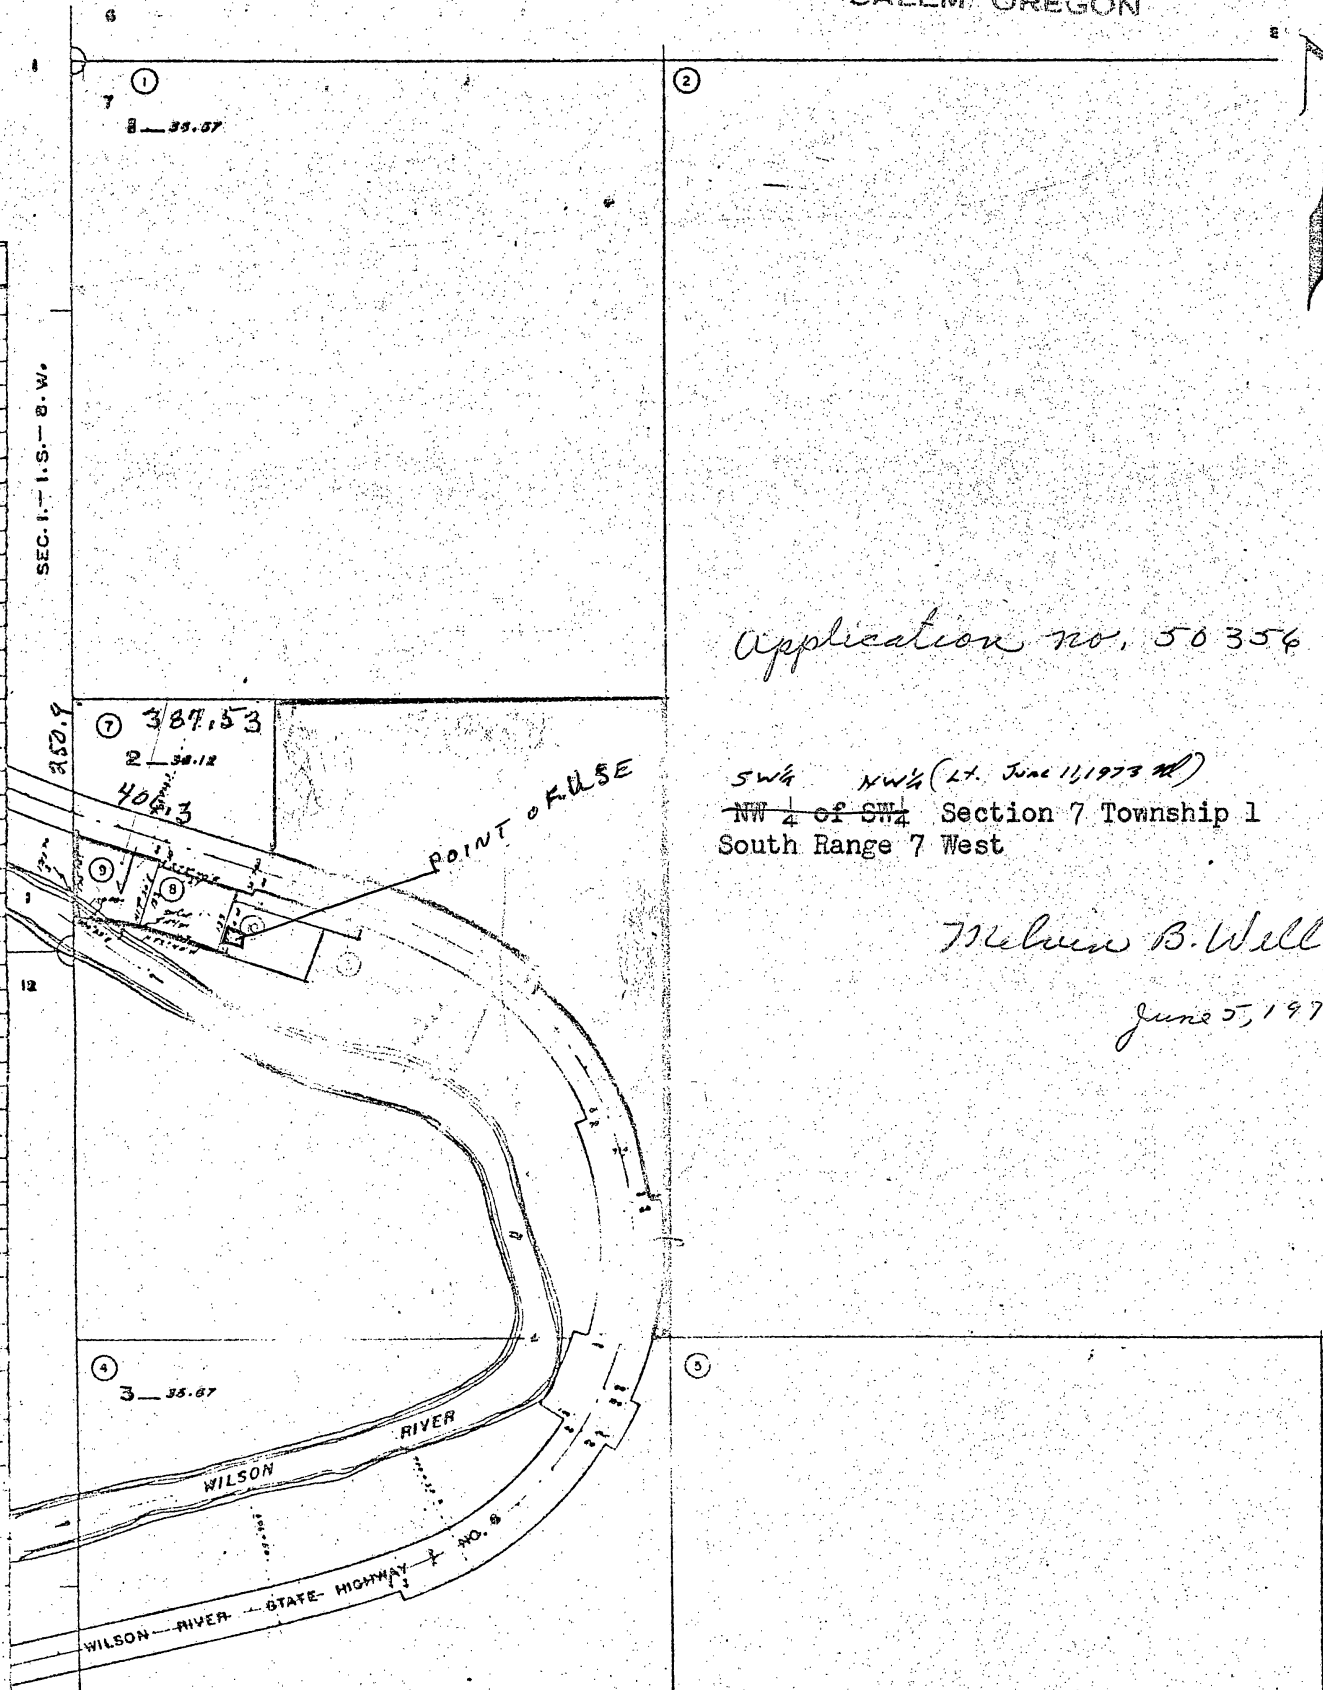

Application no. 50356

SW $\frac{1}{4}$ NW $\frac{1}{4}$ (LT. June 11, 1973 M)
NW $\frac{1}{4}$ of SW $\frac{1}{4}$ Section 7 Township 1
South Range 7 West

Melvin B. Wells
June 5, 1973

29-31049