
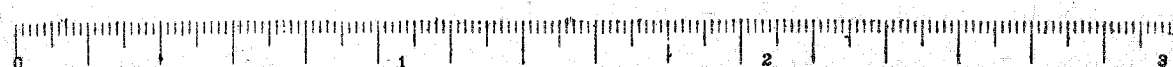


Township 18, S., Range 41, E.W.M.

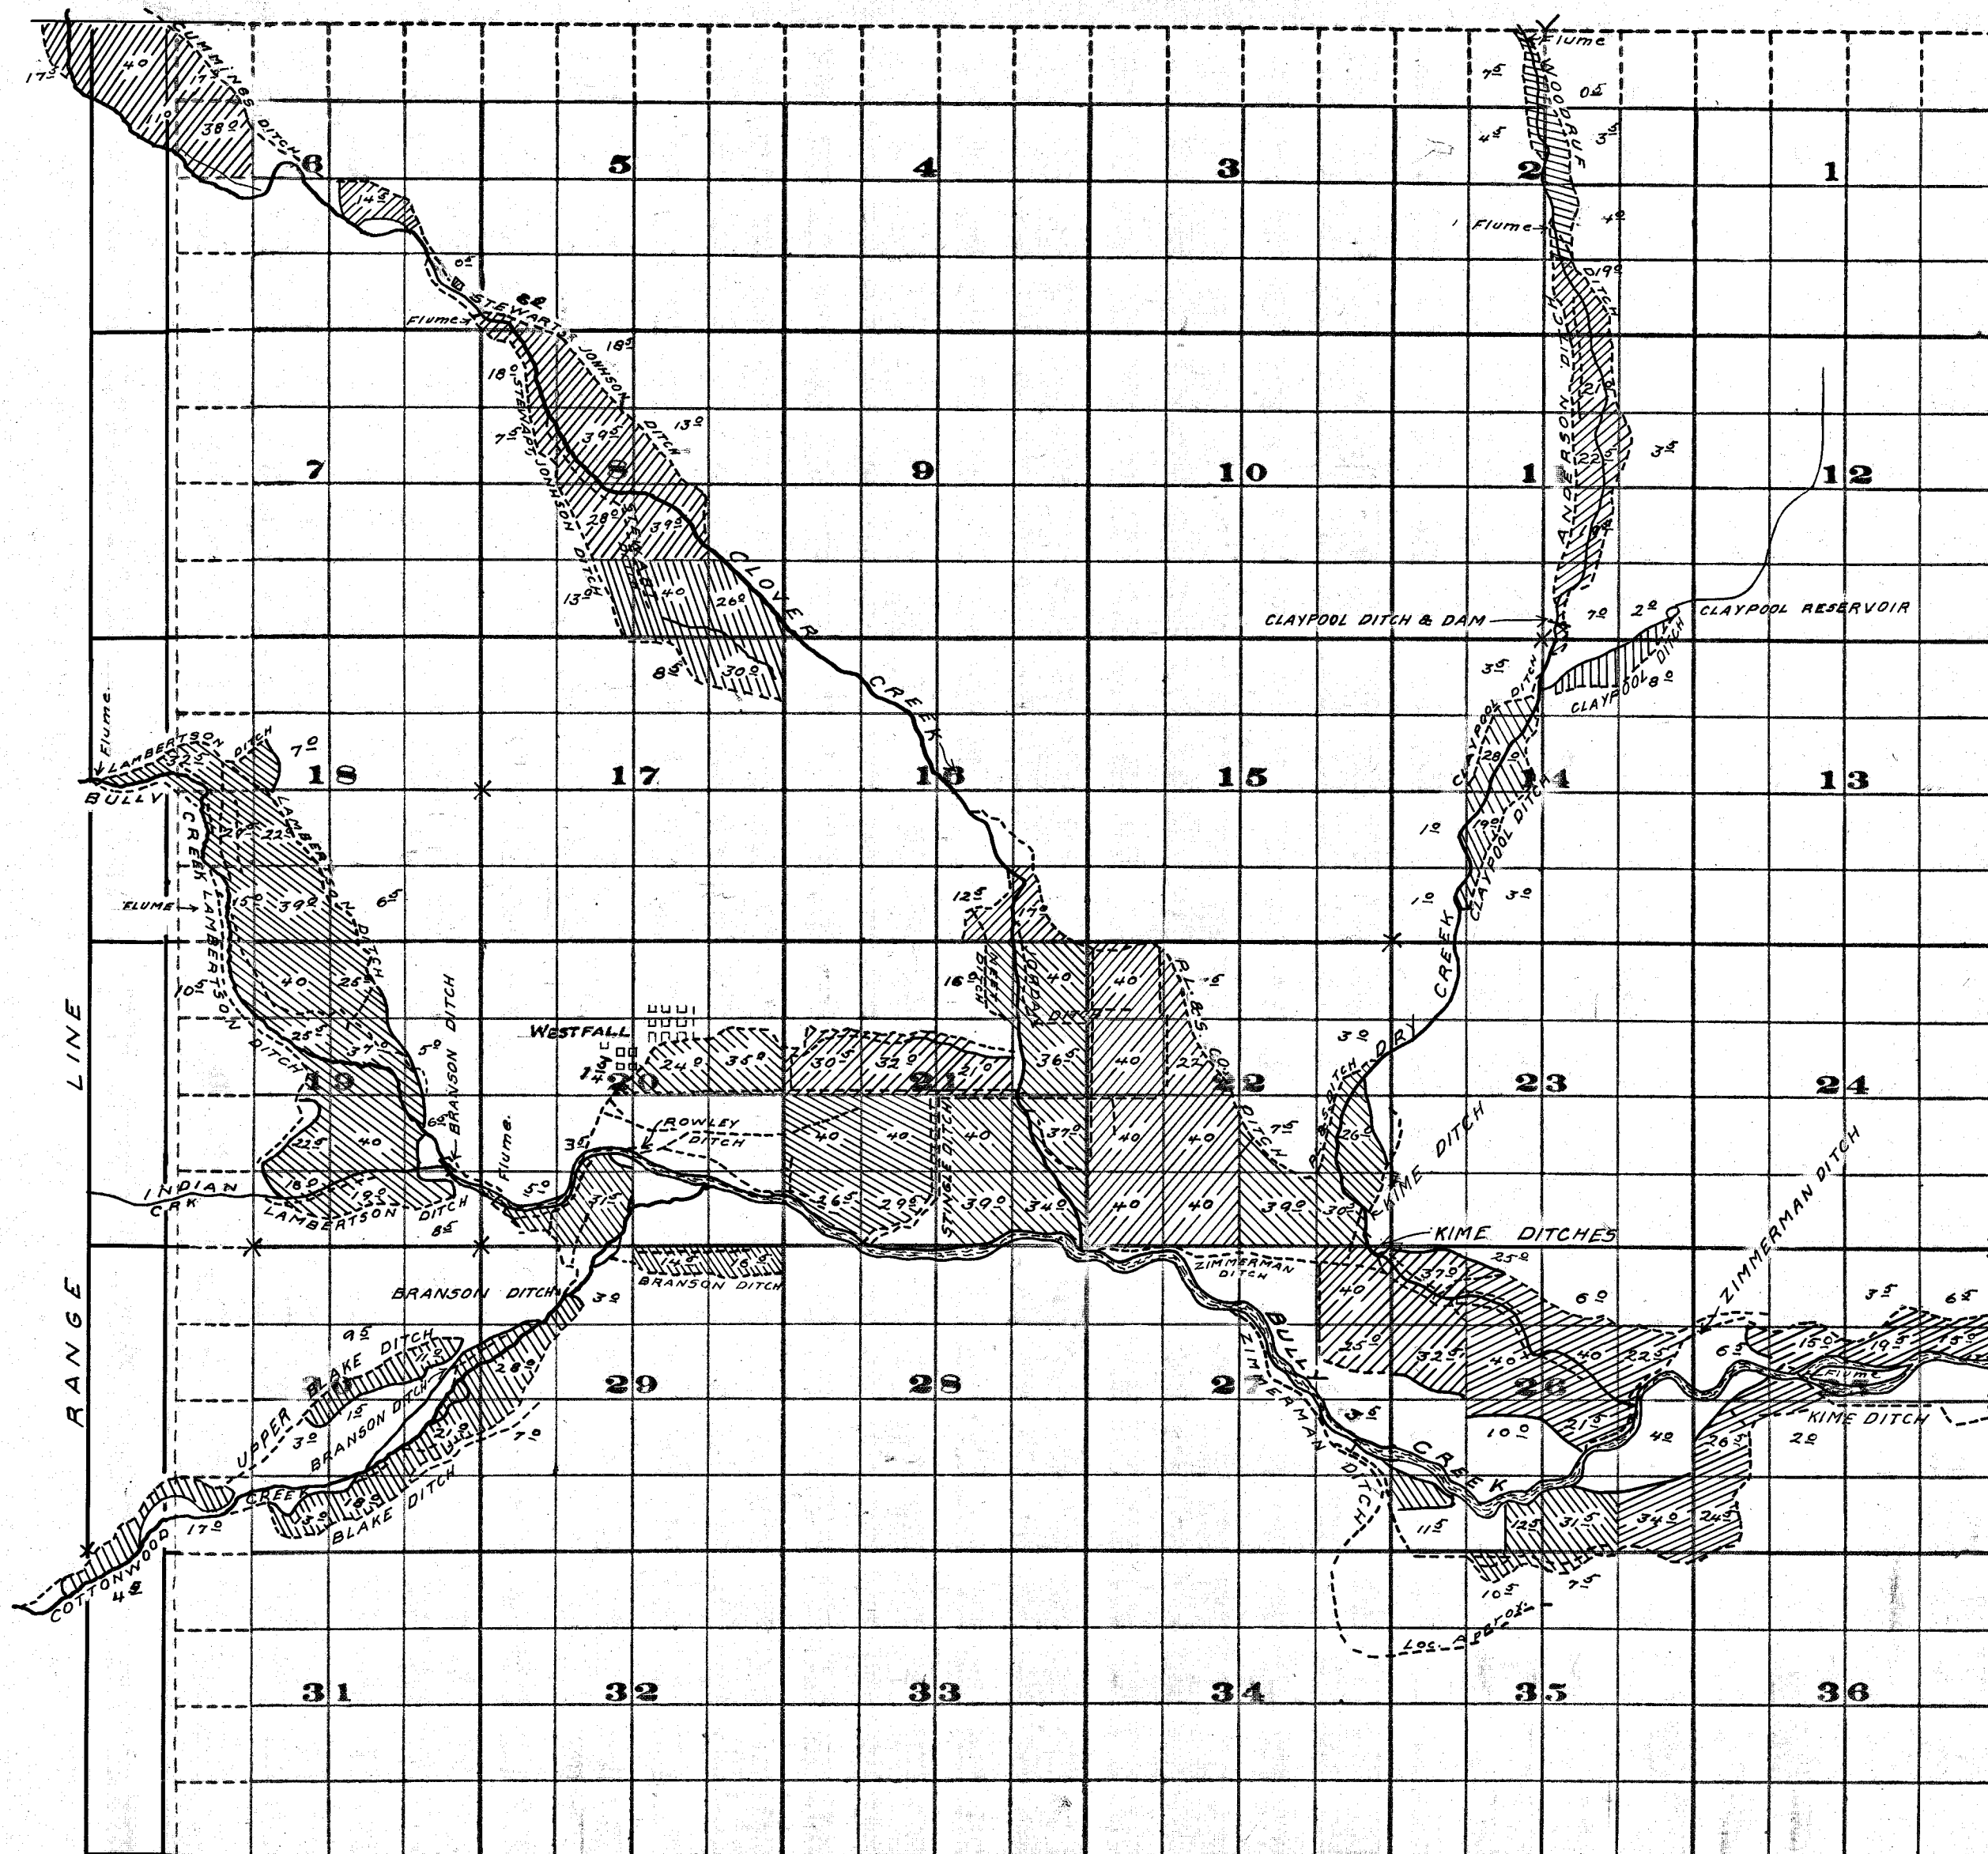

Scale of Feet.

— LEGEND —

- Irrigated land with area
- Streams.
- Ditches.
- Located corners.

Survey June, July, 1913.

FROM OFFICE OF THE STATE ENGINEER, SALEM, OREGON

Adjudication Survey
Malheur River
and
Tributaries.