


East Half Northeast Quarter of T38S R5W Section 23 and West Half Northwest Quarter of T38S R5W Section 24

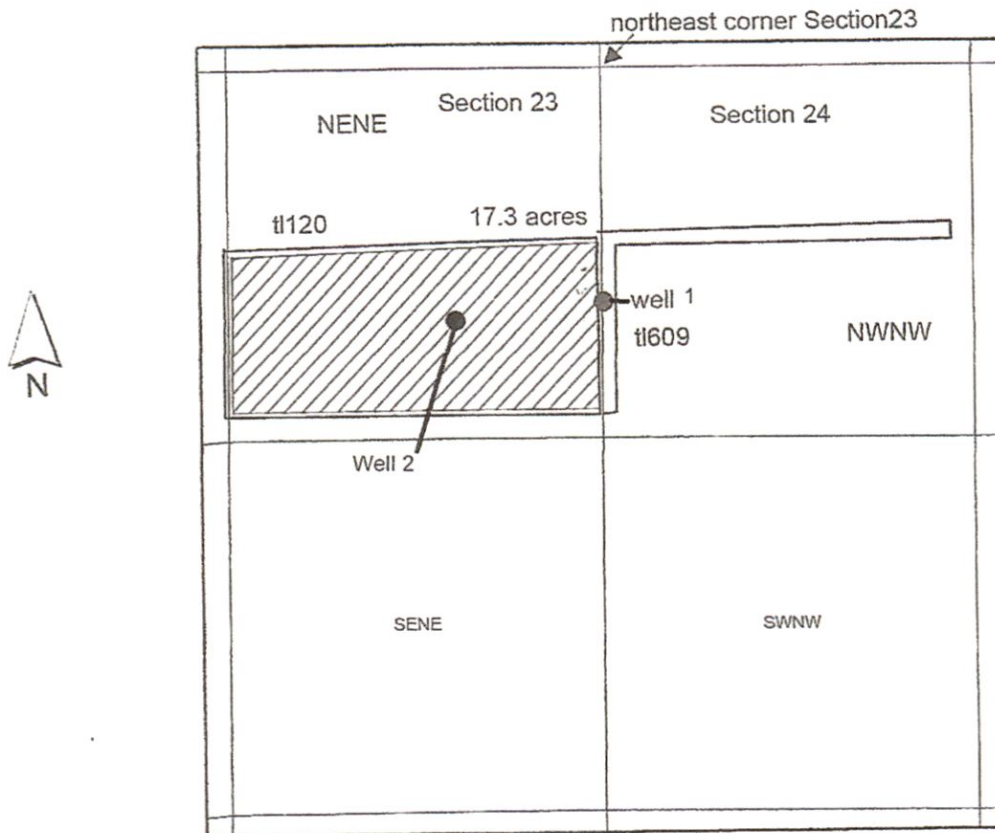

1 inch = 660 feet

RECEIVED

APR 08 2019

OWRD

Well 1 is located approximately 840 ft S and 6 ft E from the NE corner of Section 23

Well 2 would be located approximately 900 ft S and 500 ft W from the NE corner of Section 23

G-18812