


Yamhill County Map

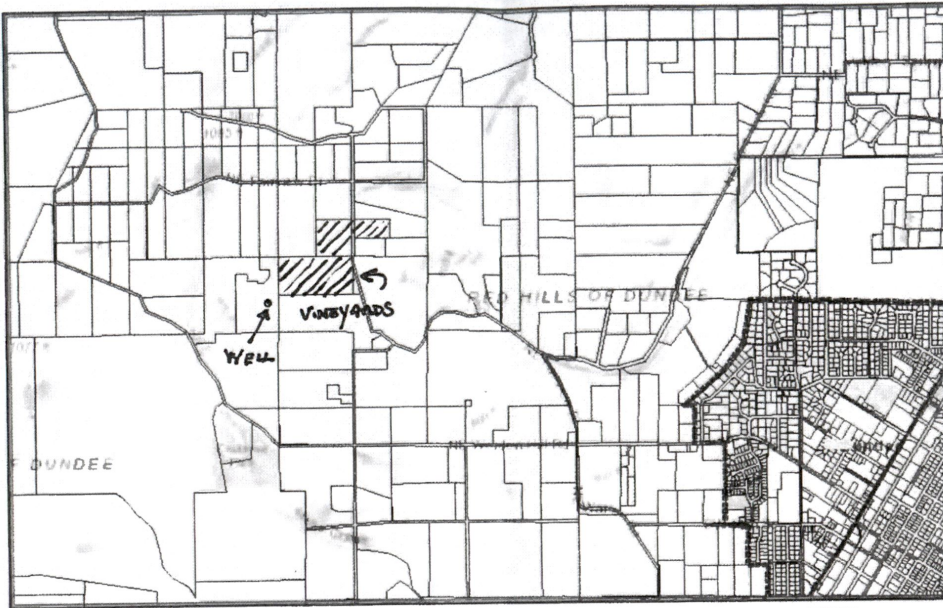

April 3, 2019

- Taxlots
- City Boundary
- Townships
- Restricted_Ground Water
- county
- County Roads
- SL

1:28,800

0 0.17 0.35 0.7 mi

0 0.28 0.55 1.1 km

Sources: Esri, HERE, Garmin, Intermap, increment P Corp., GEBCO, USGS.

Yamhill County GIS
Yamhill County 2018

RAND E HOLDINGS, LLC
Limited water USE LICENSE

RECEIVED
APR 22 2019
OWRD

LL 1780


Yamhill County Map



April 3, 2019

- Taxlots
- Restricted_Ground Water
- SL
- City Boundary
- county
- County Roads
- Townships


RANDÉ Holdings, LLC
Limited Water Use Lic.

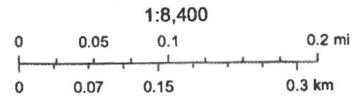

Sources: Esri, HERE, Garmin, Intermap, increment P Corp., GEBCO, USGS,

Yamhill County GIS
Yamhill County 2018

LL 1780

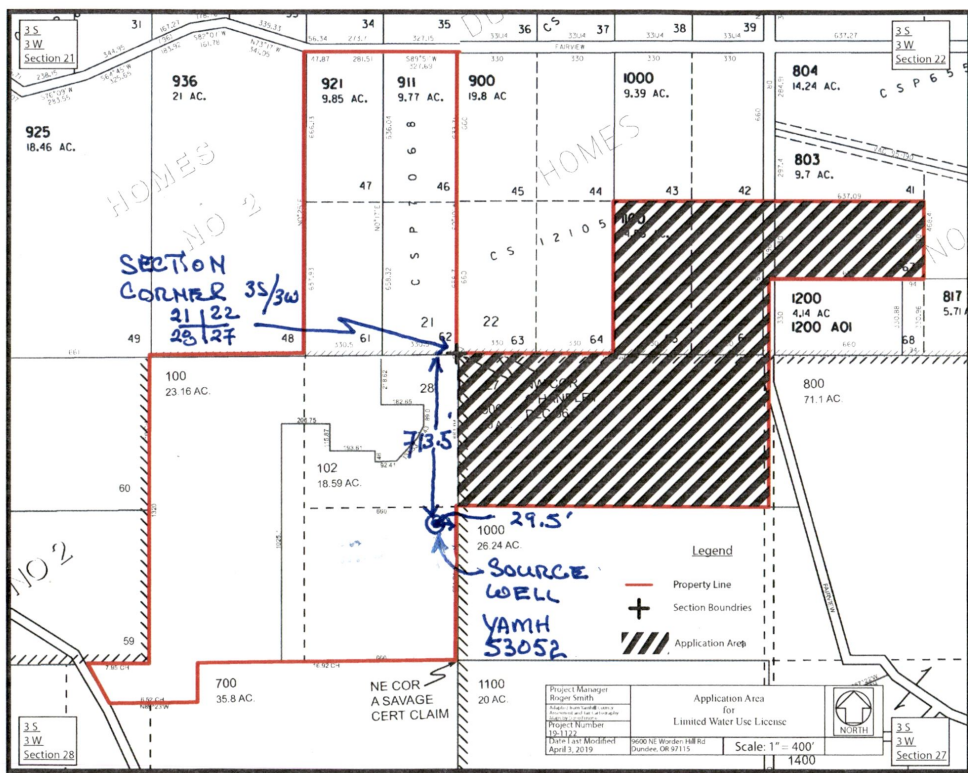


RECEIVED
 APR 22 2019
 OWRD

LL 1780

Limite Water Use License

Yamhill Co. (3S 3W) Sections 21, 22, 27 and 28. Water source is well YAMH 53052. Application area shown on attached map

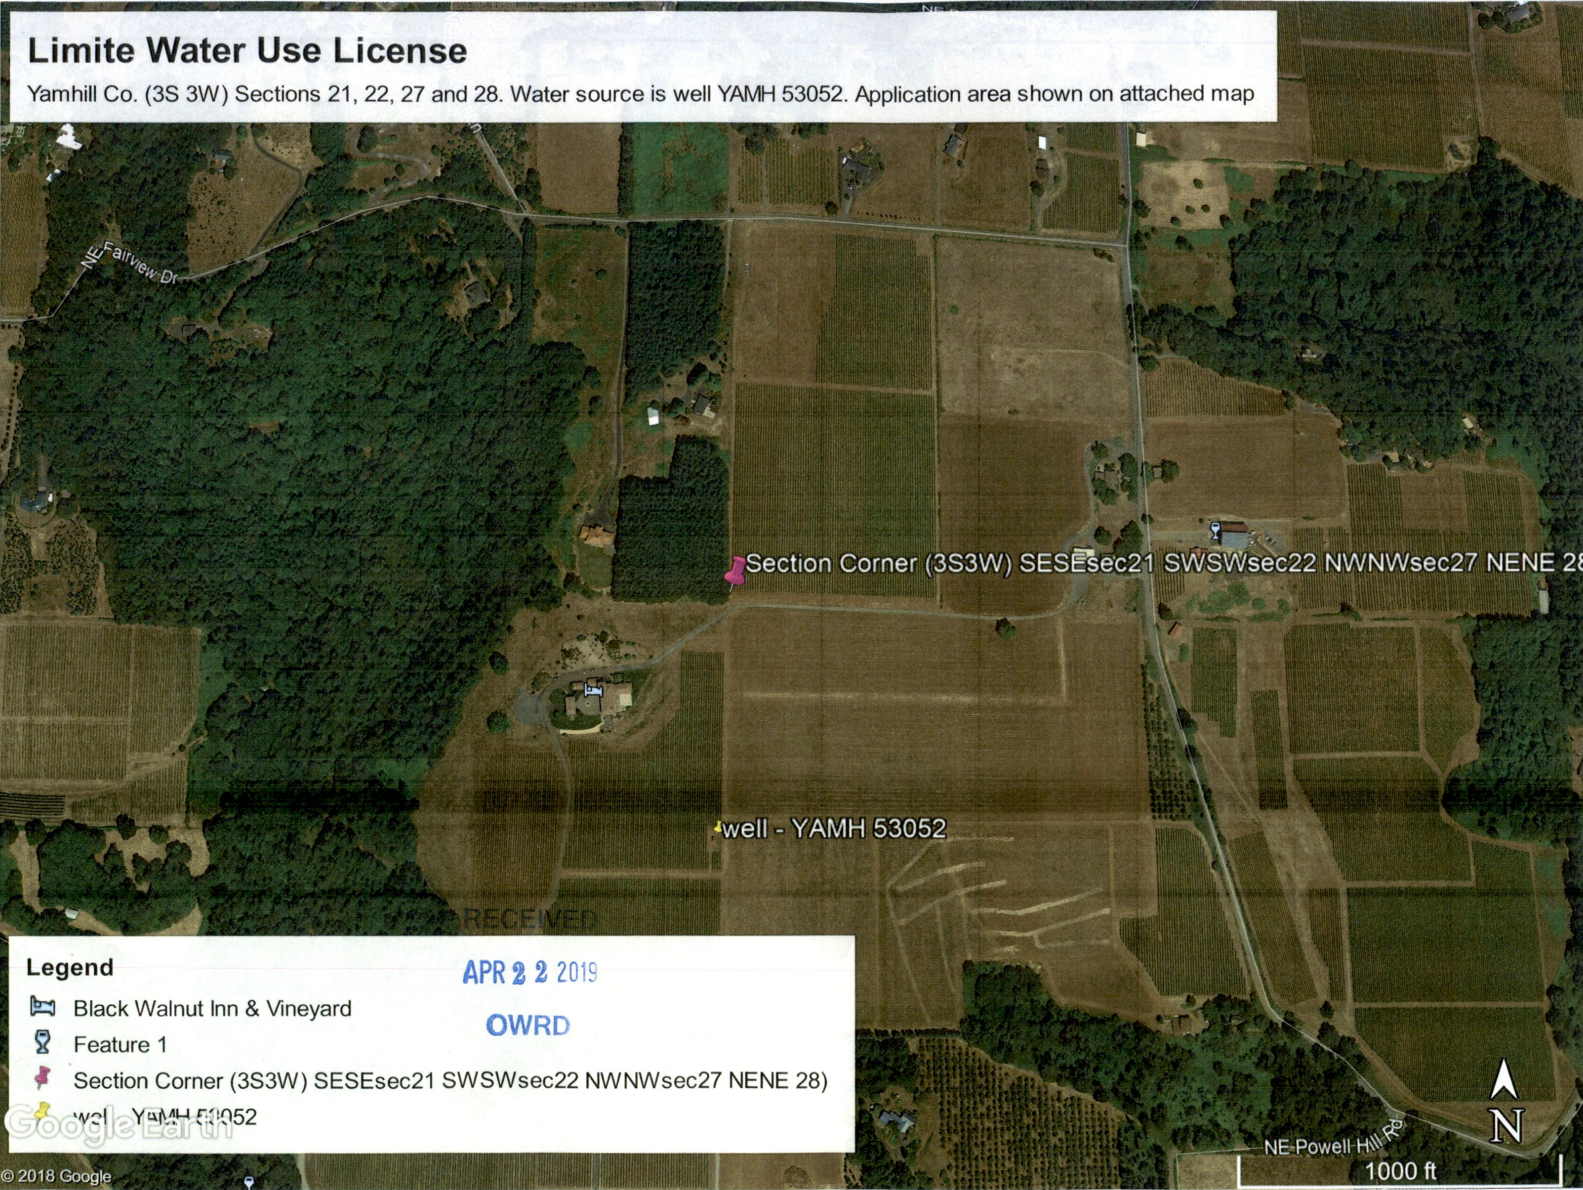

Legend

- Black Walnut Inn & Vineyard
- Feature 1
- Section Corner (3S3W) SESEsec21 SWSWsec22 NWNWsec27 NENE 28)
- well - YAMH 53052


APR 22 2019

OWRD

Google Earth

© 2018 Google
LL 1780



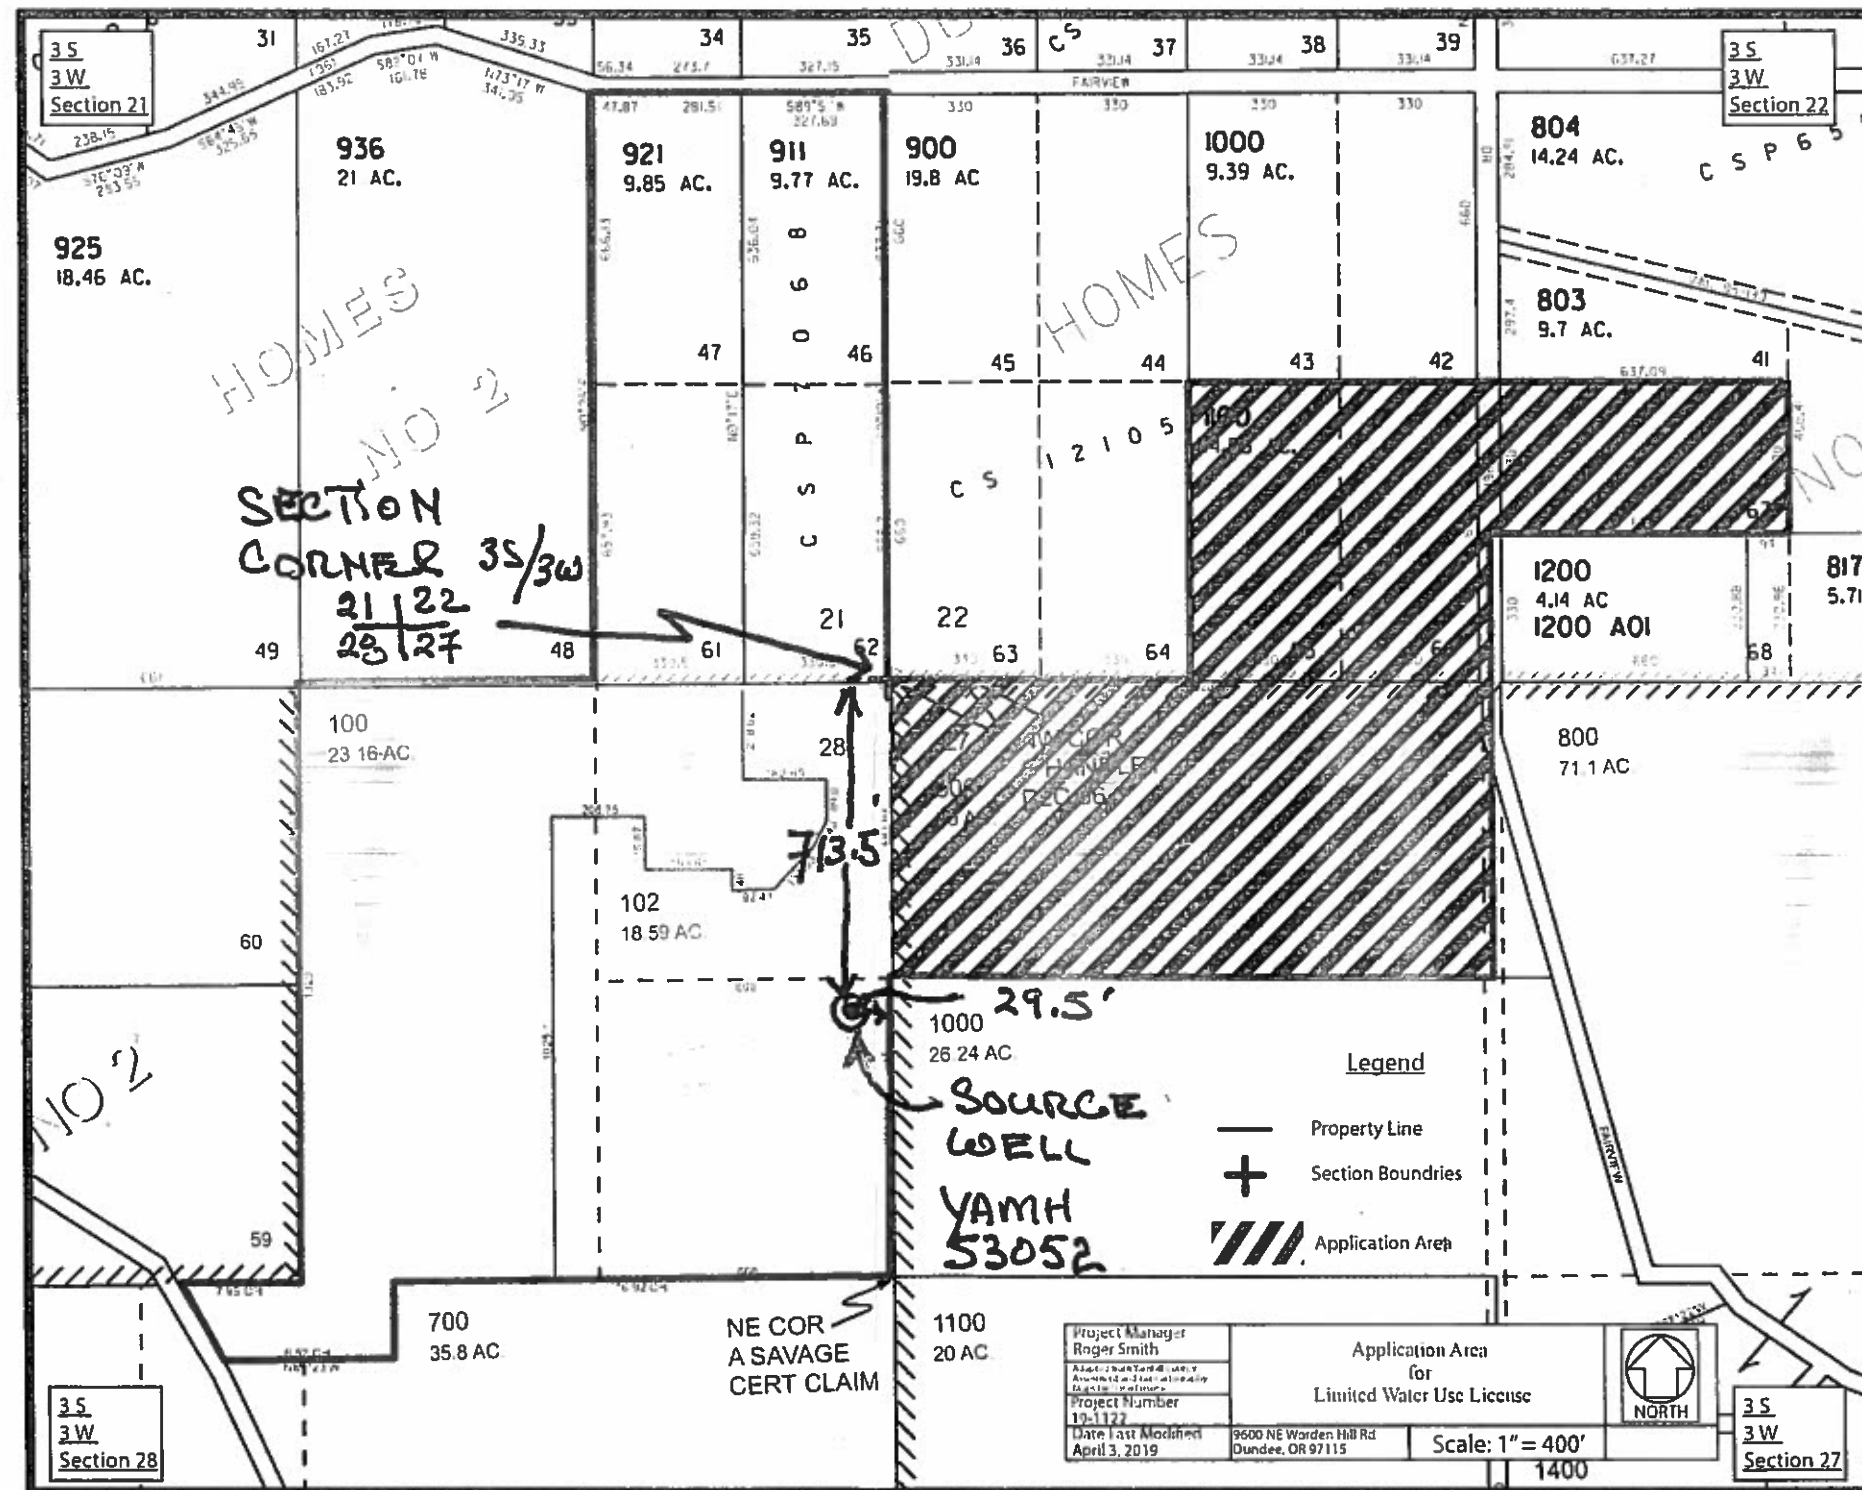

RECEIVED
 APR 22 2019
 OWRD