


Township 28 South, Range 35 E.W.M.

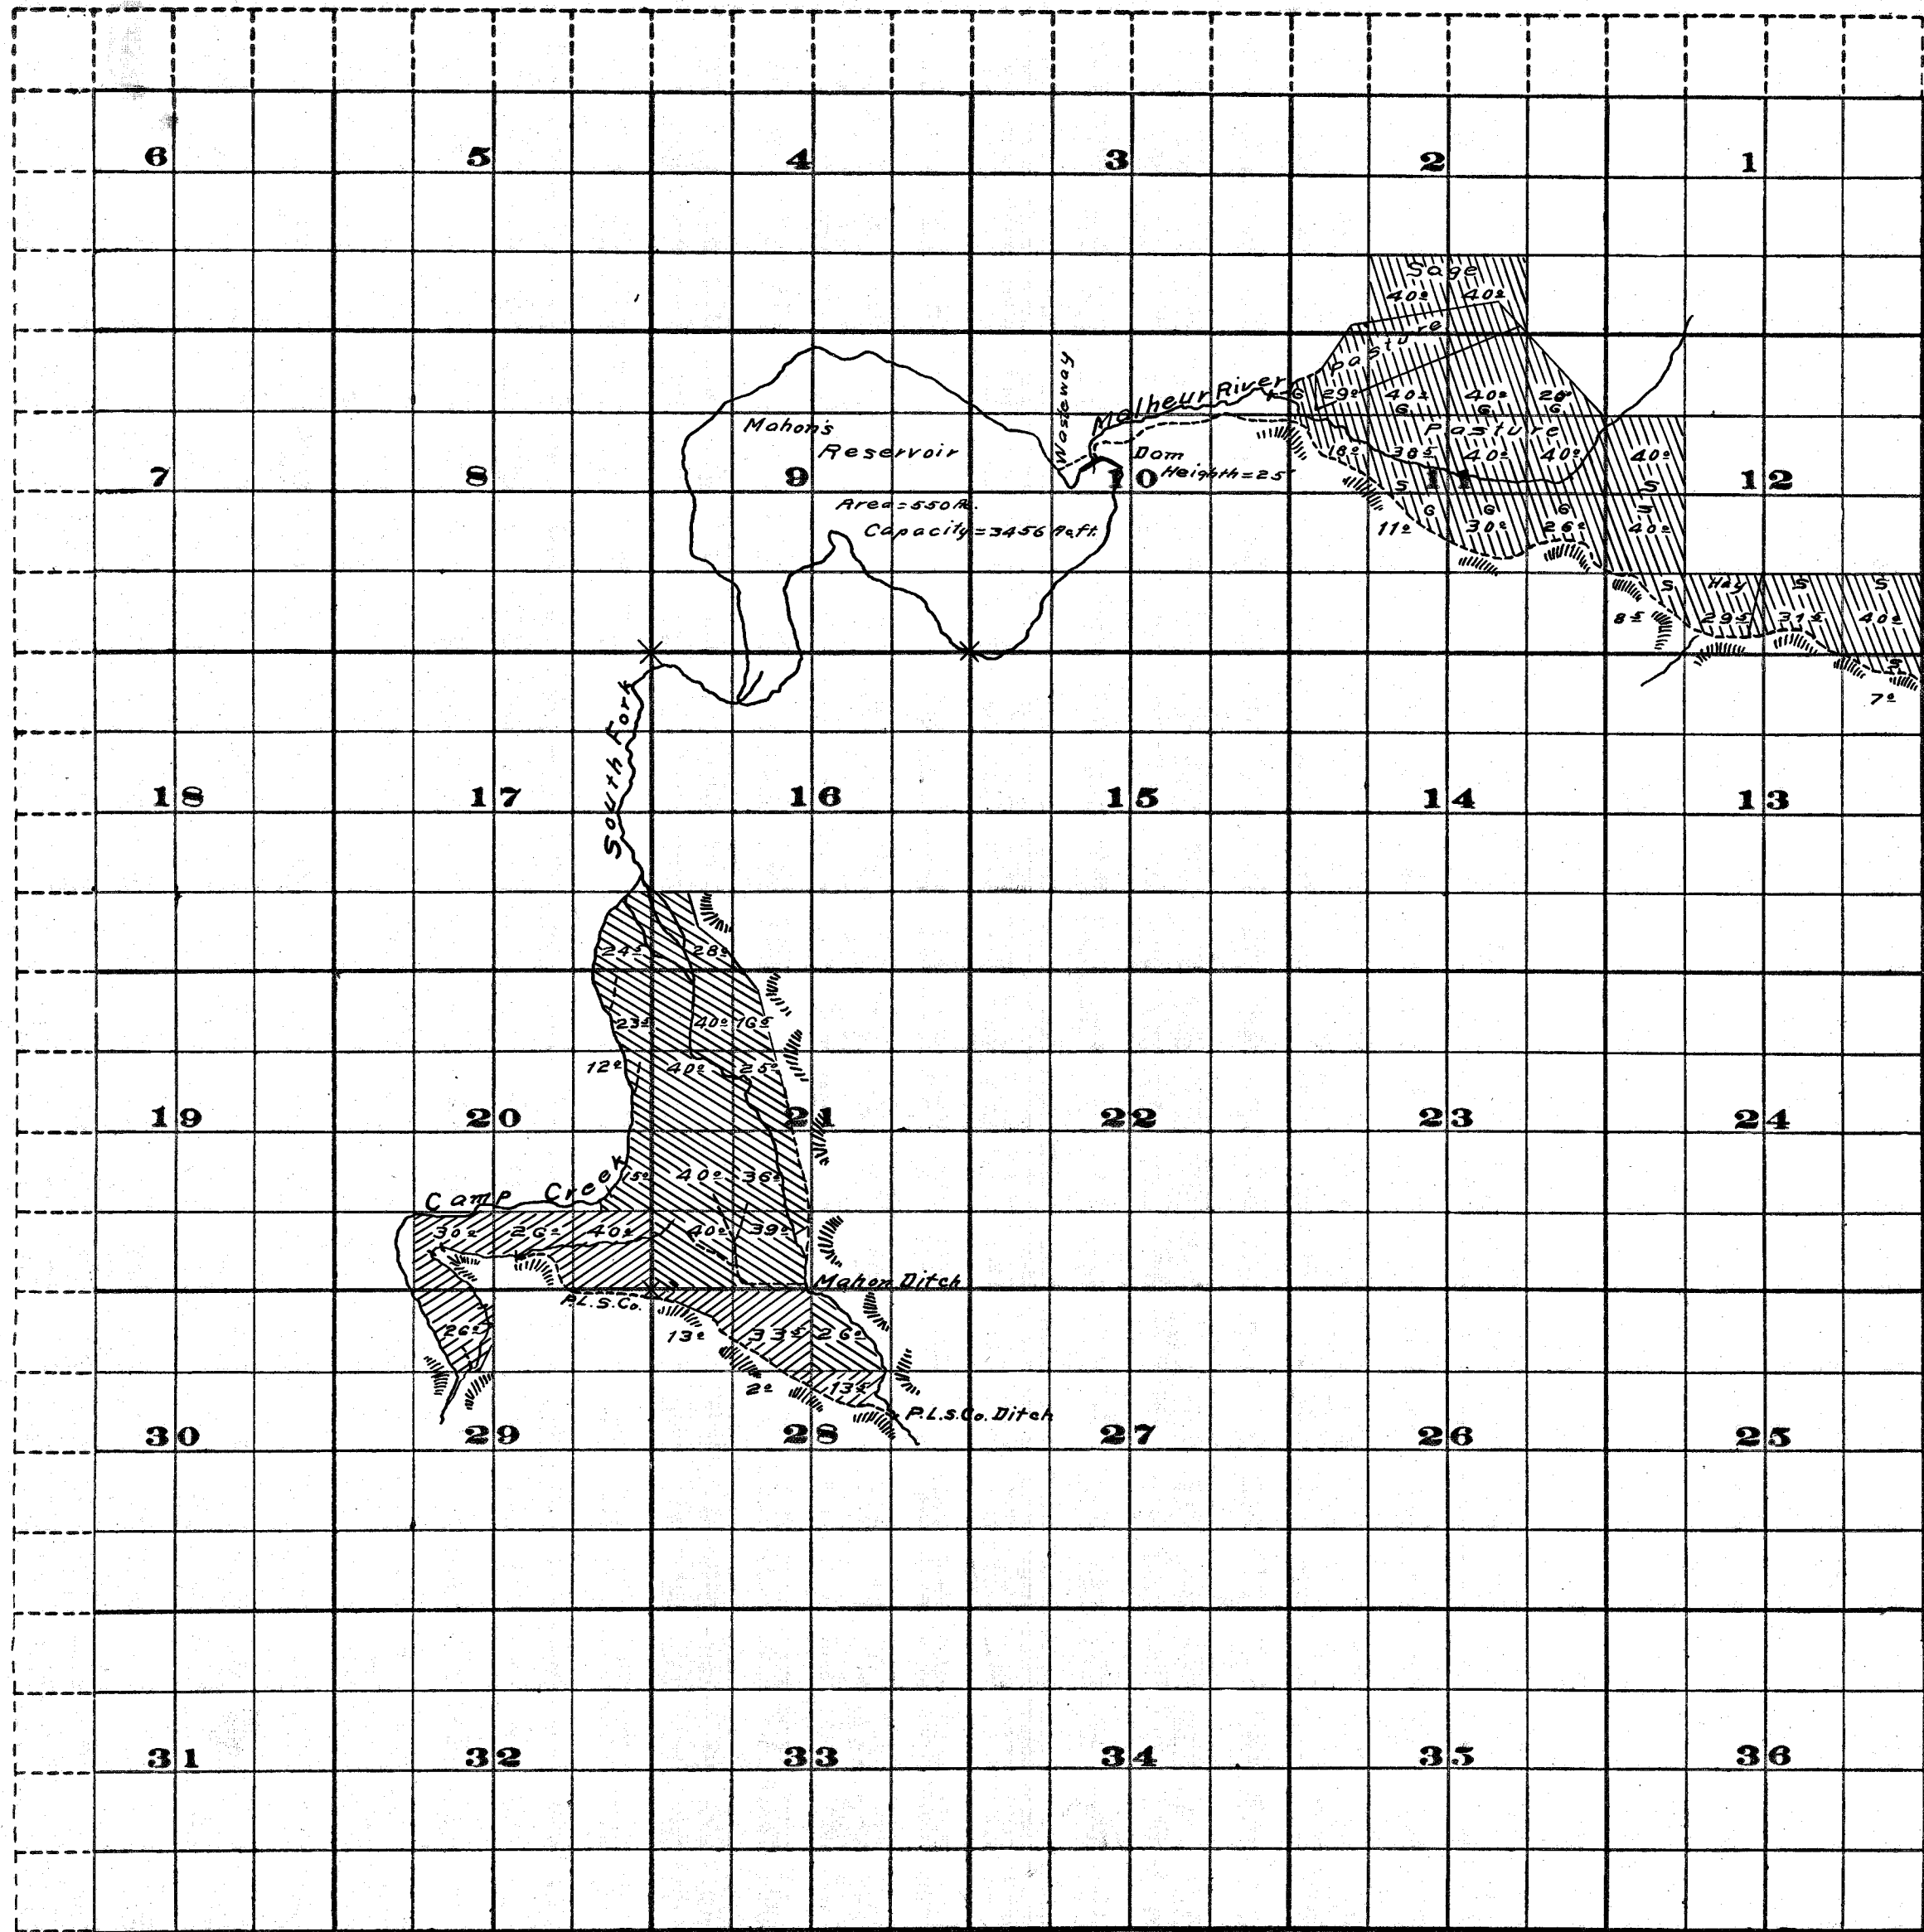





FROM OFFICE OF THE STATE ENGINEER, MALEM, OREGON

Scale of Feet

Surveyed Sept. 1913.



Adjudication Survey

— Legend —

-  Streams
-  Ditches
-  Corners Located
-  Irrigated Area
- S = Sage ; G = Grain

Malheur River
and
Tributaries

Township 28 South, Range 36 E.W.M.

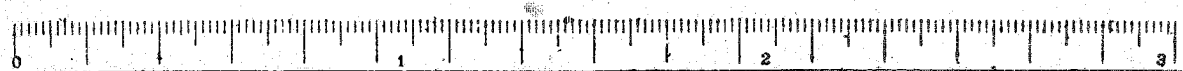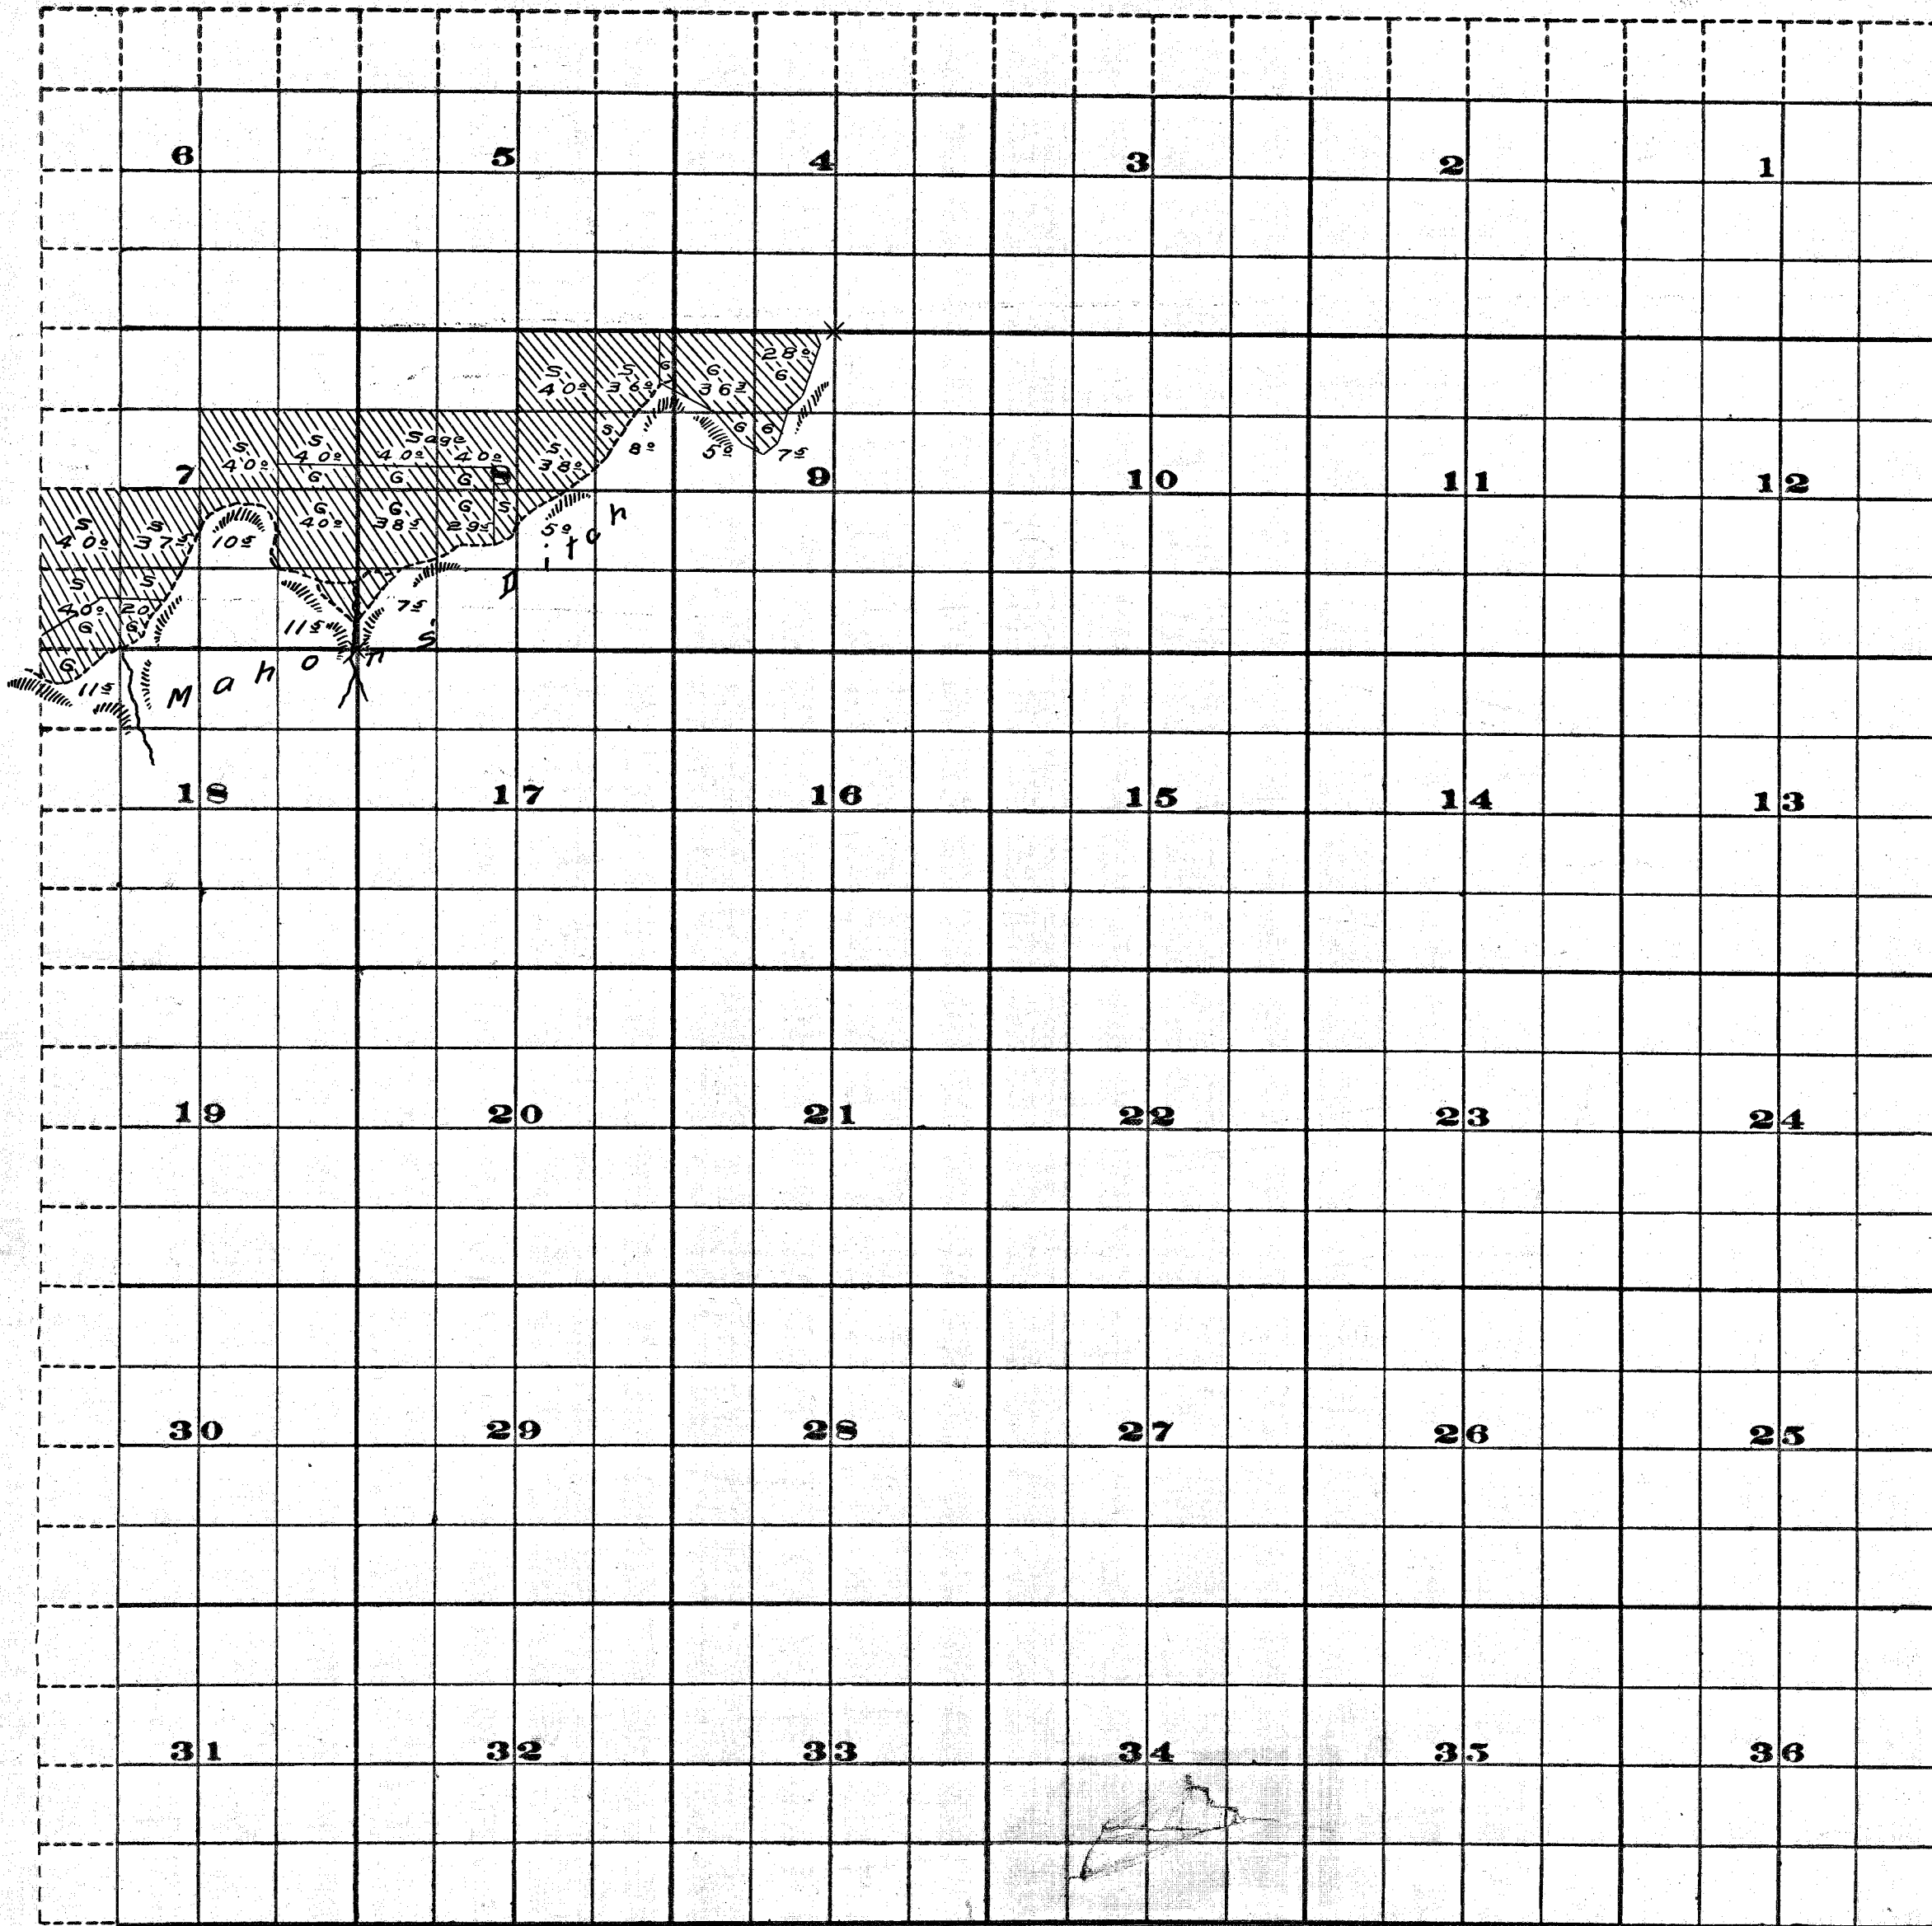

Scale of Feet. Surveyed Sept. 1913.

- Legend**
- S = Sage
 - G = Grain
 - Irrigated Area
 - Corners Located
 - Ditches

FROM OFFICE OF THE STATE ENGINEER, MALEM, OREGON

Adjudication Survey
Malheur River
and
Tributaries