


Township 25 South, Range 34 E.W.M.

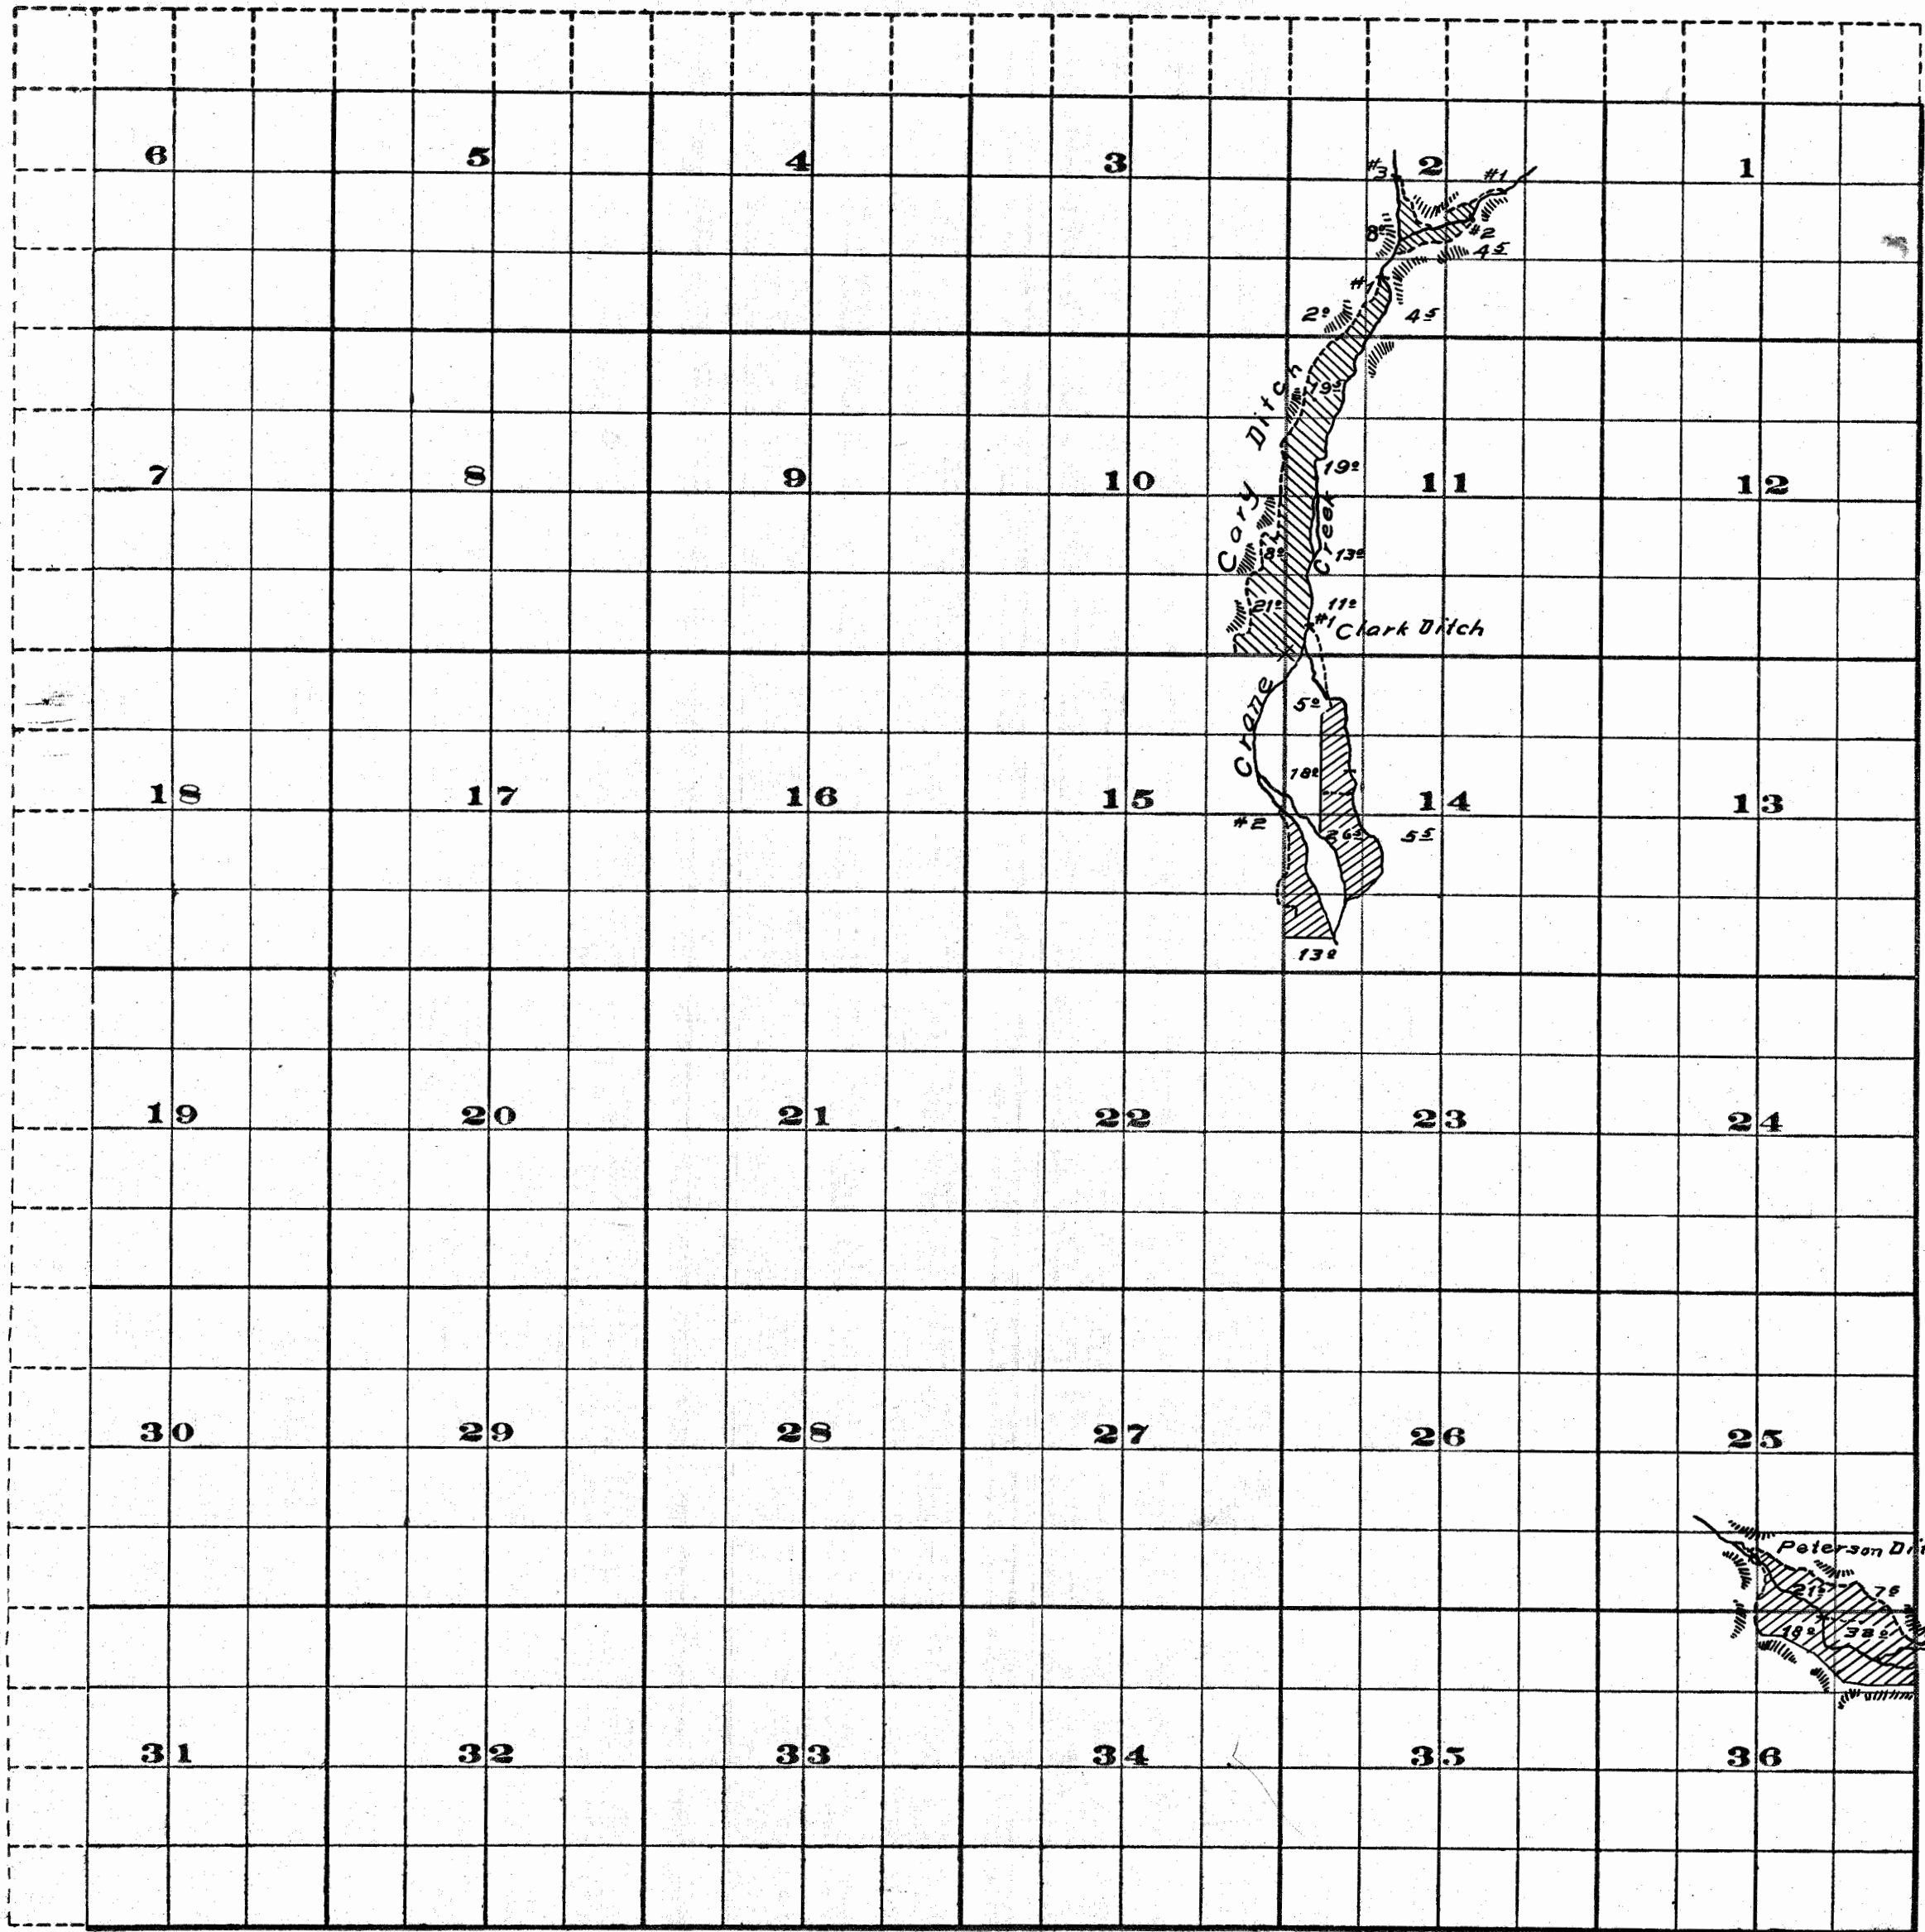

Scale of Feet

Surveyed Sept. 1913.

FROM OFFICE OF THE STATE ENGINEER, MALEM, OREGON

Adjudication Survey

Malheur River
and
Tributaries

- Legend —
- Streams
 - Ditches
 - Corners Located
 - Irrigated Area